






Profile. No  
Longitudinal Sect - Tank Top  
+ Butt Plan

156

S. Crabangau  
Clew. 64

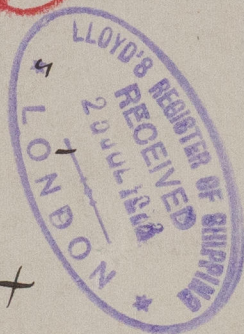

© 2020

Lloyd's Register  
Foundation

W908-0115