
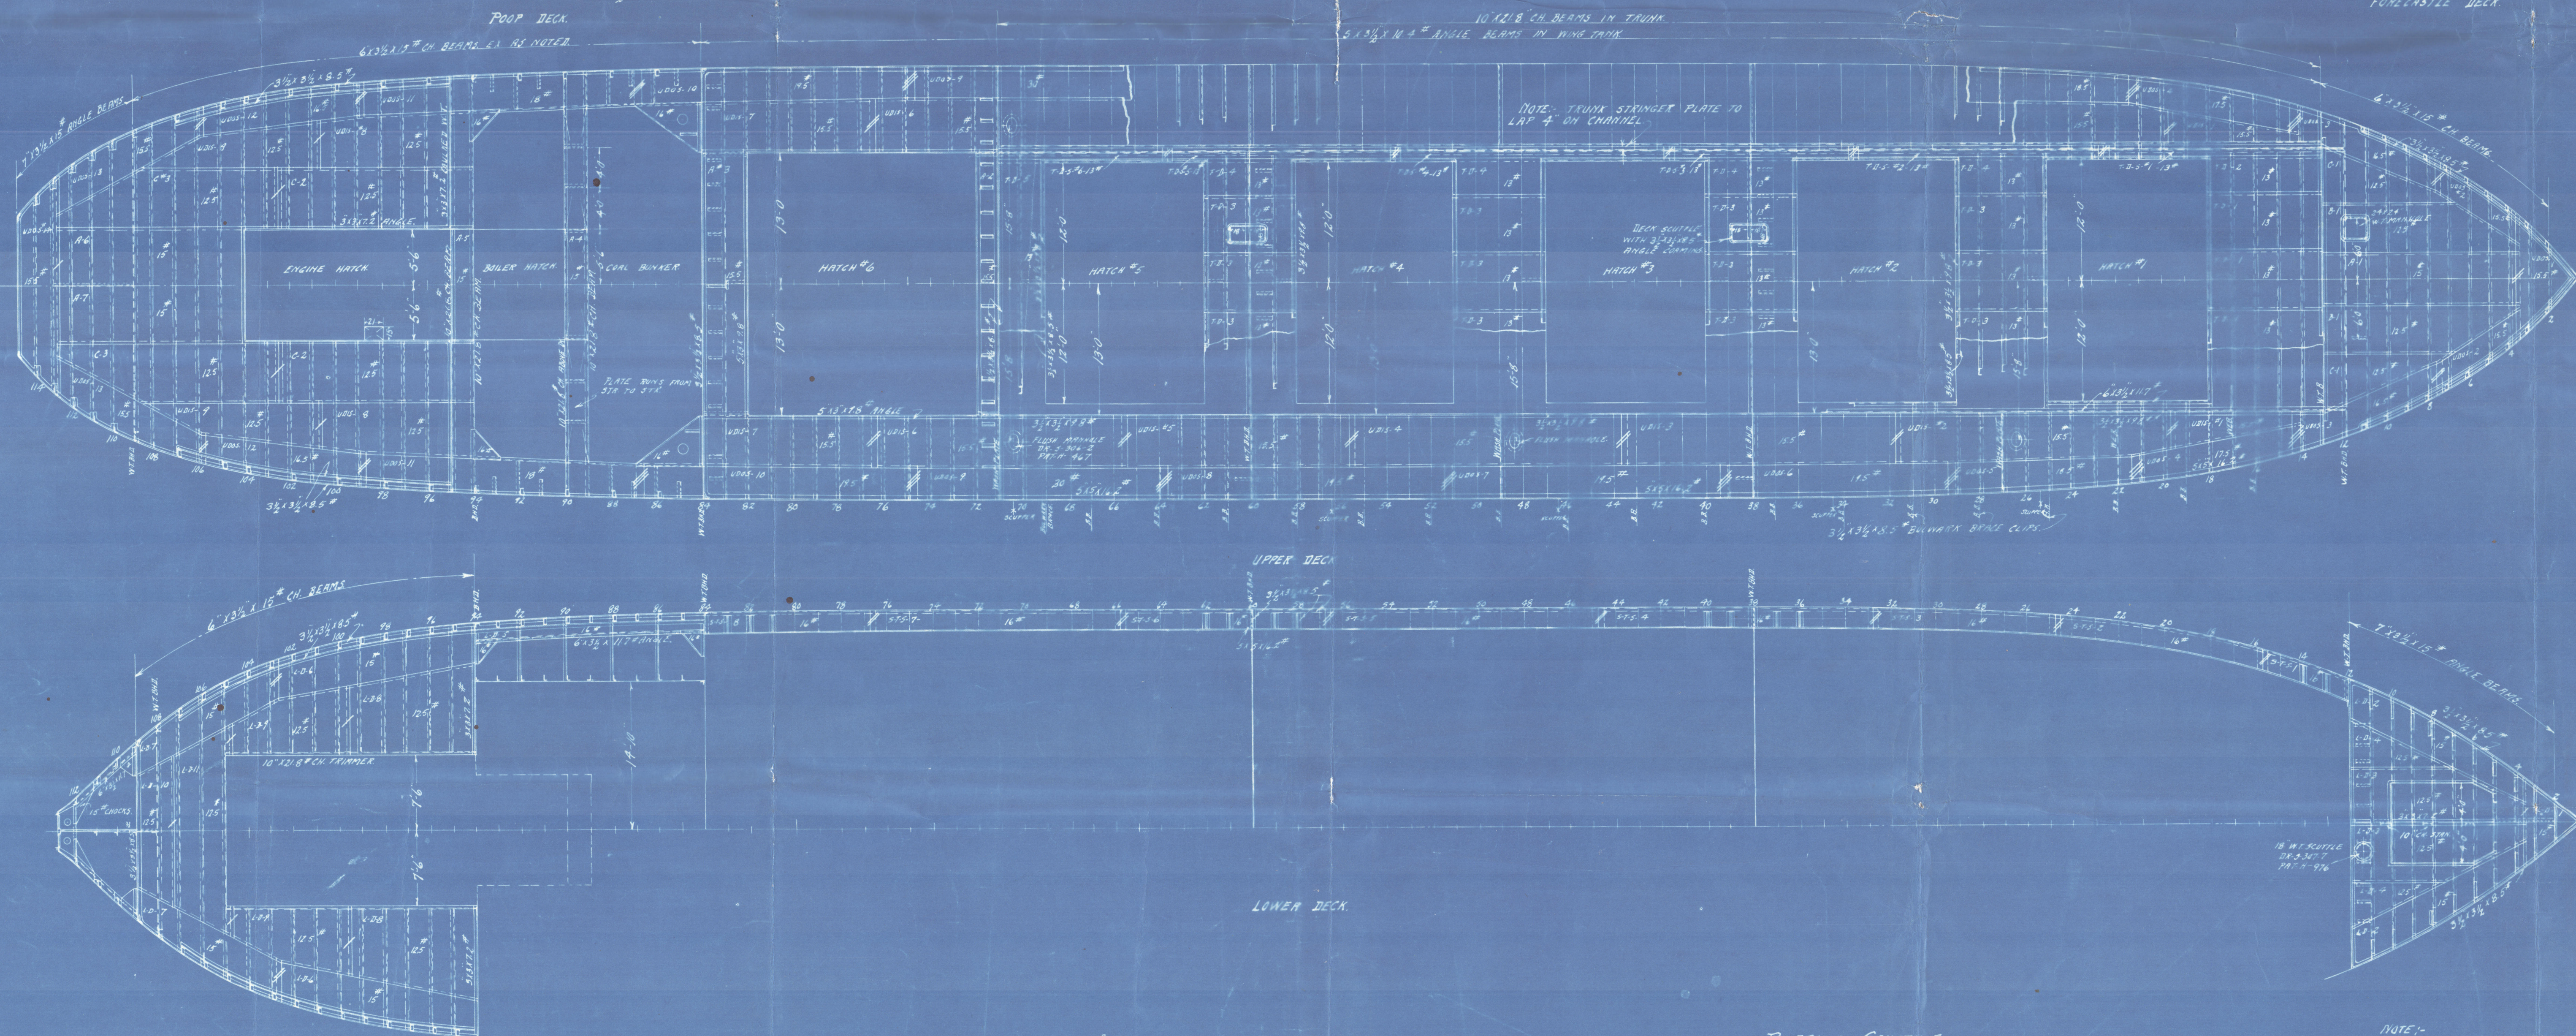


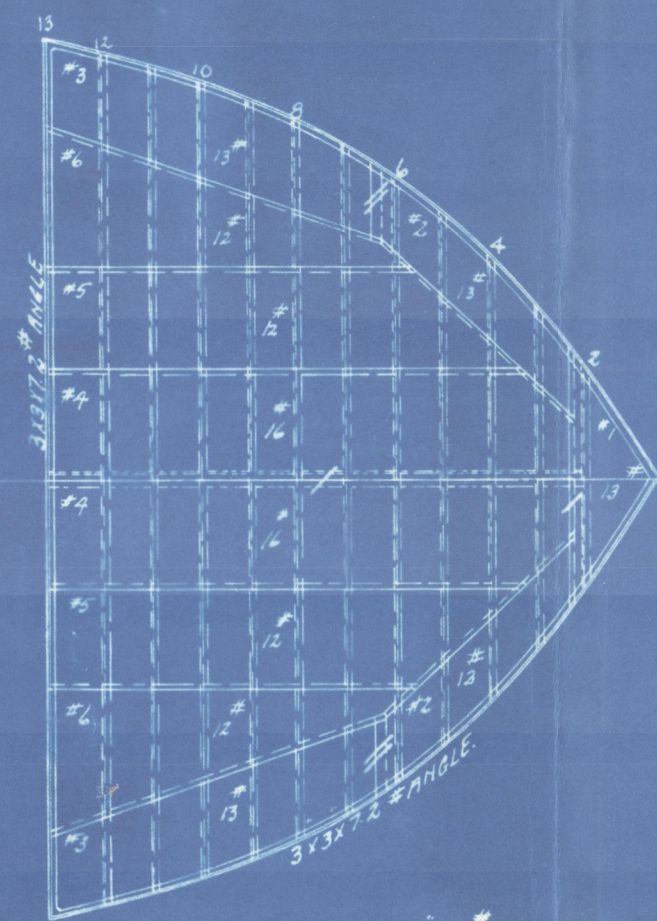

DATE	ALTERATIONS AND ADDITIONS
10-13	NOTE: TRUNK STRINGER PLATE TO LAP 4" ON CHANNEL.
10-14	UPPER DECK BEAMS TO 12" x 12" CHANNELS 57-70 74-75.
10-15	6" x 3" x 1/2" PLATE ANGLE ON LOWER A STR. AT COAL BUNKER TIES INBOARD.
10-16	TRUNK DECK HATCH BULKHEAD TO 12" x 12" CHANNEL AND 1/2" x 1/2" x 1/2" BUTTS IN MID-DECK.
10-17	OPENINGS IN POOP DECK.
10-18	CLIPS ON POOP AND UPPER DECKS AT POOP AND.

ITEM	RIV.	MAX. SPACING
OUTER STRINGER BUTTS	3/4"	3 1/2"
OTHER BUTTS	3/4"	3 1/2"
LONG LAPS	3/4"	3 1/2"
GUNWALE BAR	3/4"	3 1/2"
PLATING TO BEAMS	3/4"	3 1/2"
ANGLE CONNECTING STRINGER TO SHELL	3/4"	3 1/2"
WING TRUNK STRINGER BUTTS	3/4"	3 1/2"
" " " " " "	3/4"	3 1/2"
ANGLE BETWEEN INNER STR. AND TRUNK PLATE	3/4"	3 1/2"

TESTING.
LOWER A IN FORE PEAK TO BE TESTED WITH A HEAD 250" ABOVE LOWER A.
WING TRUNK TO BE TESTED WITH A HEAD 250" ABOVE LOWER A.
UPPER A IN AFTER PEAK TO BE TESTED WITH A HEAD 250" ABOVE UPPER A.

Copy Approved.
Wm. McCallum
LLOYD'S REGISTER OF SHIPPING
NOV 9 1915
NEW YORK

HULL No 156
DECK PLANS
Great Lakes Engineering Works.
DETROIT, MICH.
HULL DEPT.
NOV 9 1915
NEW YORK
LLOYD'S REGISTER OF SHIPPING
NOV 9 1915
NEW YORK

8110-80

RETAIN

GREAT LAKES ENGINEERING
WORKS
NOV 2



© 2020

Lloyd's Register
Foundation

LL04105



© 2020

Lloyd's Register
Foundation

Deck plans
156

^u 8/5 Gratangen.
^u Clw. 64.



© 2020

Lloyd's Register
Foundation