



4.3.02

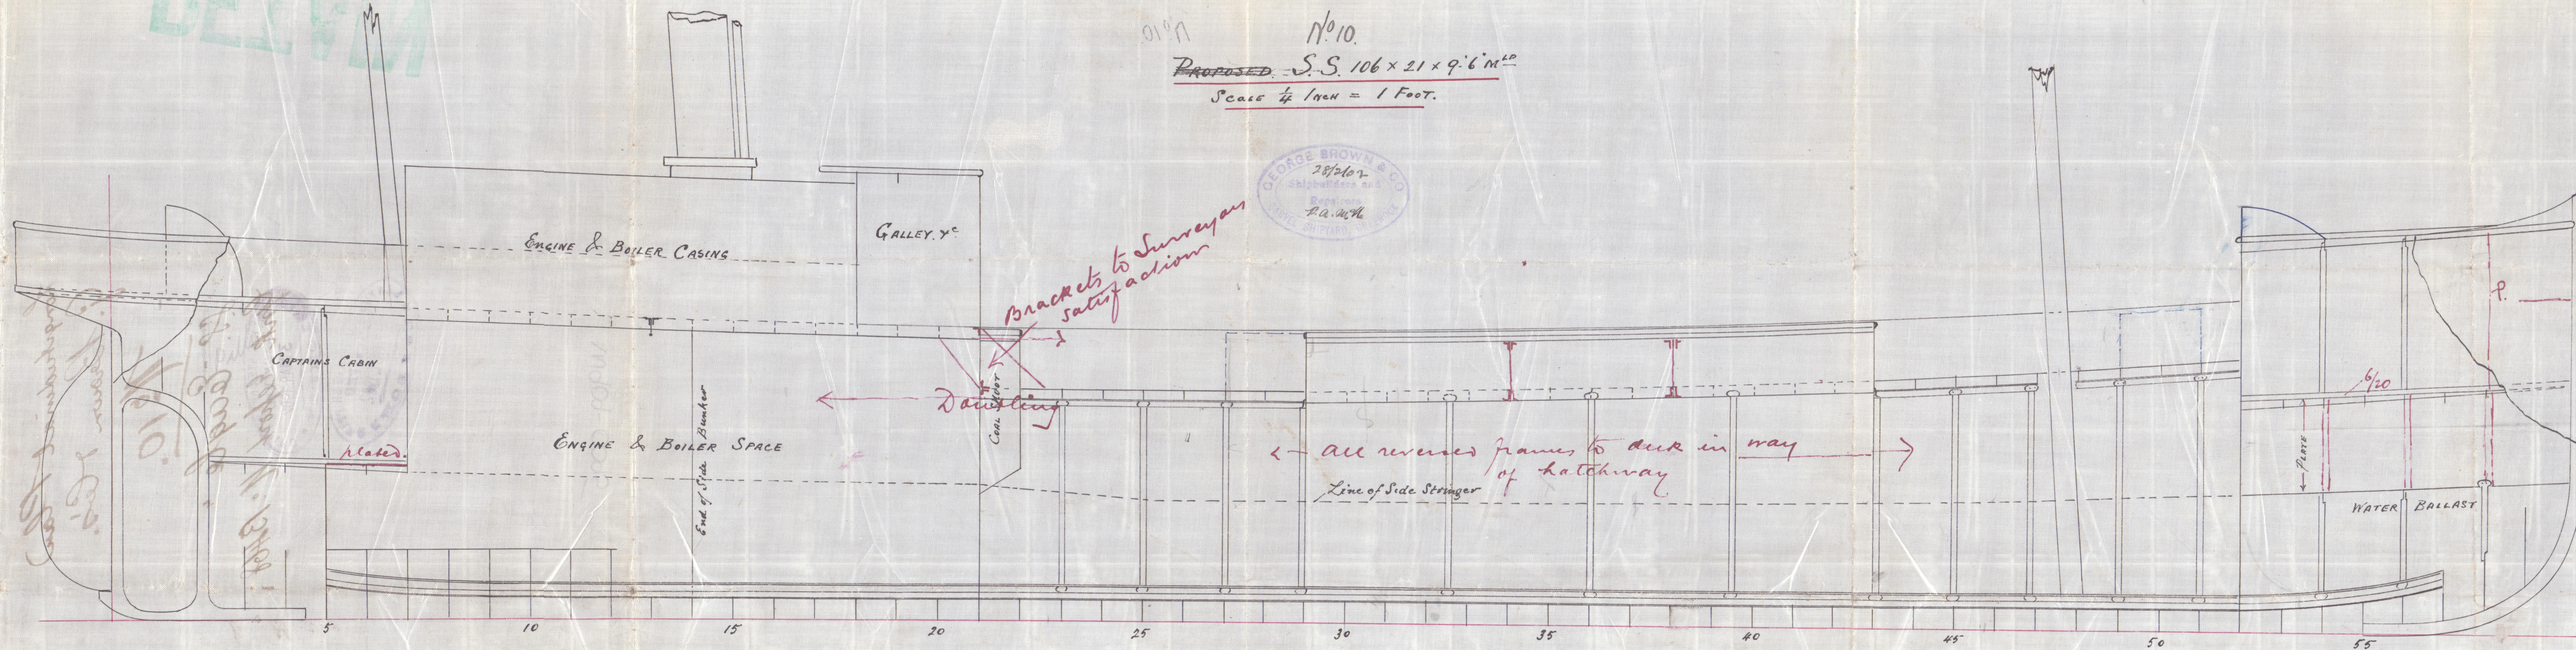

01/11

Nº 10.

PROPOSED S.S. 106 x 21 x 9'6" m¹⁰
Scale 1/4" = 1 Foot.

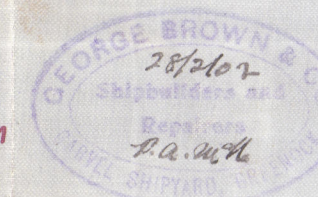



C.B.
 4.3.02.

Longitudinal Plan
G. Brown & Co's.

No 10.

S.S. Eagle

Cnrk Report No: B468

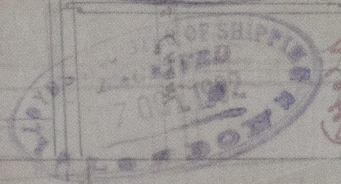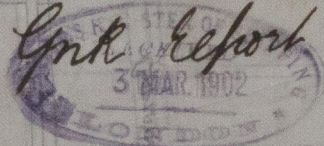

© 2020

Lloyd's Register
Foundation

W909-0095

ENGINE & B