

Office

"TERJE VIKEN"


SKETCH SHOWING ADDITIONS IN N° 2 CARGO

HOLD TO CONVERT SAME INTO

OIL FUEL BUNKER

FLASH POINT OF OIL ABOVE 150°F

THE FLASH POINT OF THE OIL FUEL TO BE
CARRIED SHOULD BE NOT LOWER THAN
150°F AND THE REQUIREMENTS OF SECTION 20
OF THE RULES SHOULD BE COMPLIED WITH.

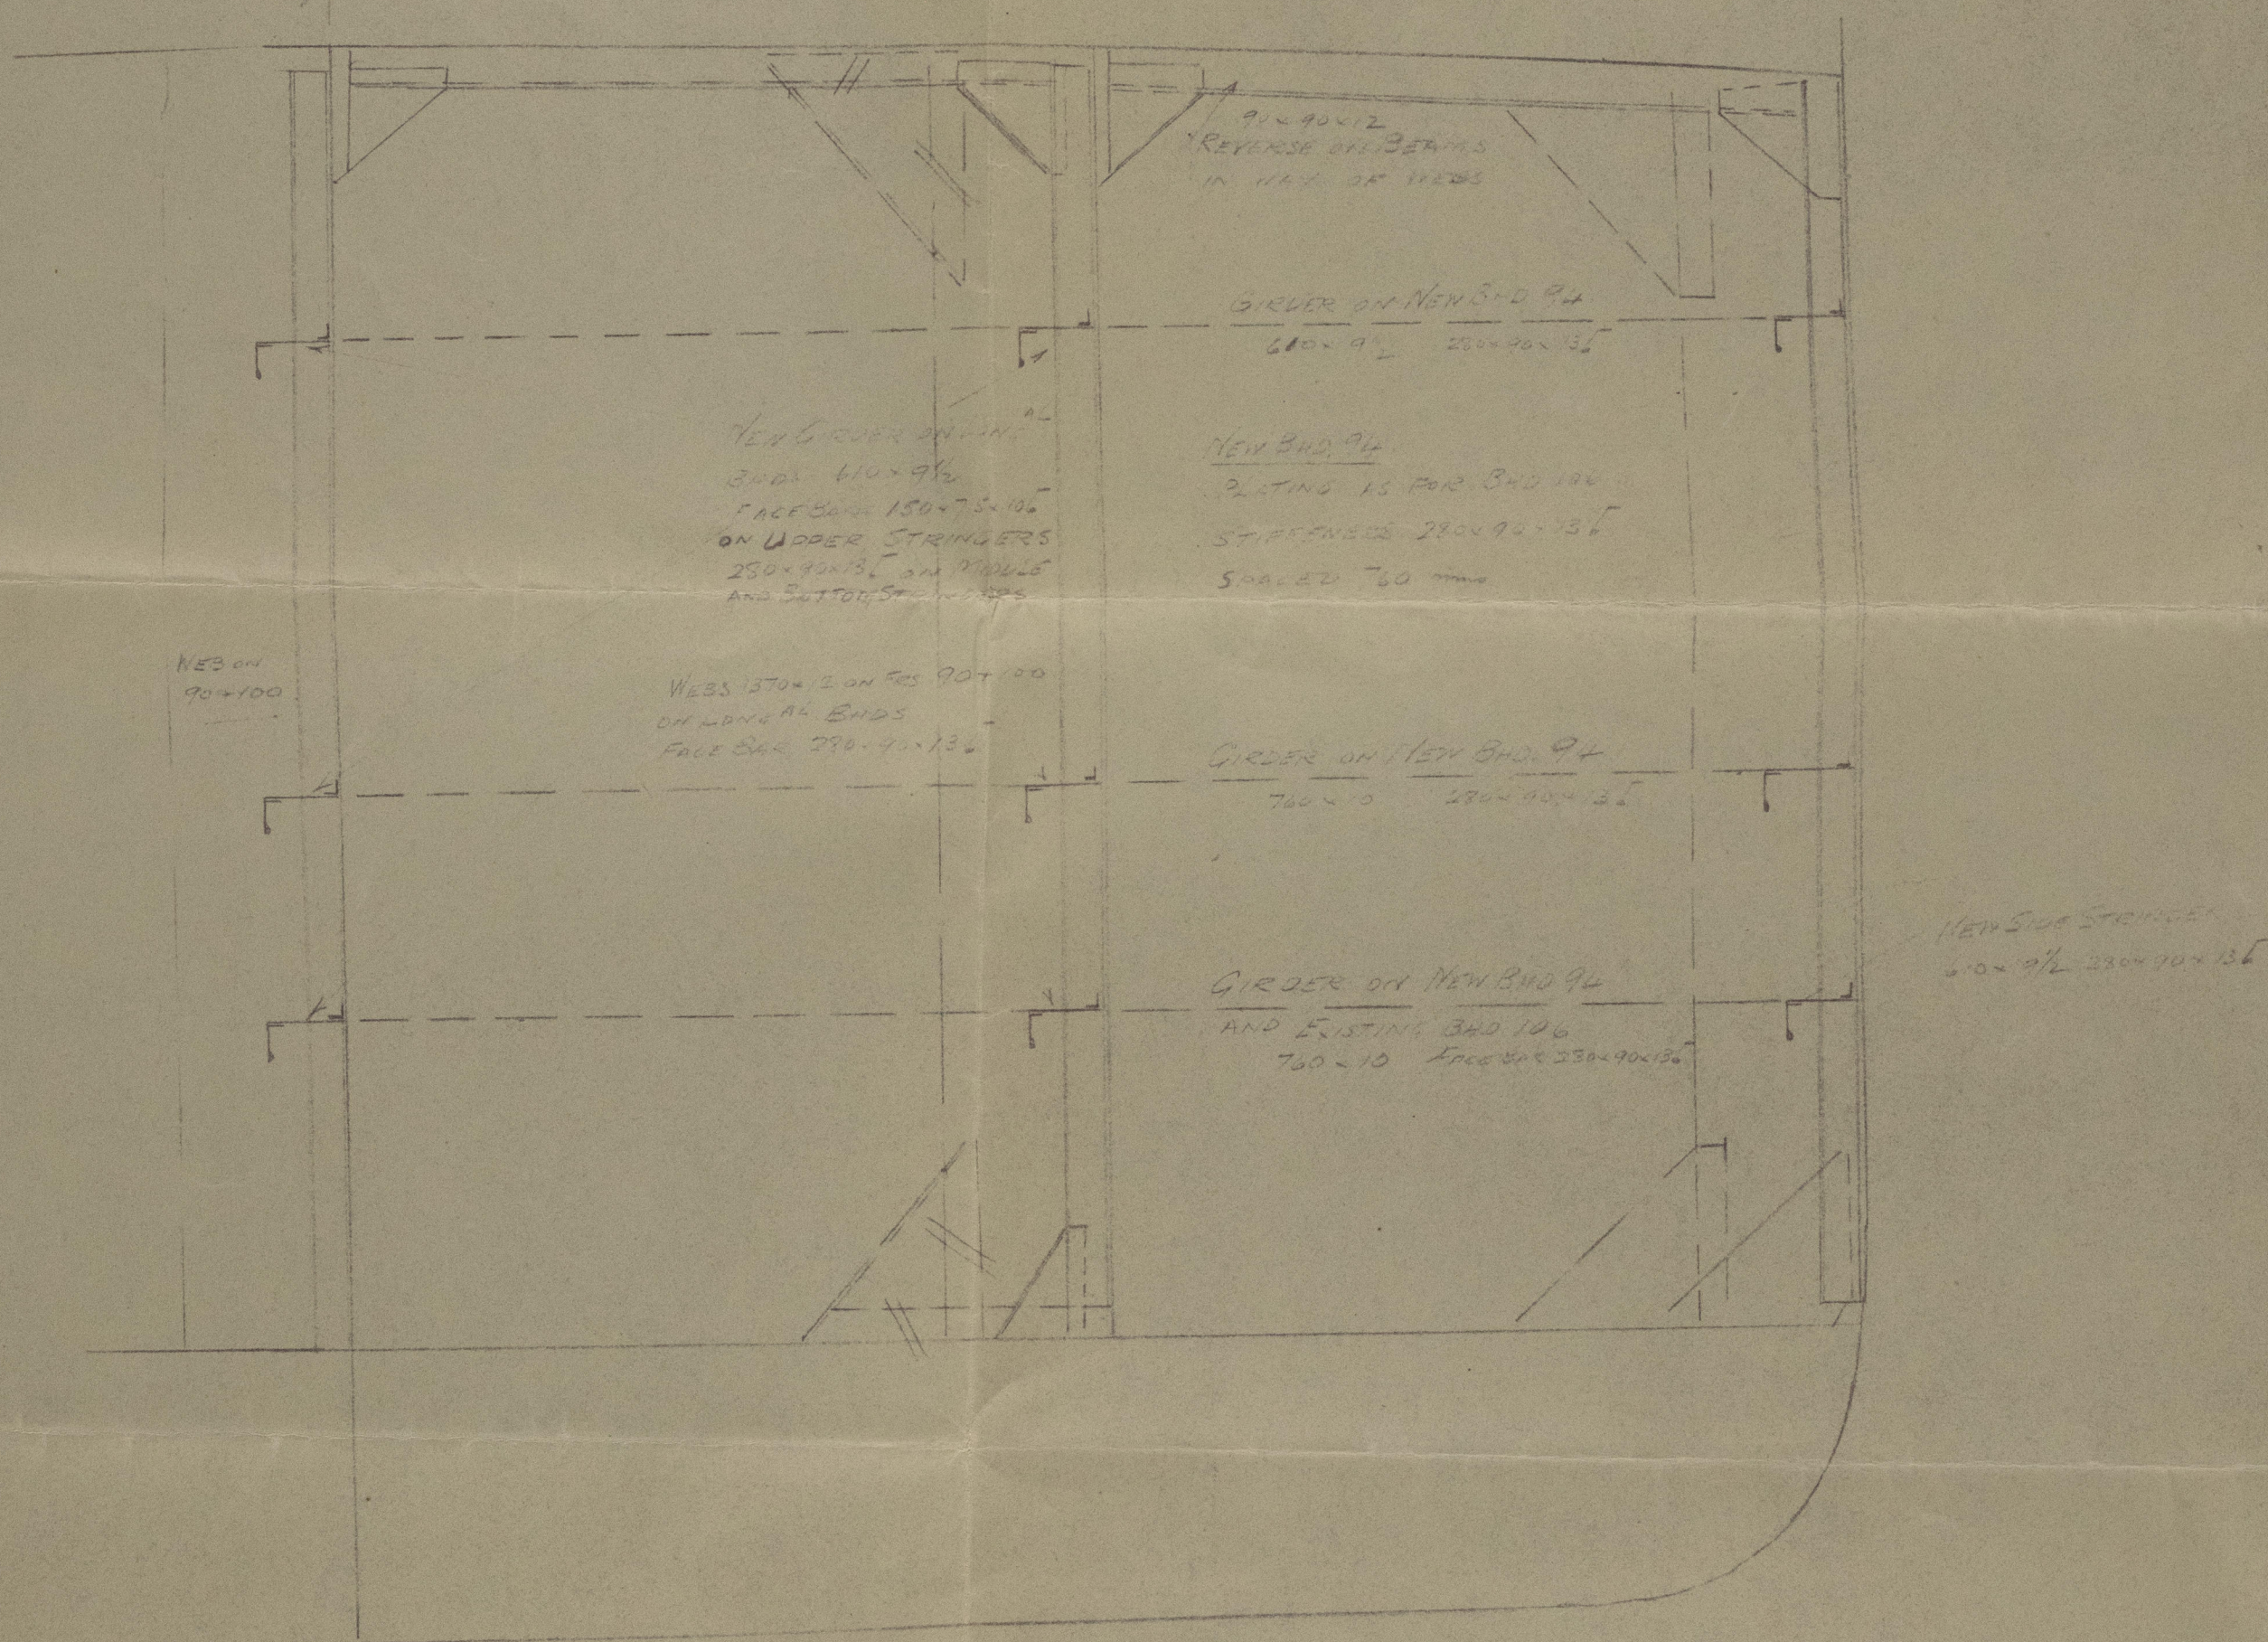

W.J.

© 15.6.37

Lloyd's Register
Foundation