


Office

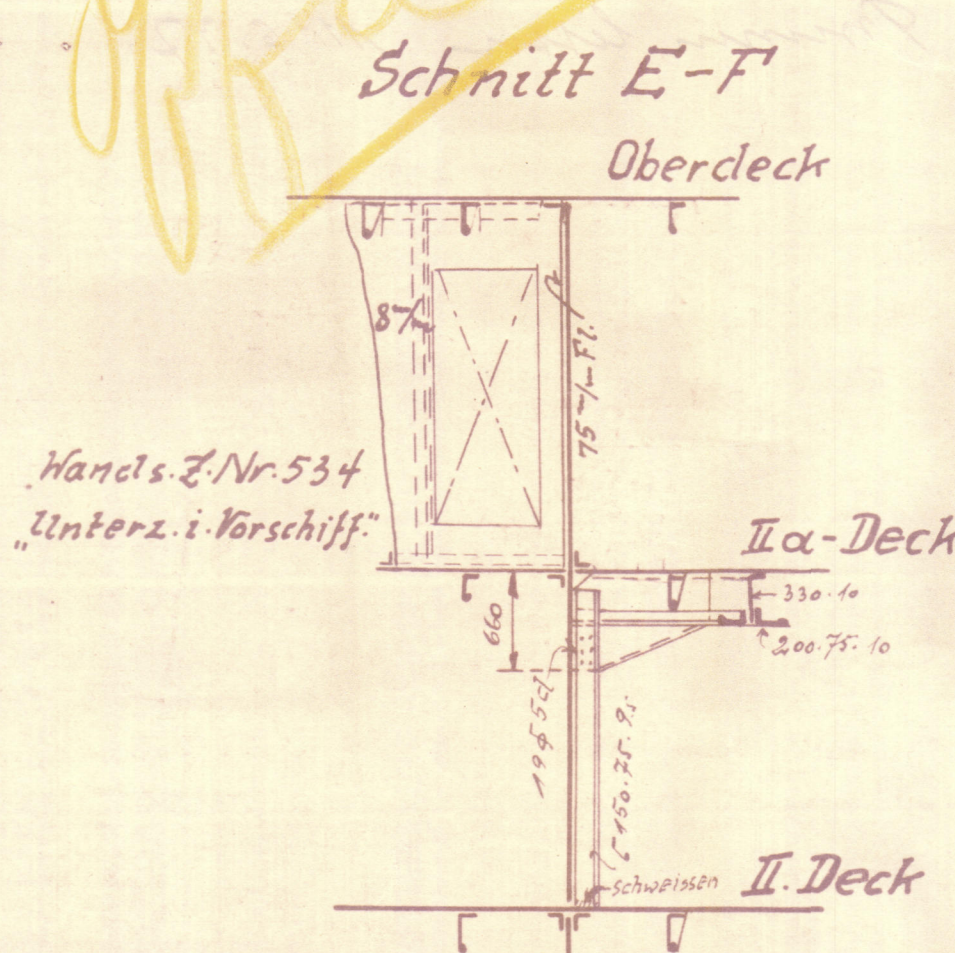


Handls. Z. Nr. 534
Unterz. i. Vorschiff

S. 914
Guerschott Spt. 106.
von hinten gesehen.


S. Vordere

Schnitt A-B.

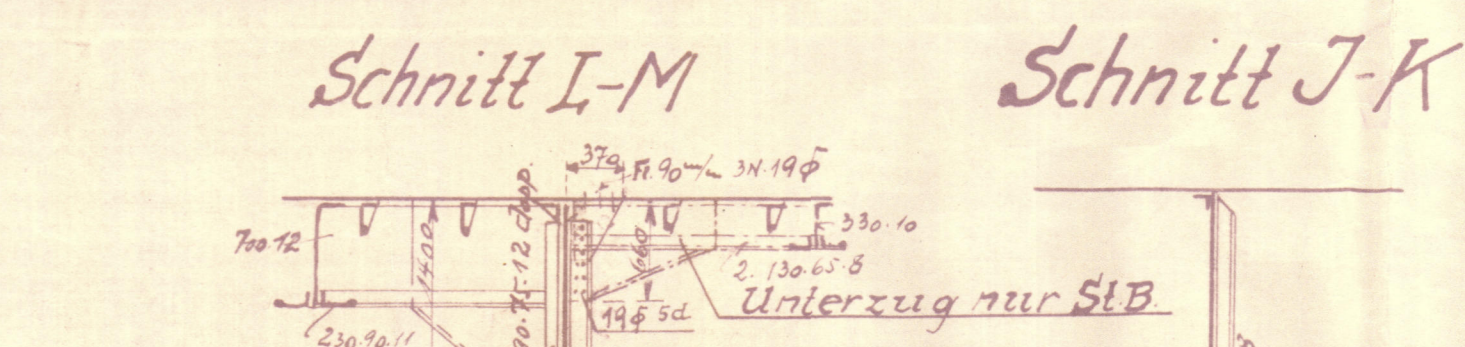



Unterzuges. Z. Nr. 534

Schnitt J-K

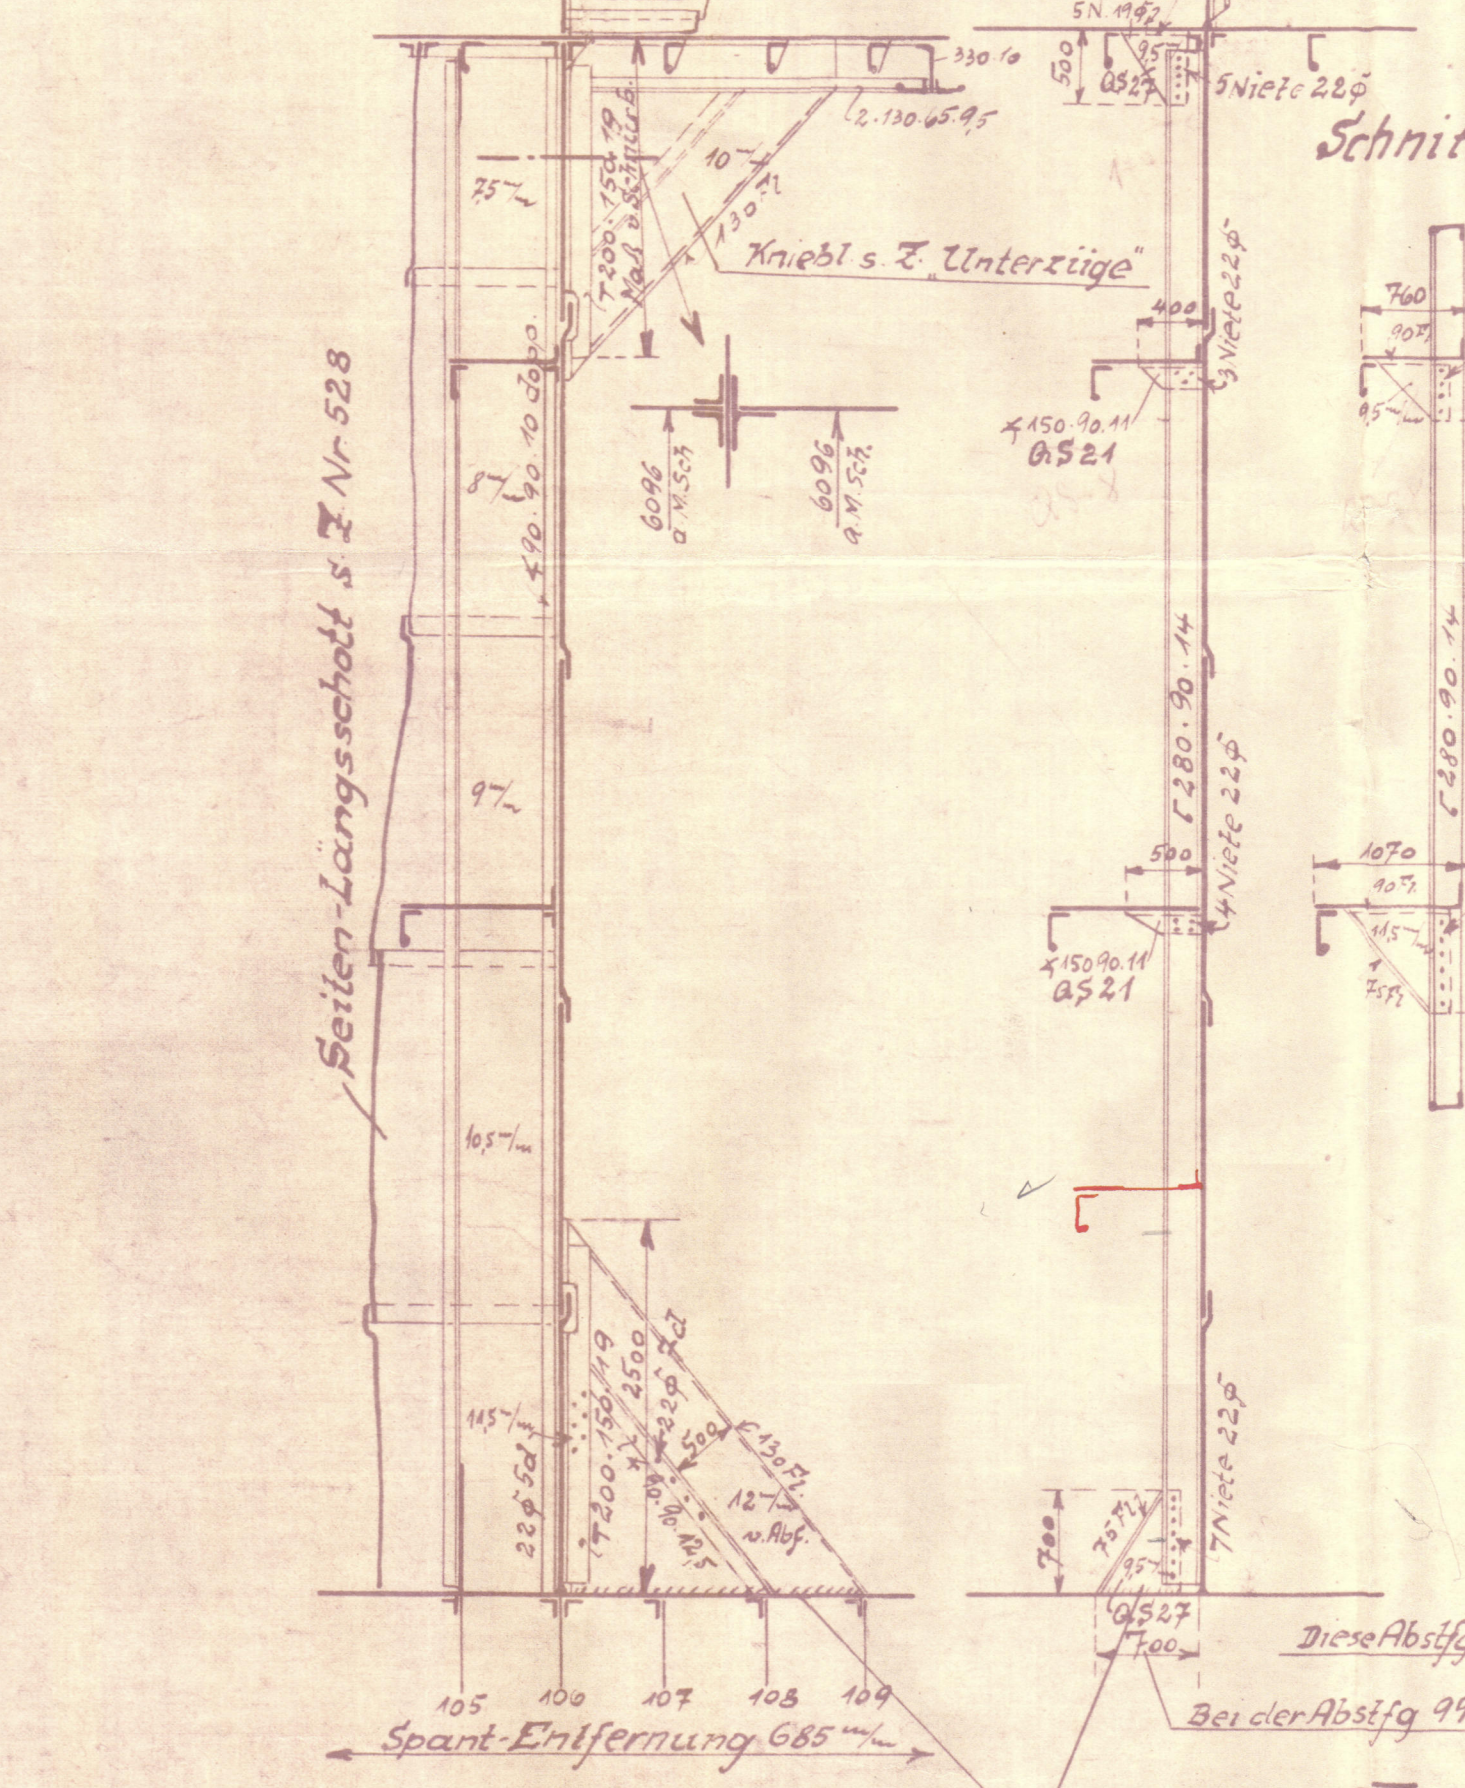

Seiten-Longschott s. Z. Nr. 528

Now OT. Bld 94
Plating as for Bld 106
Stiffeners 280 x 90 x 13.6 spaced 760 mm
Top Stringer 610 x 9.5
Midst Stringer 760 x 10
Bottom Stringer 760 x 10

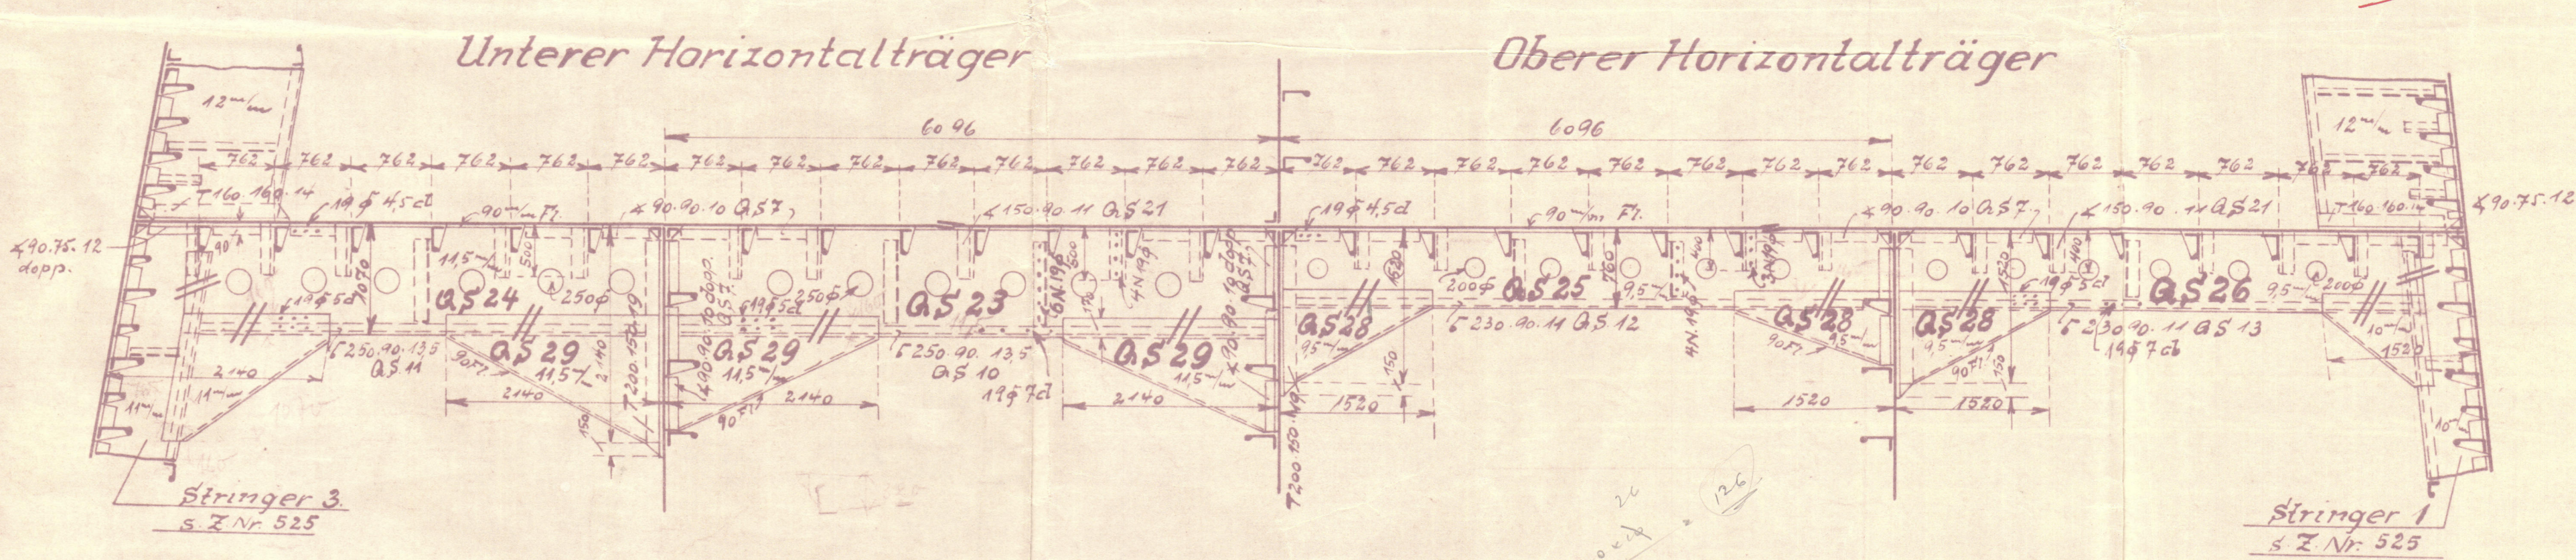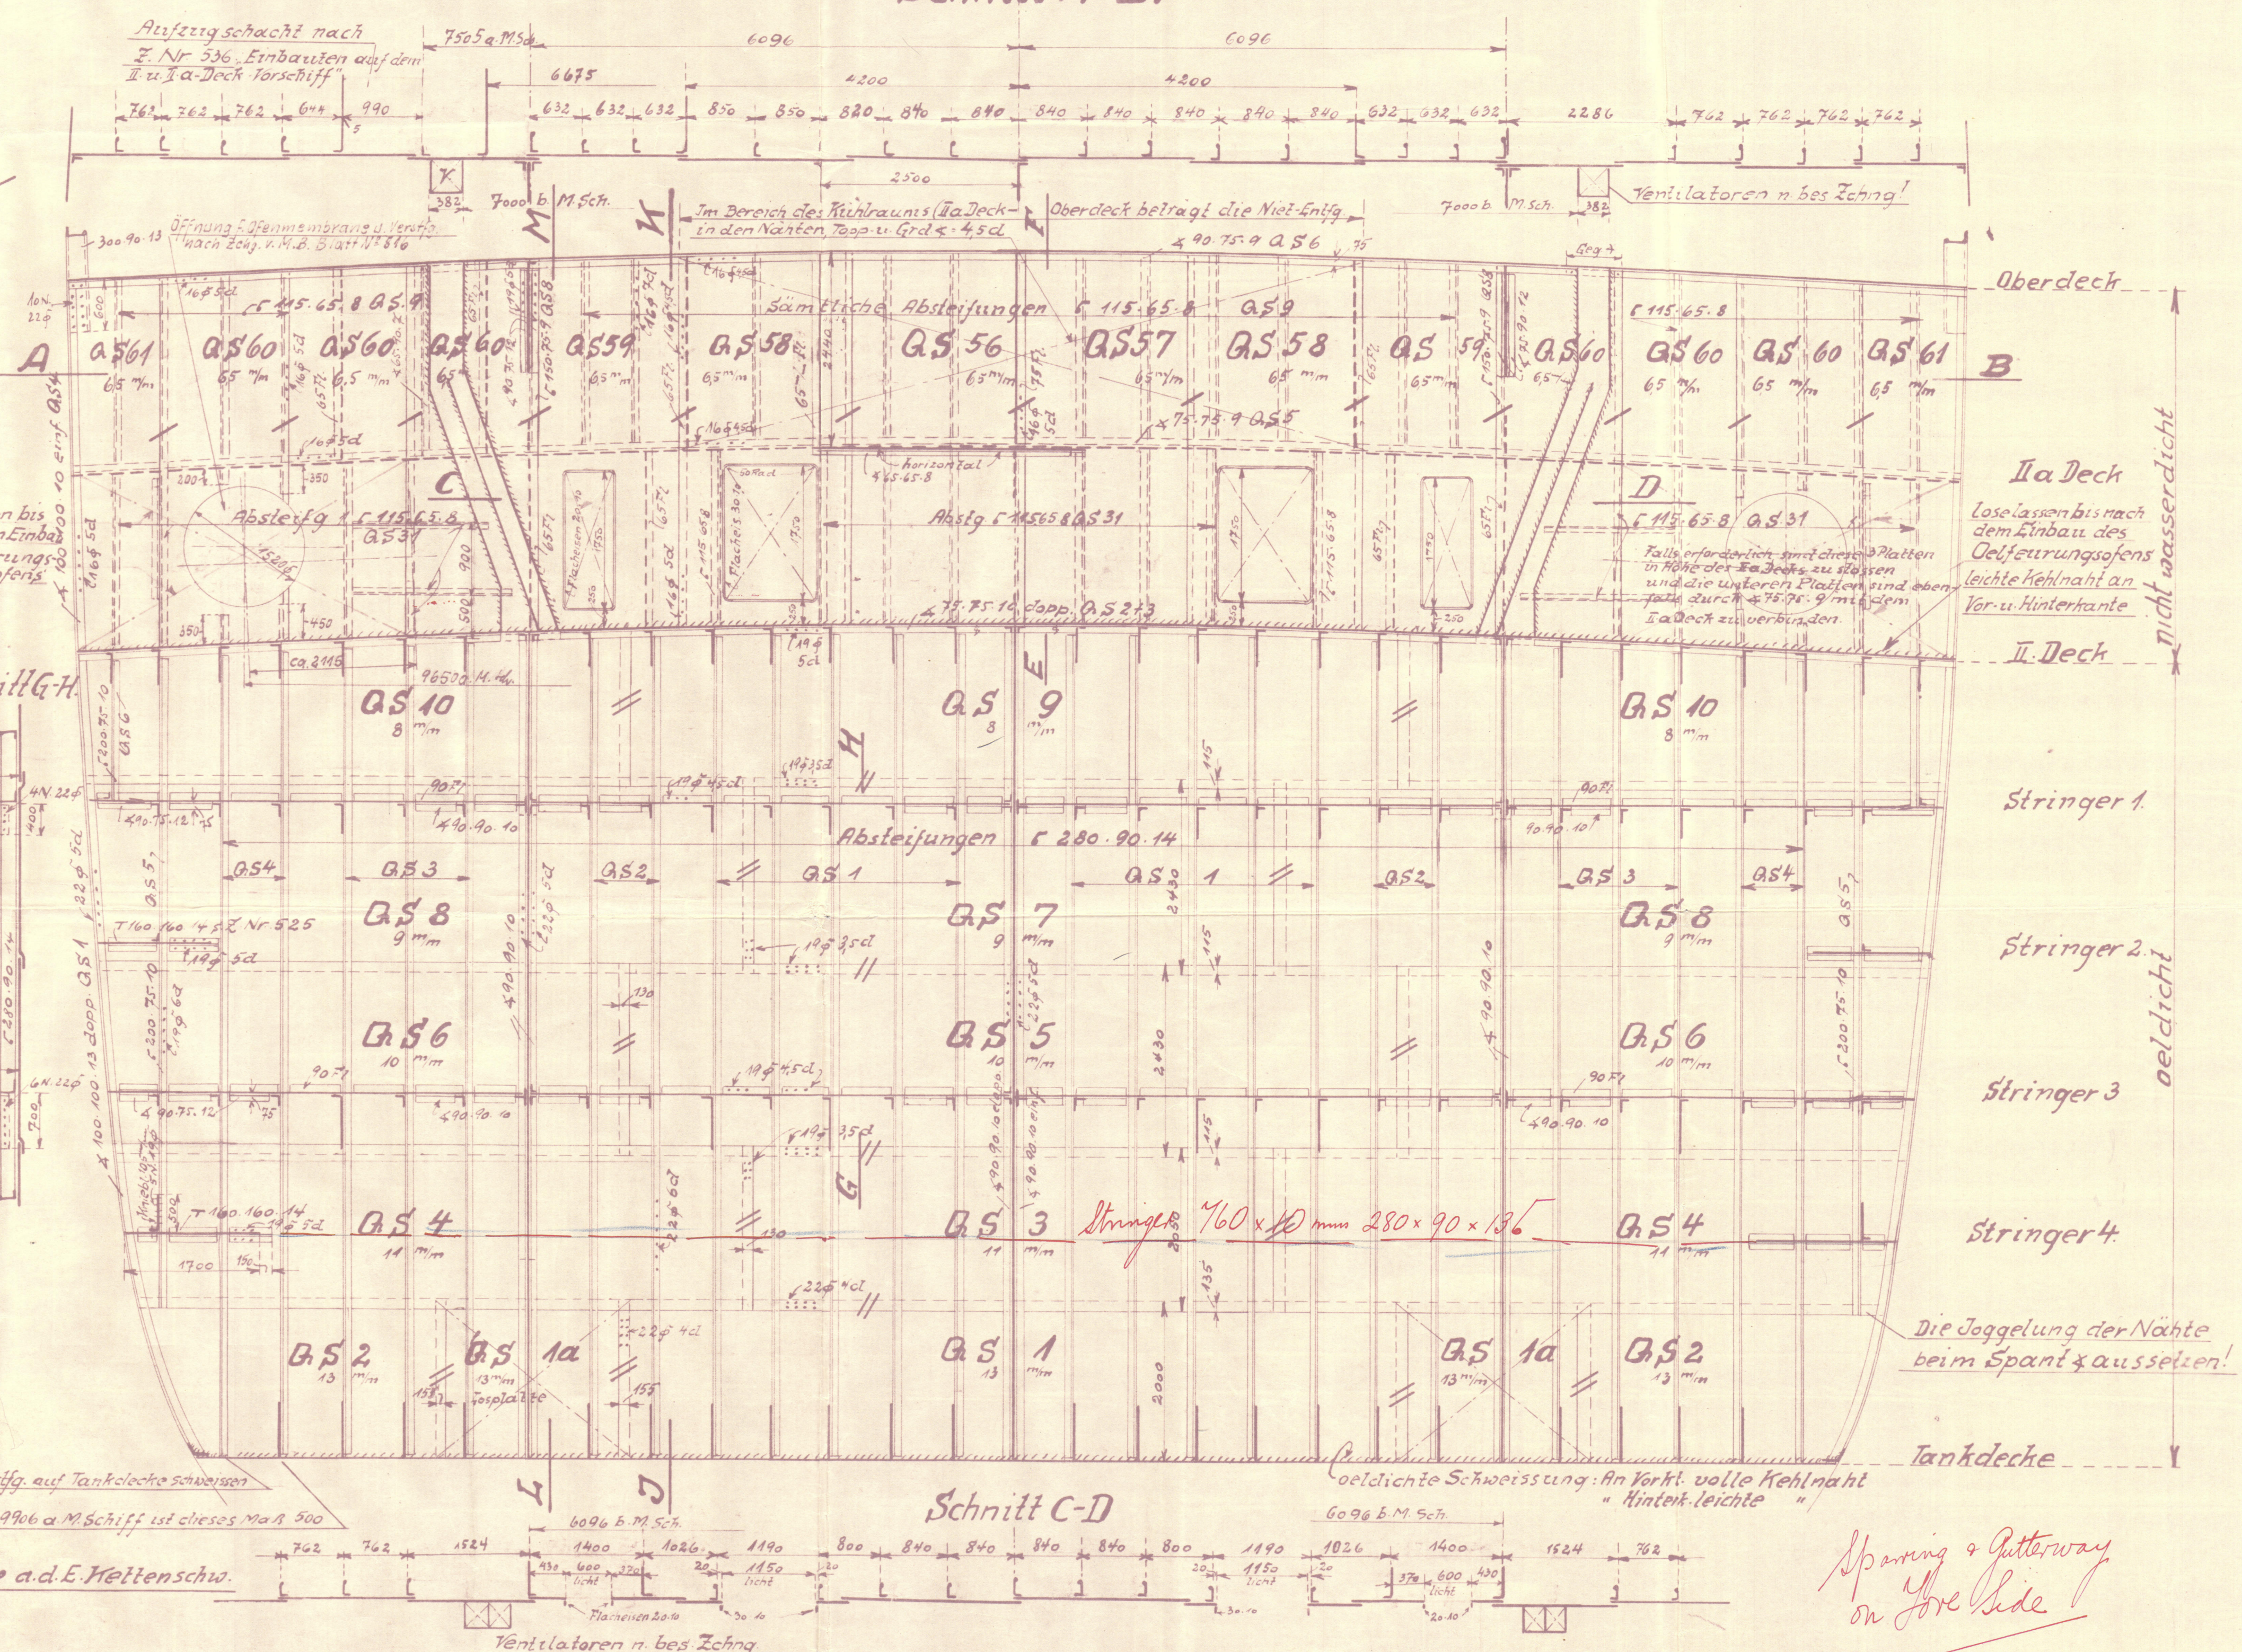

914
526
206/15
Tordere
Guerschotte
Dynn 13. VII. 35 M.

TERJE VIKEN

plan of bulkhead of frame 106

Primen lesen 11. 6. 77.

W91-0126



© 2020

Lloyd's Register
Foundation