



S. 914 Vordere Längsschotte.

M.1:50 u. 1:20

Handwritten notes and signatures in the top left corner.

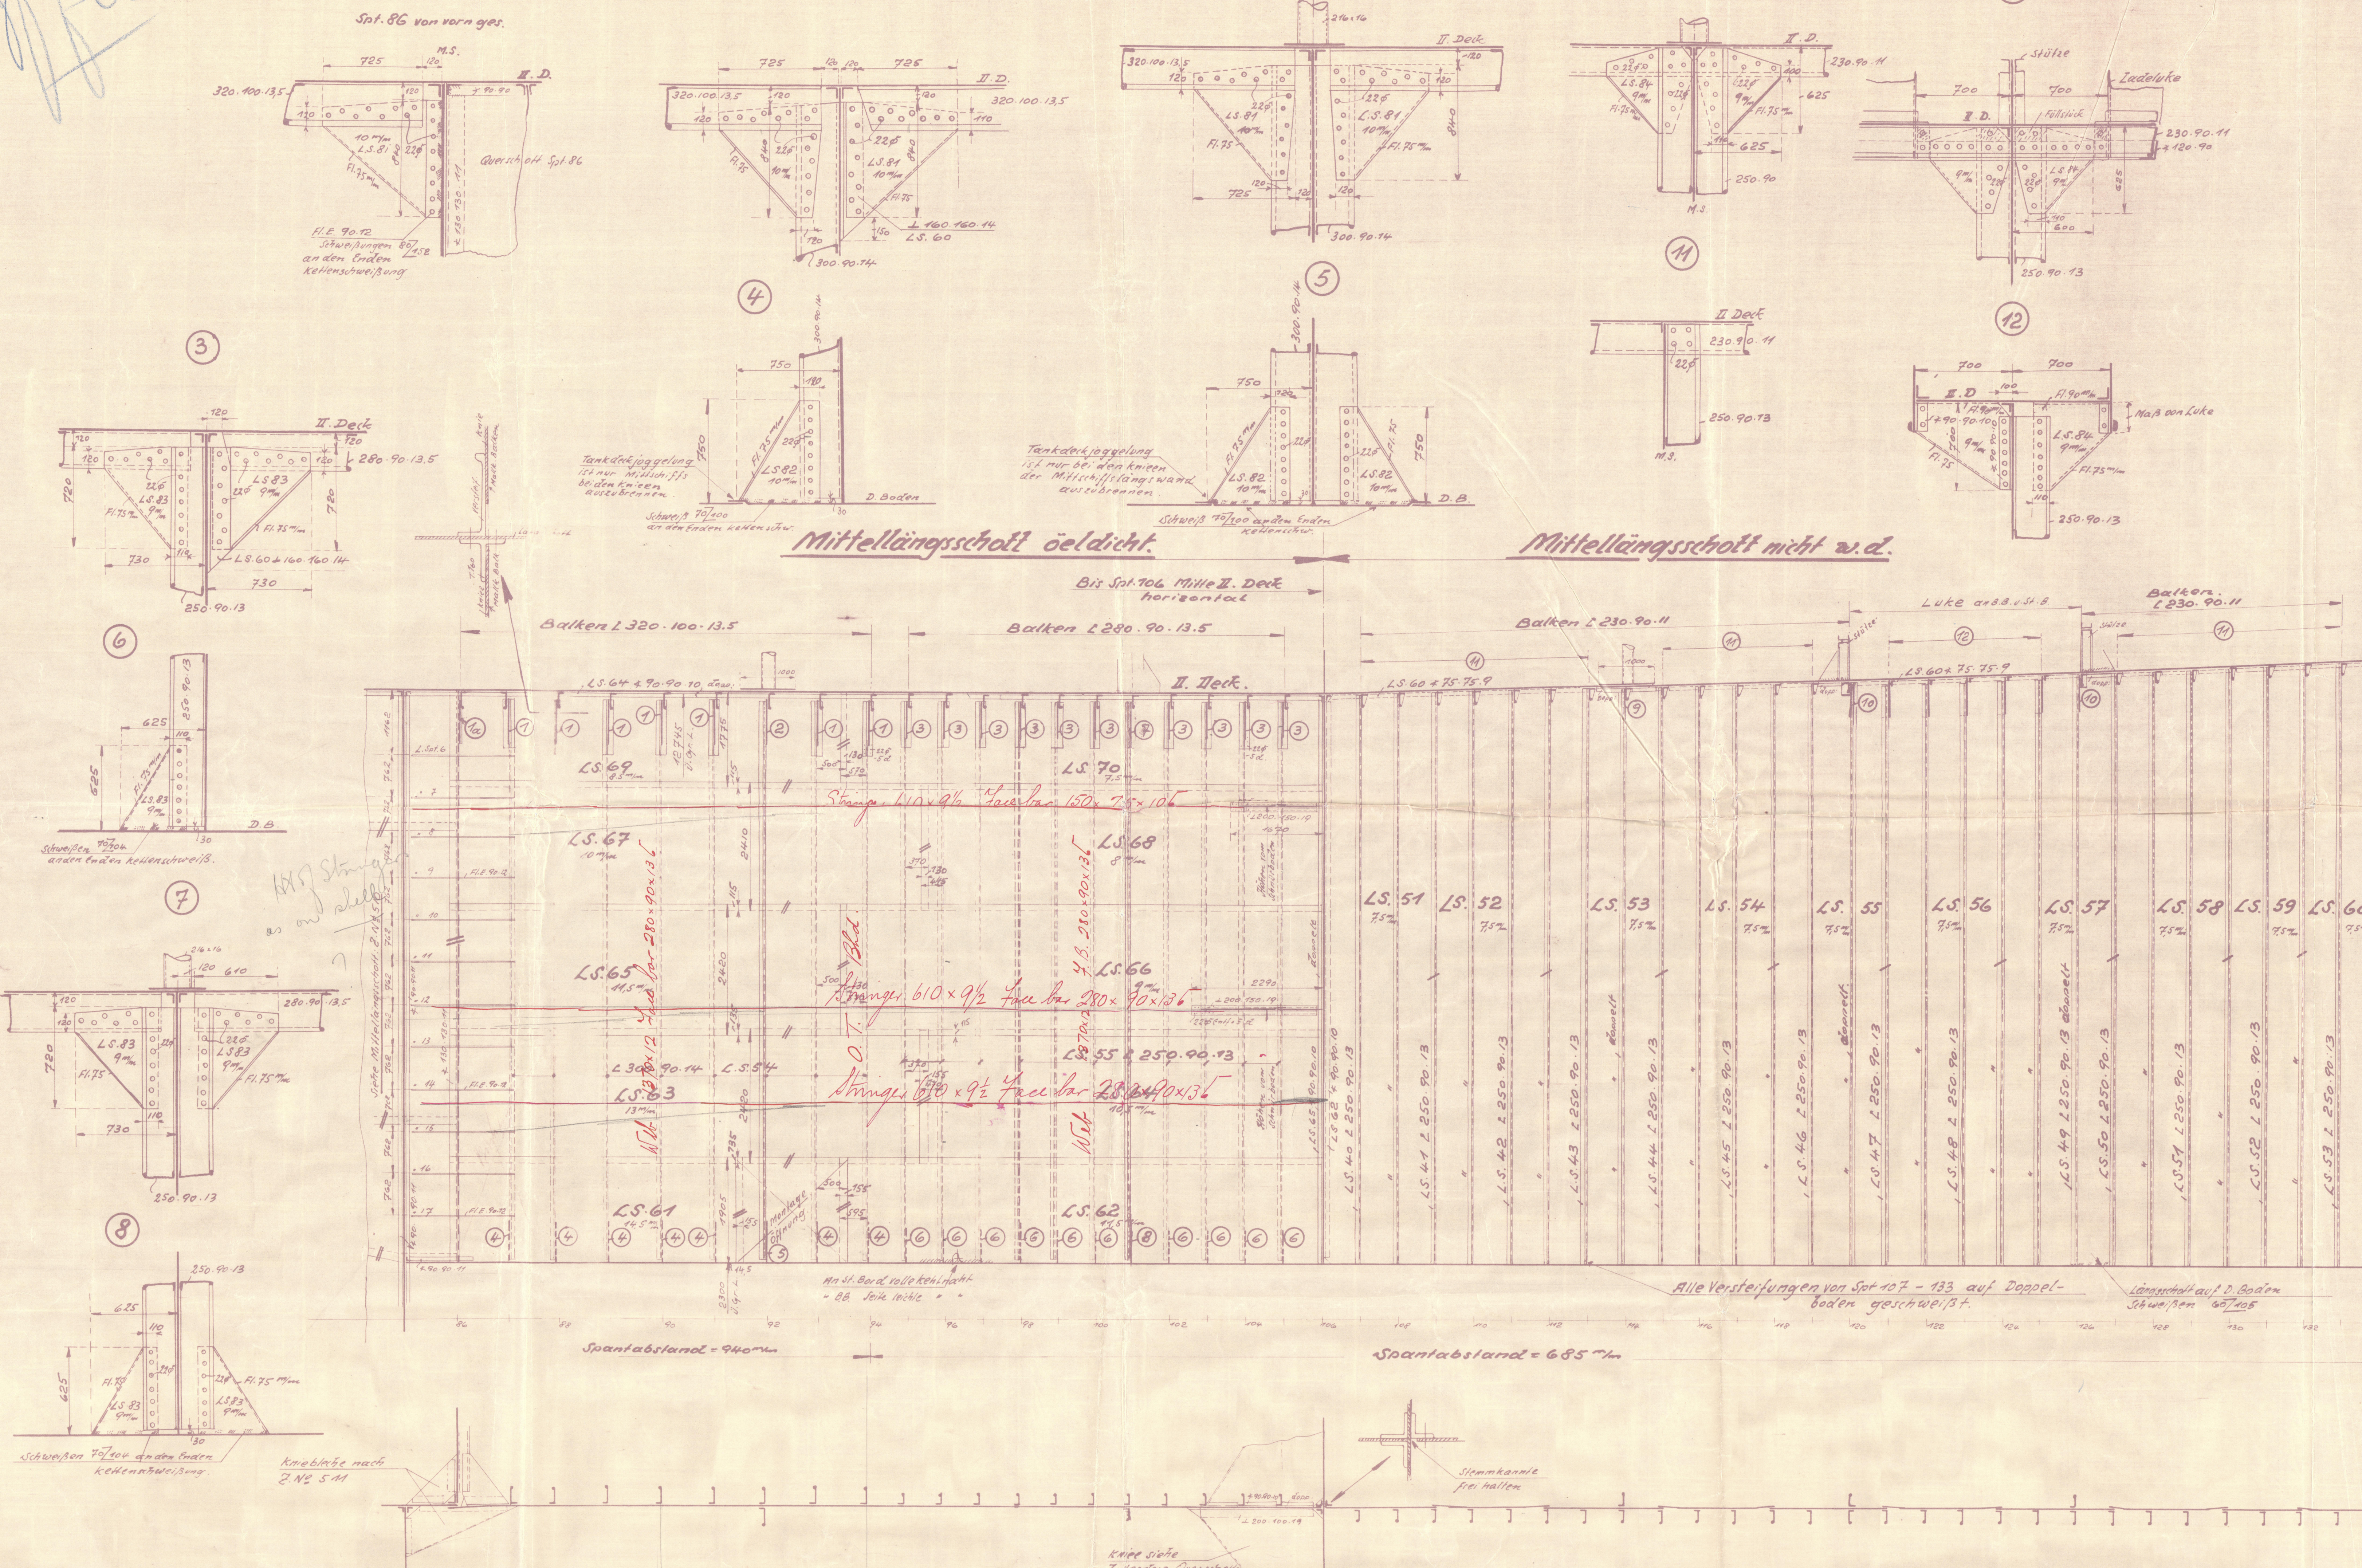

Seitenlängsschnitt 60% u. a. M.S. a. St. B. von St. B. ges.

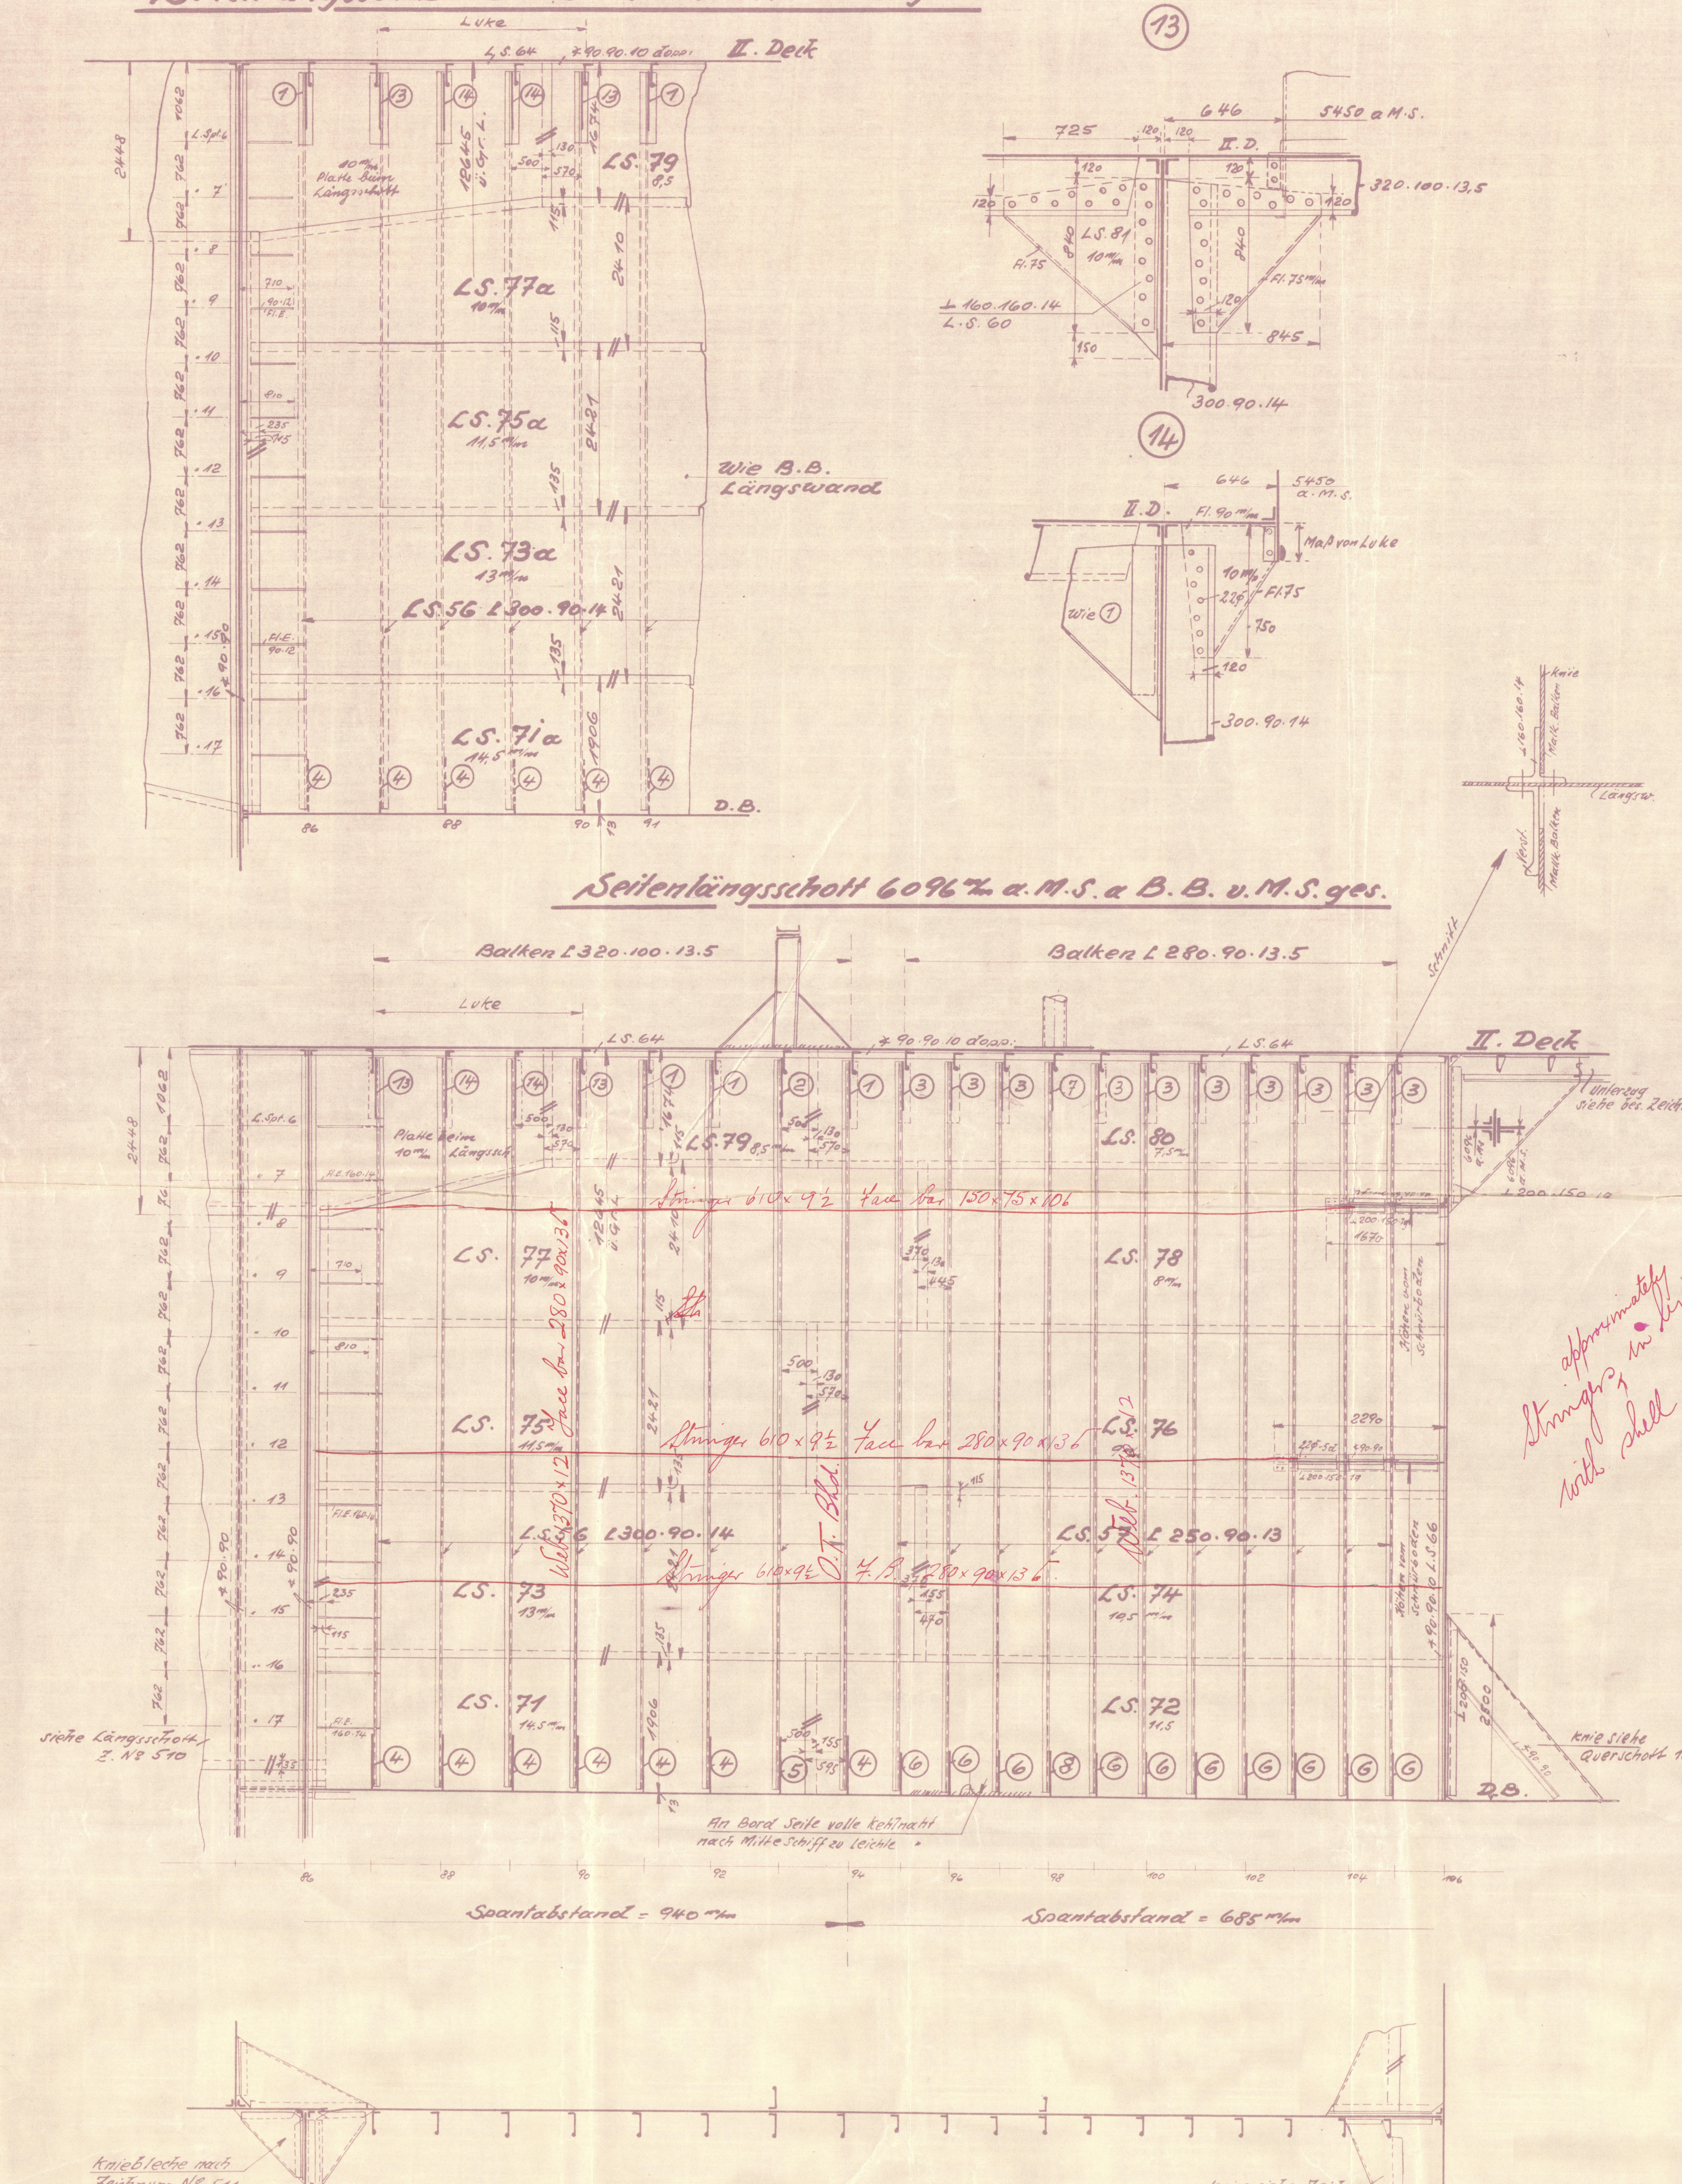

PROFILE						PLATTEN							
M.L.	Mark	Stück	Länge	PROFIL	BEMERKUNG	M.L.	Mark	Stück	Länge	BREITE	Stück	BEMERKUNG	
89	L. 140	2	10500	L 250 90 13		127	L. 151	1	10520	2070	7.1		
"	42	2	10340	"	"	"	52	1	10580	2165	"		
"	42	2	10340	"	"	"	53	1	10620	"	"		
"	43	2	10630	"	"	"	54	1	10720	"	"		
"	44	2	10670	"	"	"	55	1	10780	"	"		
"	45	2	10720	"	"	"	56	1	10865	"	"		
"	46	3	10770	"	"	"	57	1	10940	"	"		
"	47	2	10740	"	"	"	58	1	11025	"	"		
"	48	3	10740	"	"	"	59	1	11020	1440	"		
"	49	2	10820	"	"	"	60	1	11160	"	"		
"	50	2	10870	"	"	"	61	1	12400	1930	14.5		
"	51	2	11030	"	"	"	62	1	12840	"	14.5		
"	52	2	11090	"	"	"	63	1	12730	2450	14.1		
"	53	1	11110	"	"	"	64	1	12800	2430	13.5		
"	54	9	10300	300 90 14		"	65	7	12400	2440	14.5		
"	55	12	10300	250 90 13		"	66	1	12840	"	9		
"	56	19	10200	300 90 10		"	67	1	12730	2450	14		
"	57	24	10200	250 90 13		"	68	1	12145	2450	8		
						"	69	1	12240	1800	8.5		
80	L. 140	4	12000	L 100 100 14		"	70	1	12840	1800	7.5		
80	L. 140	2	15000	* 75 75 9		80	75	1	12840	1830	7.5		
"	61	1	11000	* 90 90 10		"	71a	1	12920	"	14.5		
"	62	1	10300	* 90 90 10		"	72	2	12840	"	14.5		
"	63	1	10000	* 90 90 10		"	73	1	12475	2450	13		
"	64	9	10500	* 90 90 10		"	73a	1	14240	2450	13		
"	65	2	102450	* 90 90 10		"	74	2	12340	1460	14.5		
"	66	4	10350	* 90 90 10		"	75	1	12920	2440	14.5		
						"	75a	1	12920	"	14.5		
						"	76	2	12840	"	9		
						"	77	1	102000 Breite			10	
						"	77a	1	"	"	10		
						"	78	2	12345	2450	9		
						"	79	2	12920	1700	8.5		
						"	80	2	12840	1700	7.5		
						"	81	2	12900	1700	10		
						"	82	1	10050	1500	10		
						"	83	3	12800	1500	9		
						"	84	2	10000	1250	9		

TERJE VIKEN

Plan of longitudinal bulkheads
for part of vessel

Primum letter M. 6. 77

W91-0127



© 2020

Lloyd's Register
Foundation

