
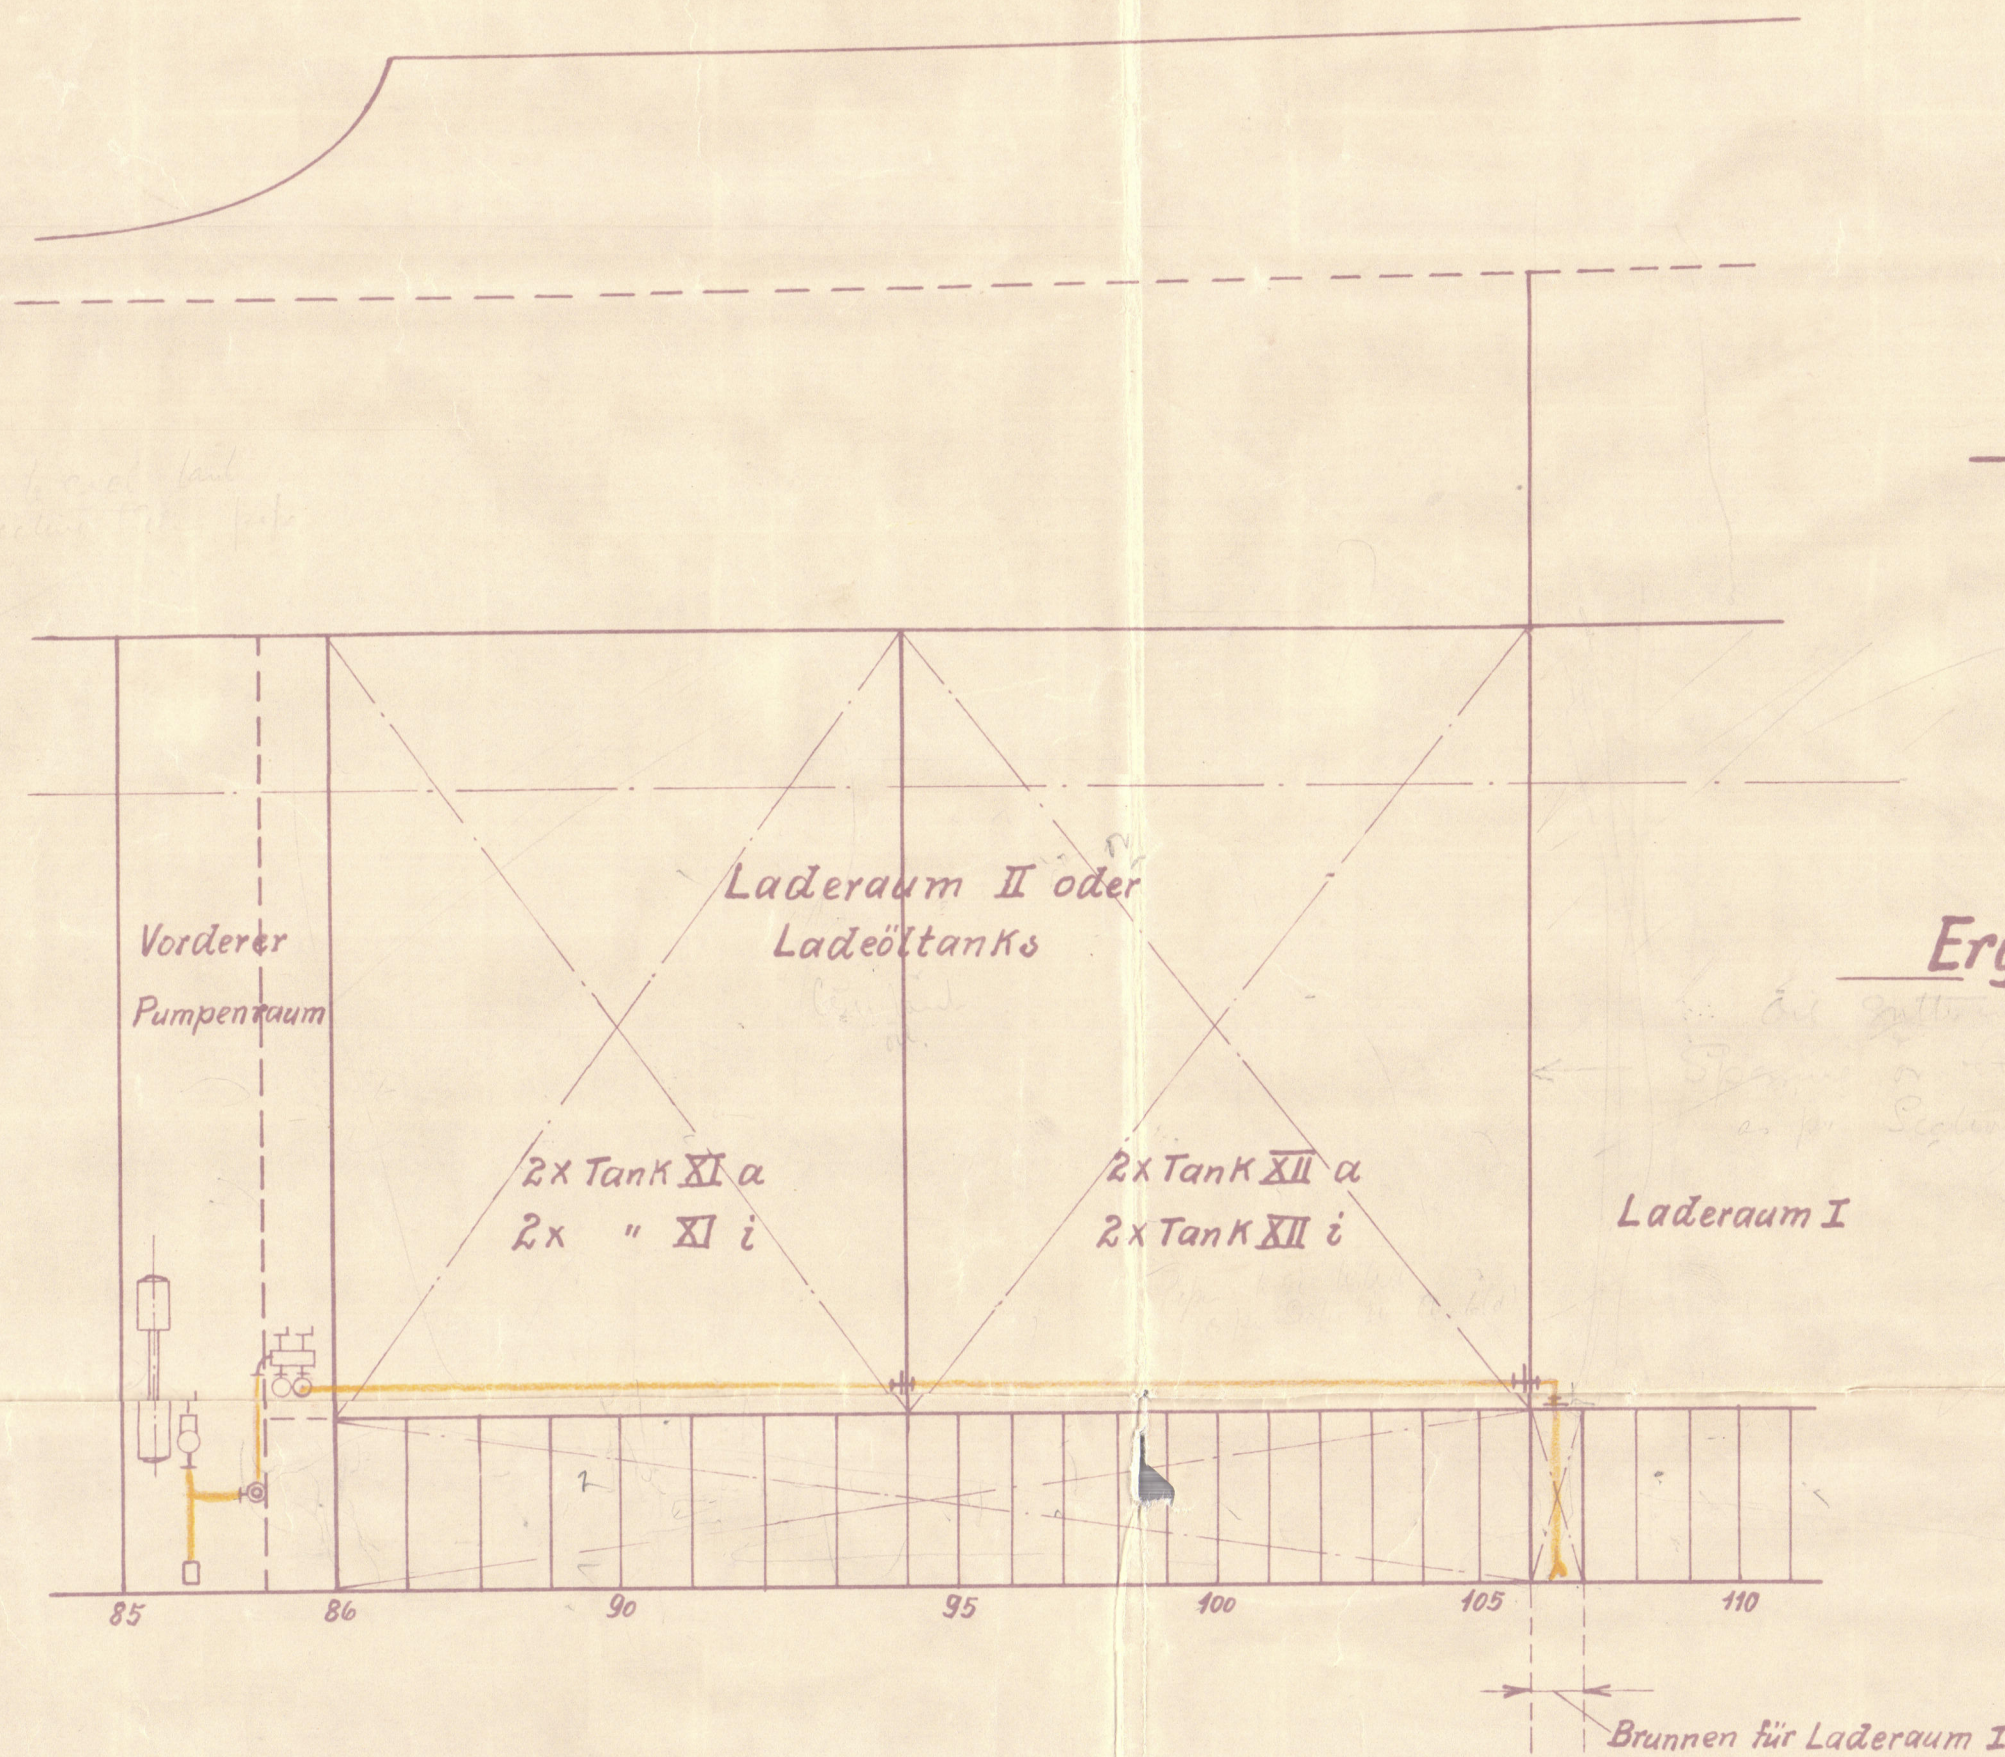


Umbau „Terje Viken“ (S. 914)

Schema der Walöl-, Heizöl-, Reste-, Spülwassersauge-, Überlauf-, Luft- u. Lenzleitung für den Umbau der Laderäume II in Ladeöltanks.

Ergänzungsblatt zur genehmigten Zeichnung I-3227 vom 6. 3. 1936.

M. 1:100

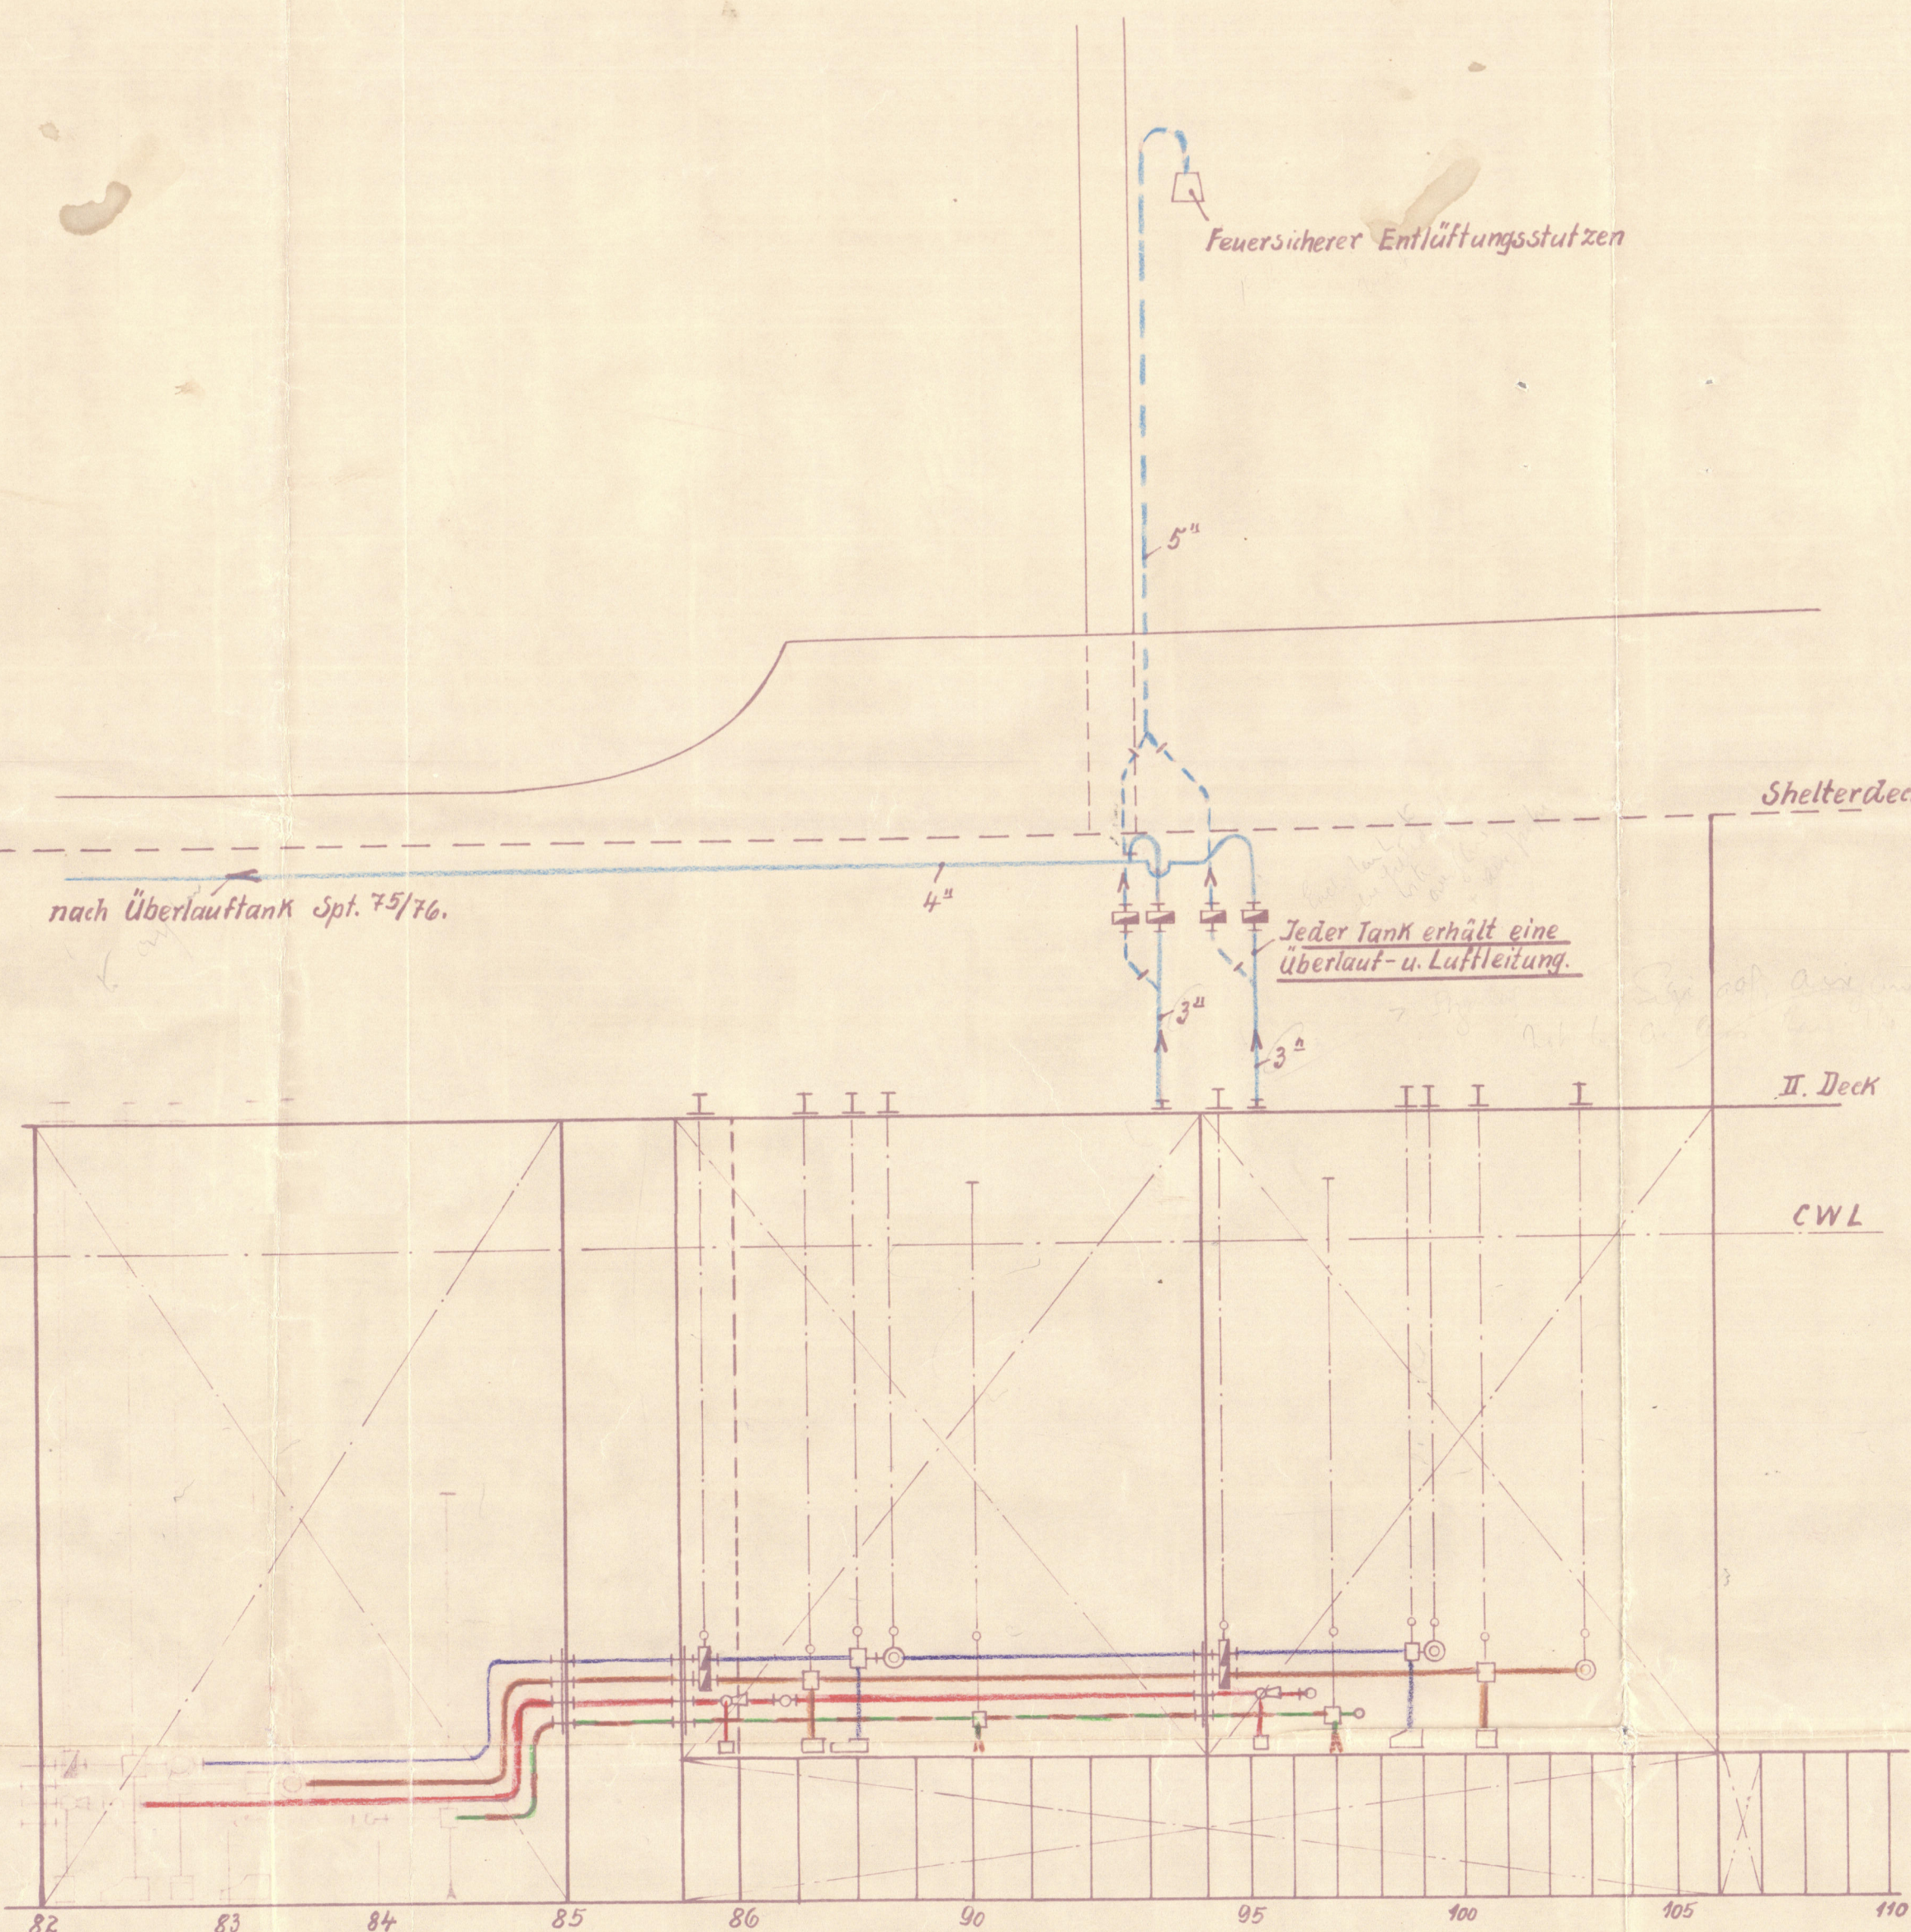



Requirements of Section 21 Clause 6 of the Rules
for vessels intended to carry petroleum in bulk,
to be complied with.

Zeichenerklärung:

- ☐ Schieber
- ⊗ Ventil
- ⌵ Hahn

Farbenerklärung:

- Walölleitung
- Heizölleitung
- Resteleitung
- Spülwasser-Saugeleitung
- Überlaufleitung
- Luftleitung
- Lenzleitung

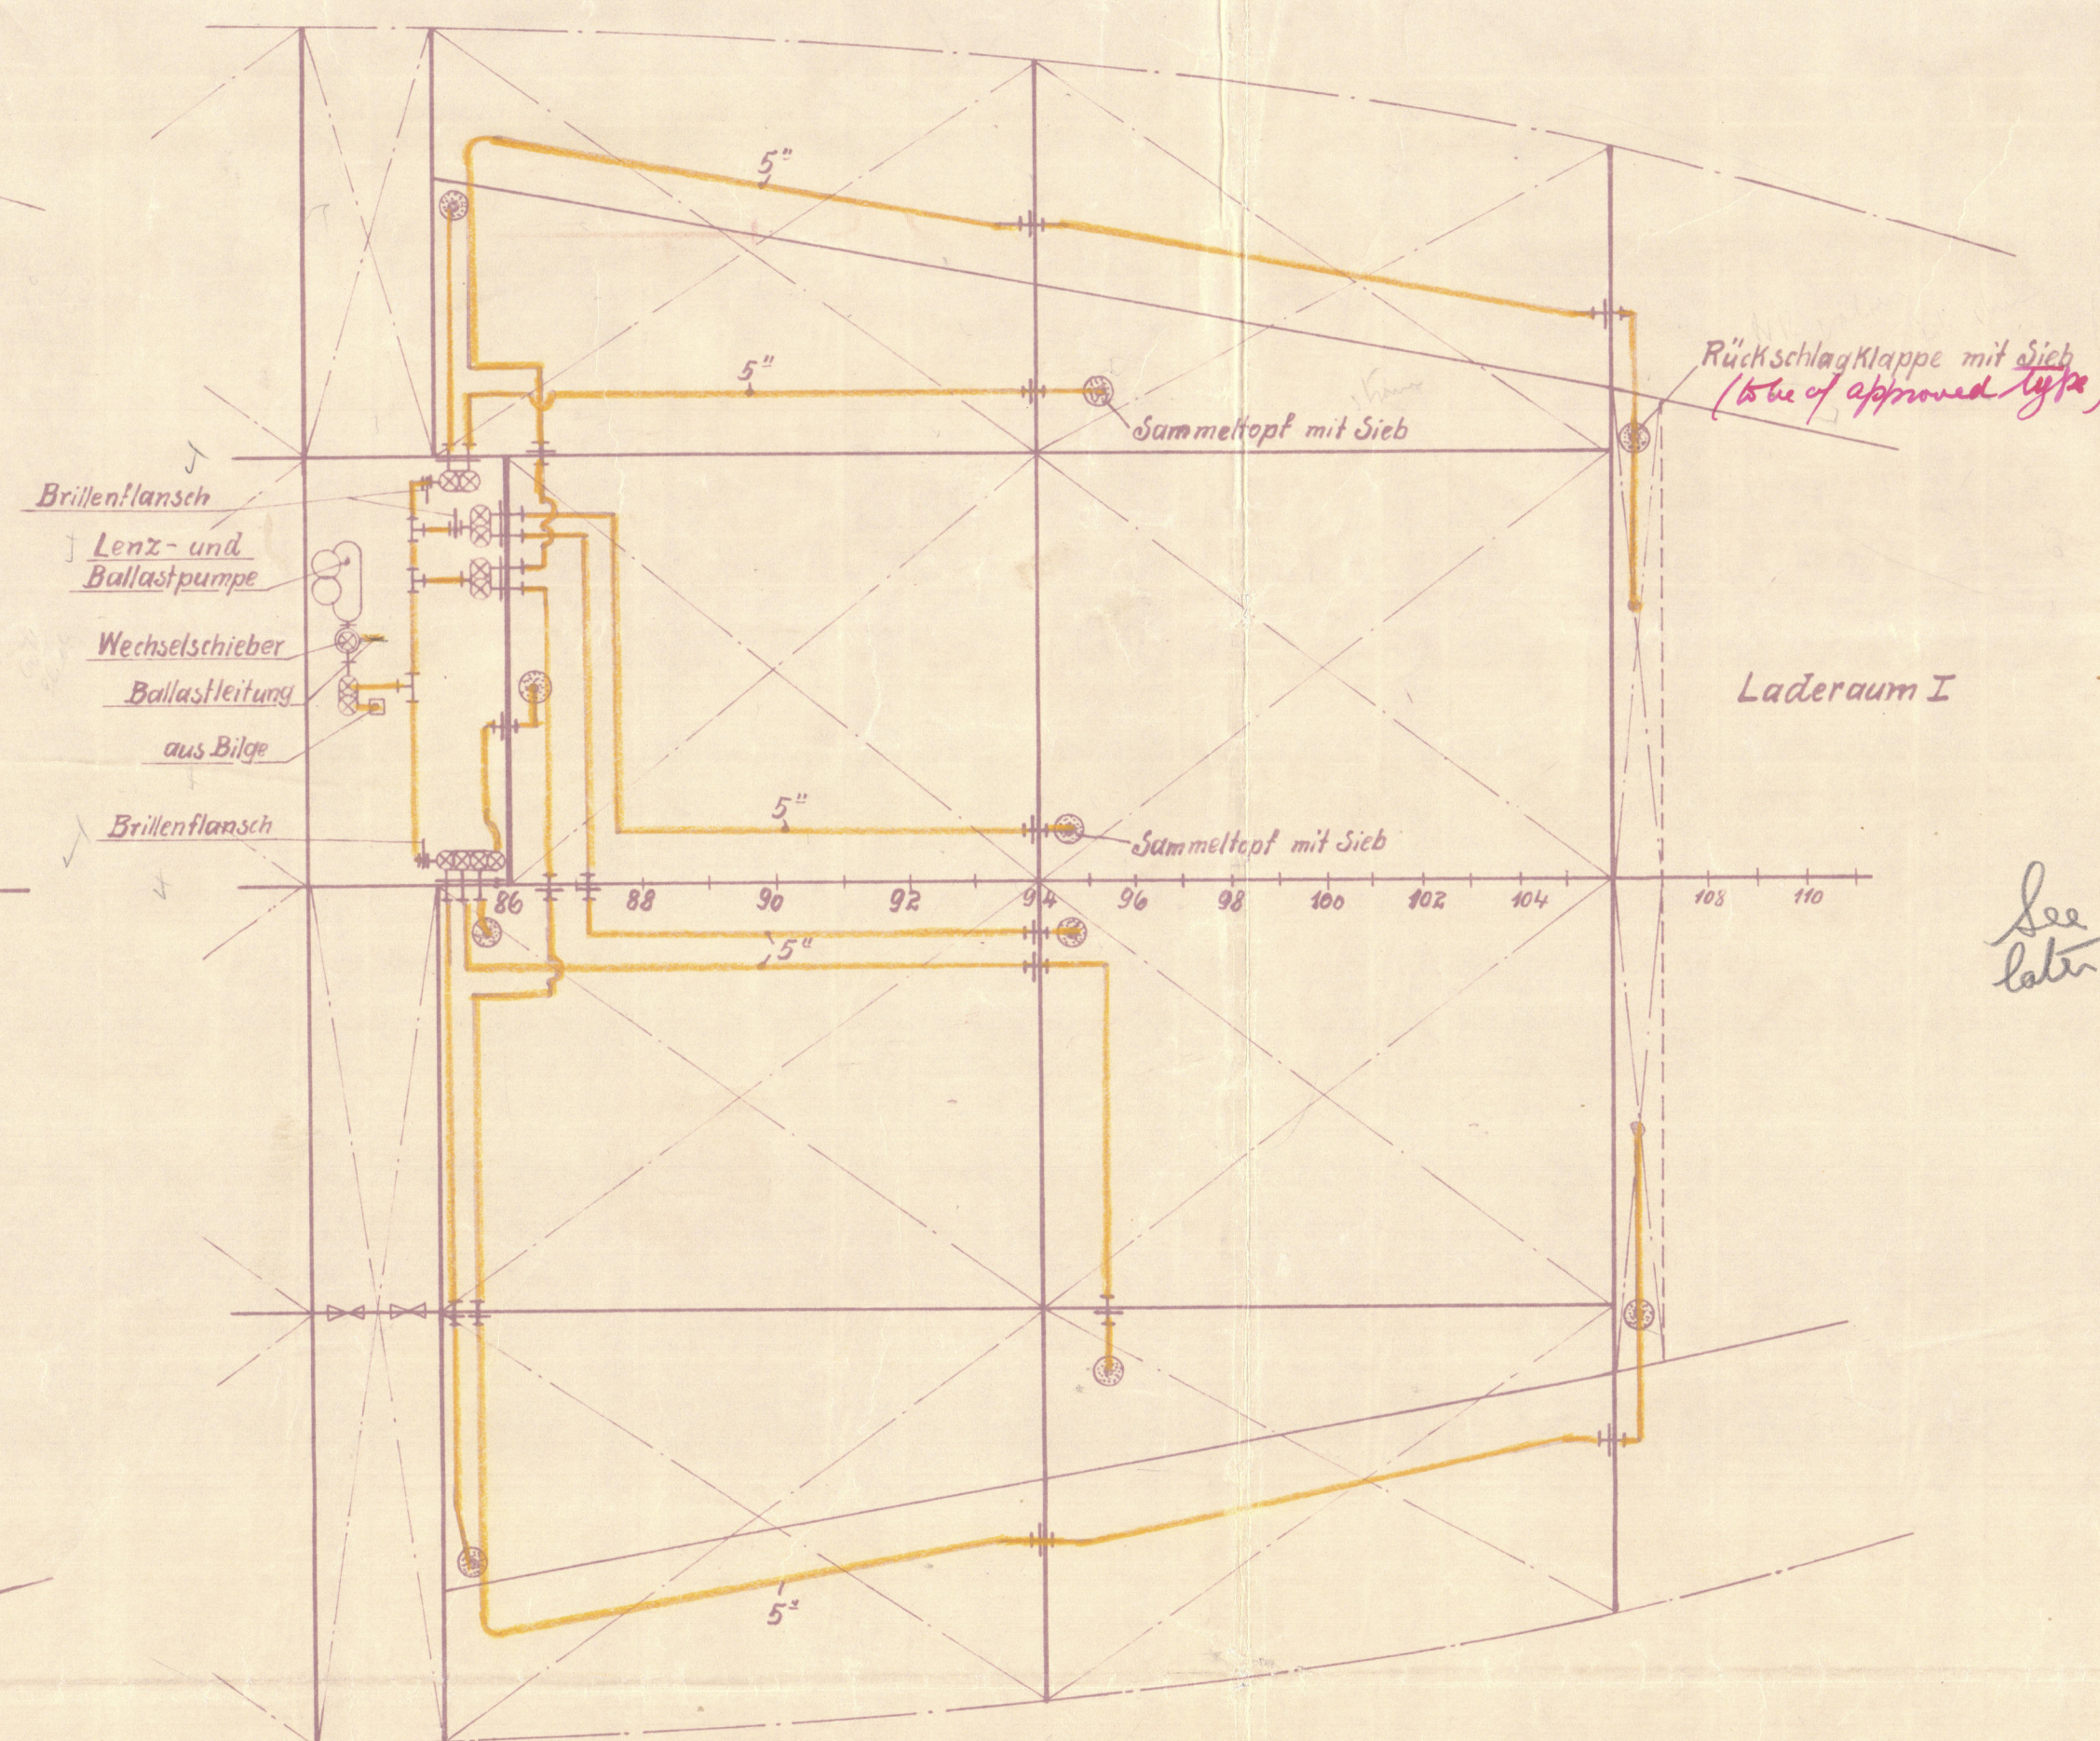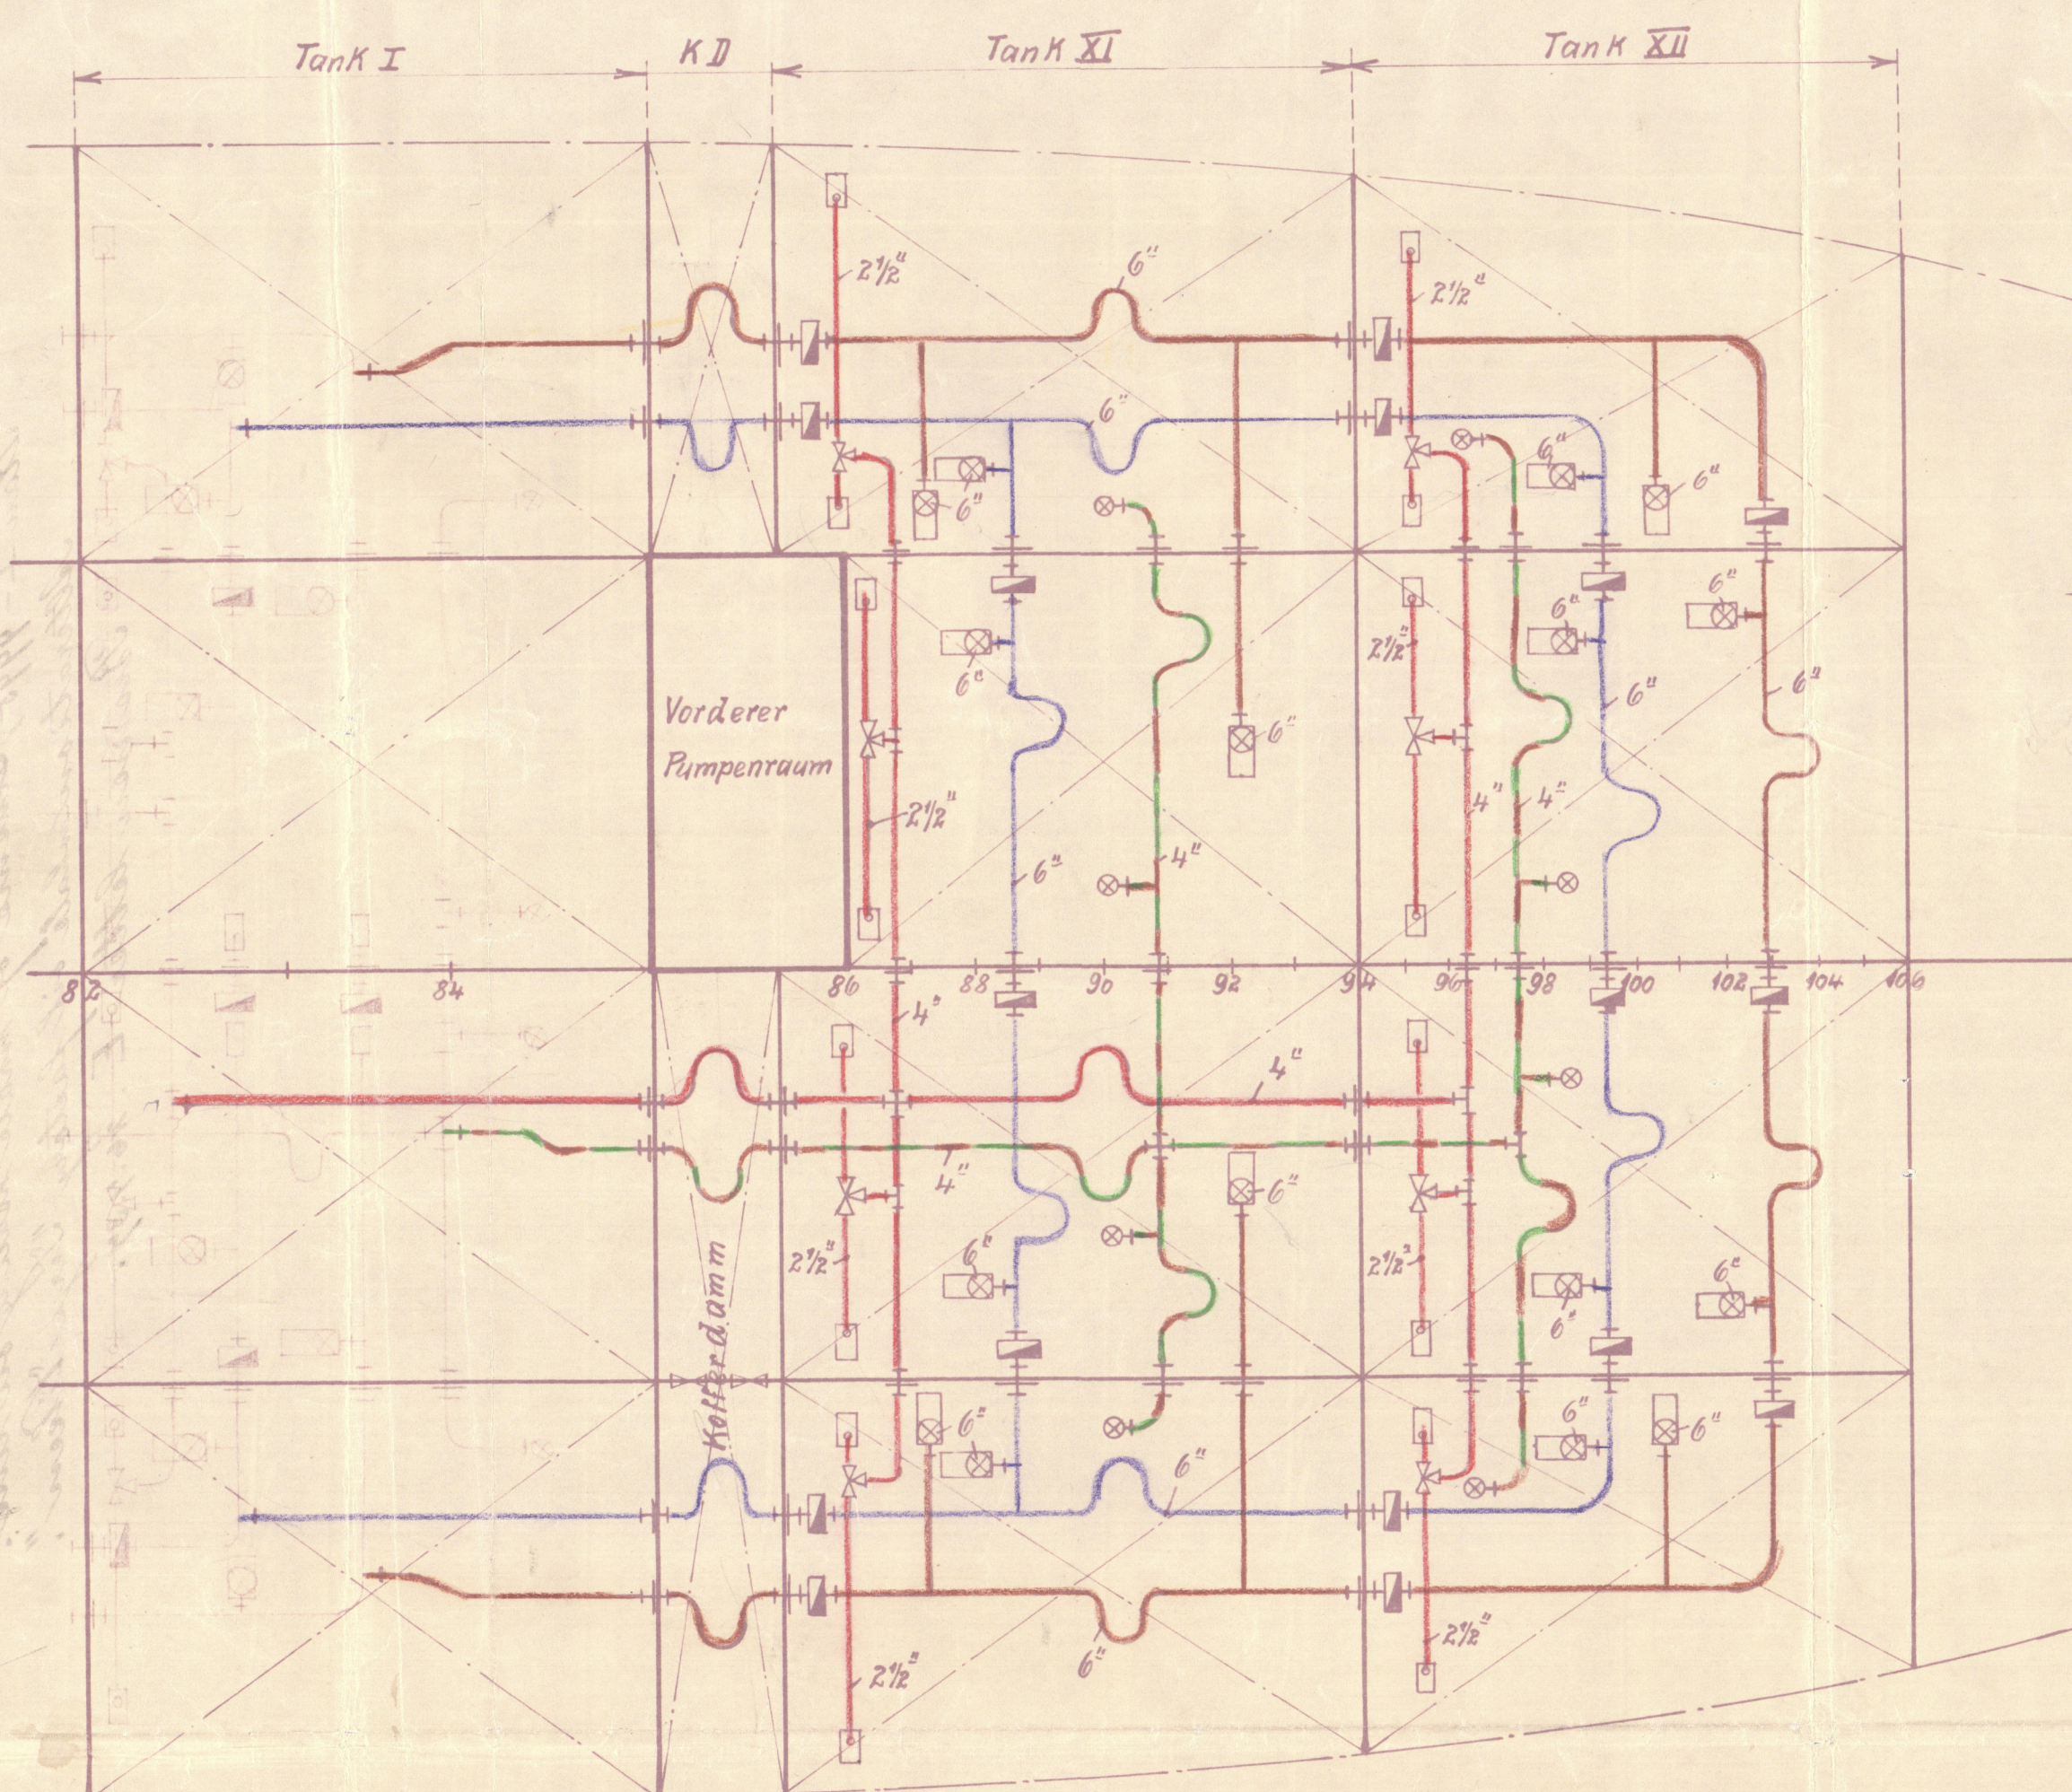

See later

Die Lenzventilkästen erhalten Rückschlagregel.

No Cargo claims or other claims shall be caused by cargo to be carried in No 1 Hold when petroleum is carried in No 2 Hold tanks.

No petroleum to be carried in double bottom tanks under No 1 & 2 Hold.

For spaces to be fitted to No 1 Hold.

Deck over No 1 Hold to be made gastight - this includes fitting of steel watertight covers to the hatchways.

For peak not to be used as ballast tank and existing connection to be removed - Bilge ejector controlled from deck, to be fitted for drawing off peak.

Bilge connection to No 2 Hold to be blanked off when petroleum is carried in that hold and a Notice Board fixed in fwd. pump room, containing instructions to this effect.

Electric wiring and fittings in tween decks to comply with the requirements of Section 15 of the Rules for Electrical Equipment.

14/8/37

Item 21 Clause 15 of The Rules
to carry petroleum in bulk,
and with.

Farbenerklärung:

- Walölleitung
- Heizölleitung
- Resteleitung
- Spülwasser-Saugleitung
- Überlaufleitung
- Luftleitung
- Lenzleitung

sten erhalten Rückschlagkegel.

the store likely to cause sparks to
when petroleum is carried in No 2

ried in double bottom tanks under

to No 1 Hold.

to be made gastight - this includes fitting
over to the Hatchway.

used as ballast tank and existing connections
Bilge ejector controlled from deck, to be fitted
back

to No 2 Hold to be blanked off when petroleum
is held and a Notice Board fixed in Ford. pump room,
to this effect

and fittings in tween decks to comply with the
Section 15 of the Rules for Electrical Equipment.

Ch.
14/8/37.
[Signature]

Bremen, d. 23. 7. 1937. Oldorf *W.S.*
Seiger

W91-0128

W91-0128

Messrs. Maschinen, Werkstat. Ges. "Meer", Bremen.
Plan I-9995, Scheme of whale floating oil line.
"Attraction made oil factory 'Vergo' Bremen".
Bremen Letter E. 26. 7. 37.



© 2020

Lloyd's Register
Foundation