

Anordnung der Öl-Füll-, Saug- u. Überlaufleitungen.

M. 1:100.

The flash point of the oil fuel for burning purposes on board to be above 150°F. and the remaining requirements of Section 20 of the Rules 1936-7 to be complied with as far as they are applicable.

J.R.B.
15/6/37

- ~~Öl- Saug- u. Füllleitungen~~ (oil suction & filling lines)
~~Überlaufleitungen~~ (overflow lines)
~~Entlüftungsleitungen.~~ (Air pipe leads.)

Schl. = Schnellschlußventil (closing valve)
VK. = Ventilkasten. (valve box.)

Die beigefügten Zahlen bedeuten die letzten Rohrdurchmesser.
(The denominations are the inside diameters of the pipes.)

TERJE VIKEN

Plan of proposed Pumping Arrangement
for hold No II

Prinsen lissur 11. 6. 37

LONDON COPY.

W91-0130




© 2020

Lloyd's Register
Foundation

The flash point of the oil fuel for burning purposes on board to be above 150°F. and the remaining requirements

M. 1. 100

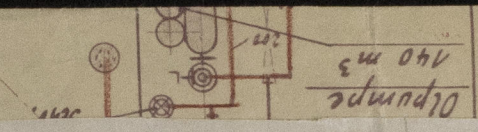

the pump
arrangement.