



15.3.12
6.4.12


PROFILE & DECK PLANS
LENGTH B.P. 420'0" BREADTH EX 54'6" DEPTH MLD 32'0"
SHERWOOD SYSTEM PATENT
SCALE 1/4" = 1'00"

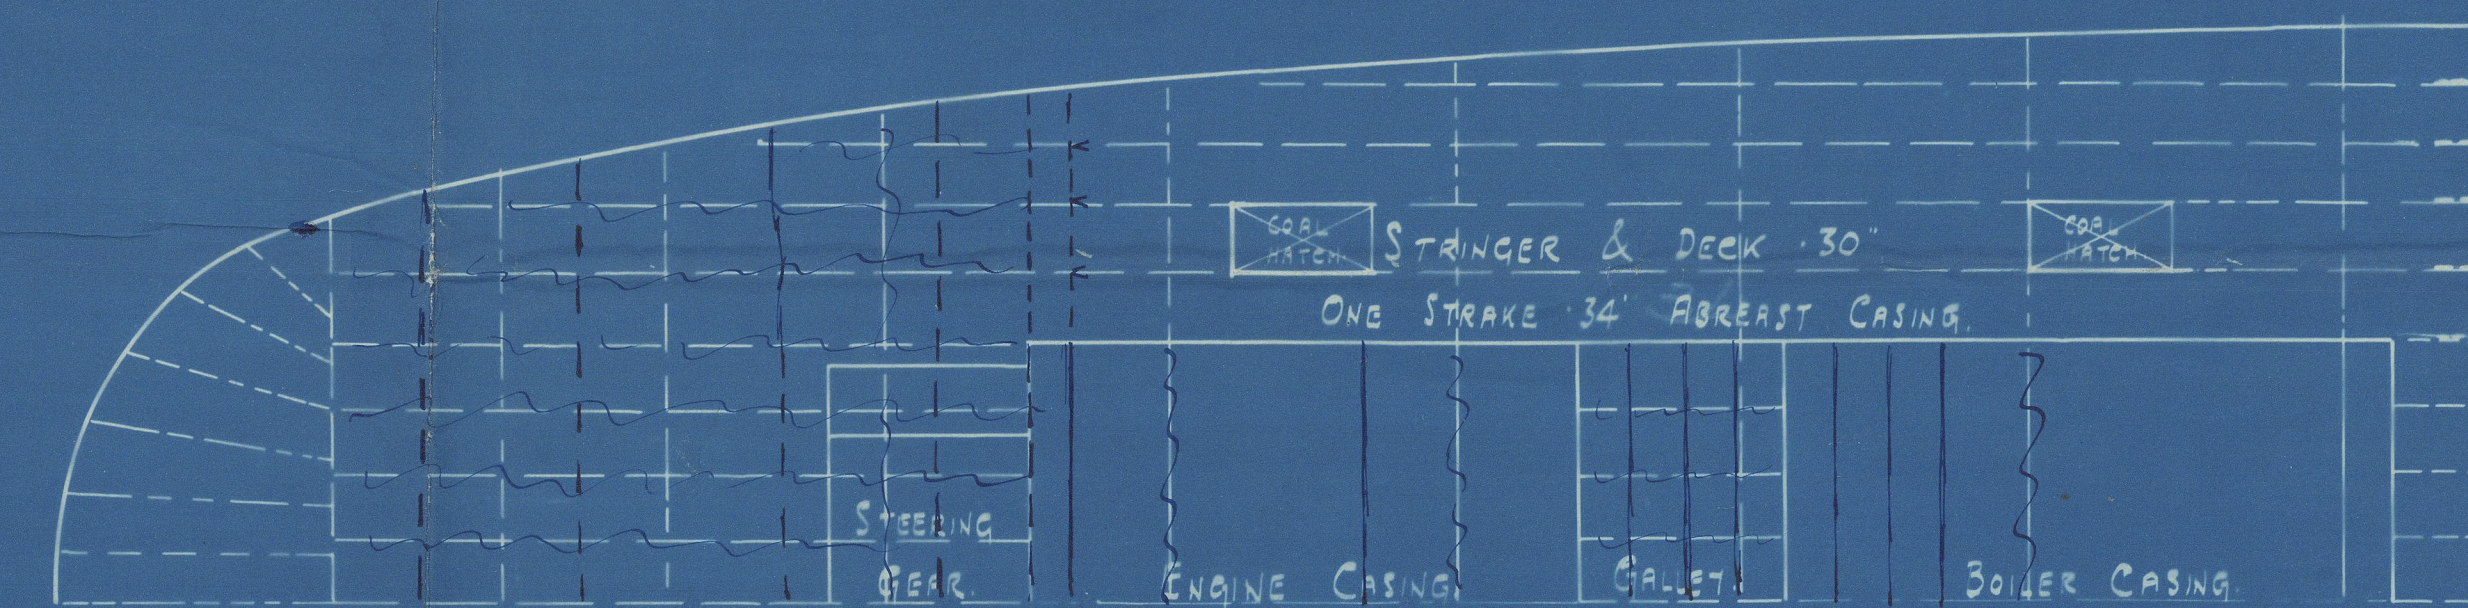




Beams 9'6" x 18" 16" on all frames

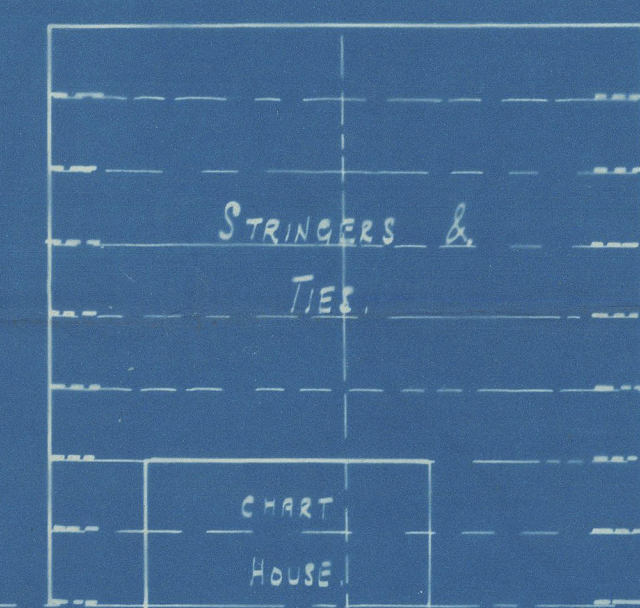

Bridge Deck

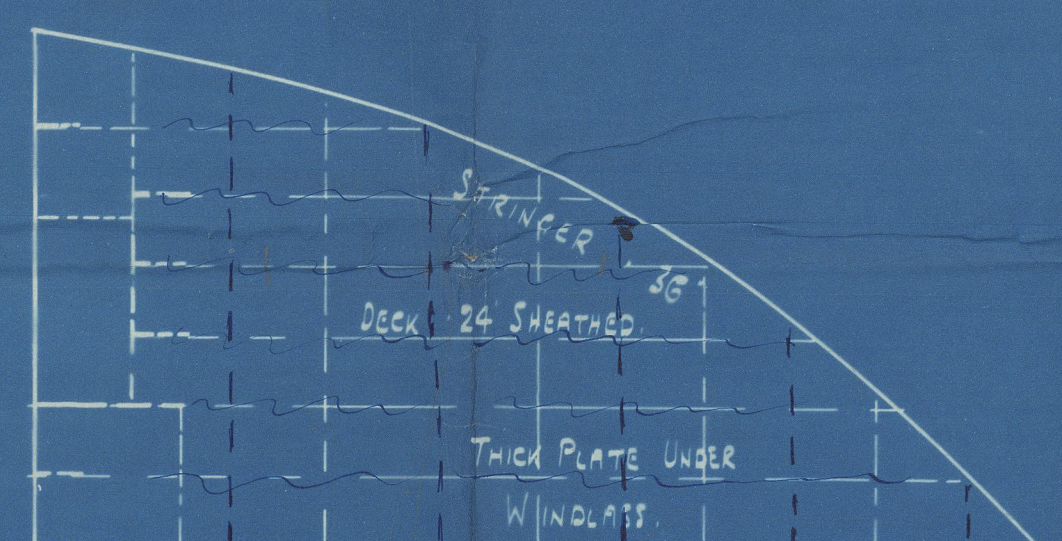

Forecastle Deck

   

J. W. ISHERWOOD
3.5. No 900
12/3/12



Messrs SWAN, HUNTER & WIGHAM, RICHMOND LTD
LONDON

Swan Hunter &
Wigham Richardson Ltd

S.S. 900 Long framing


Profile & Deck plans

REMAIN

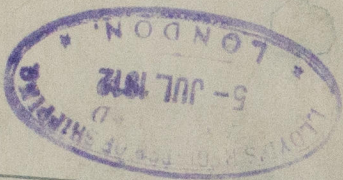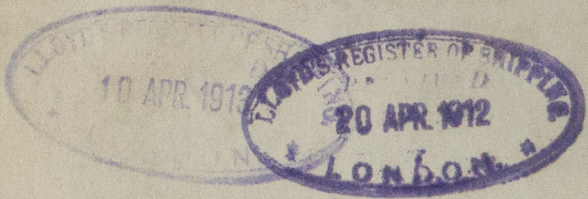

S.S. EL TORO
NEWCASTLE-ON-TYNE.

Report 6064

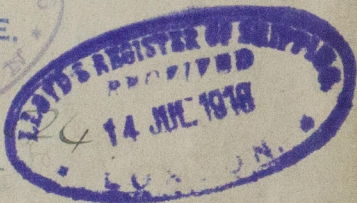

Long framing


Profile & Deck plans

S.S. EL ZORRO
NEWCASTLE-ON-TYNE.

Report 6084.



225

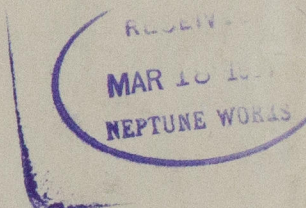

900



© 2020

Lloyd's Register
Foundation

1100-0910