



POOP DECK.


S.S. 222.
 PROFILE & DECK PLANS.
 DIMS 350'-0" B.P. x 49'-9" EXT. 25'-10" DEPTH MOULDED
 CLASS 100 A.I. LLOYDS 3 DK RULE: 2 DK. FRAMING.
 SCALE 1/8" = 1 FOOT.

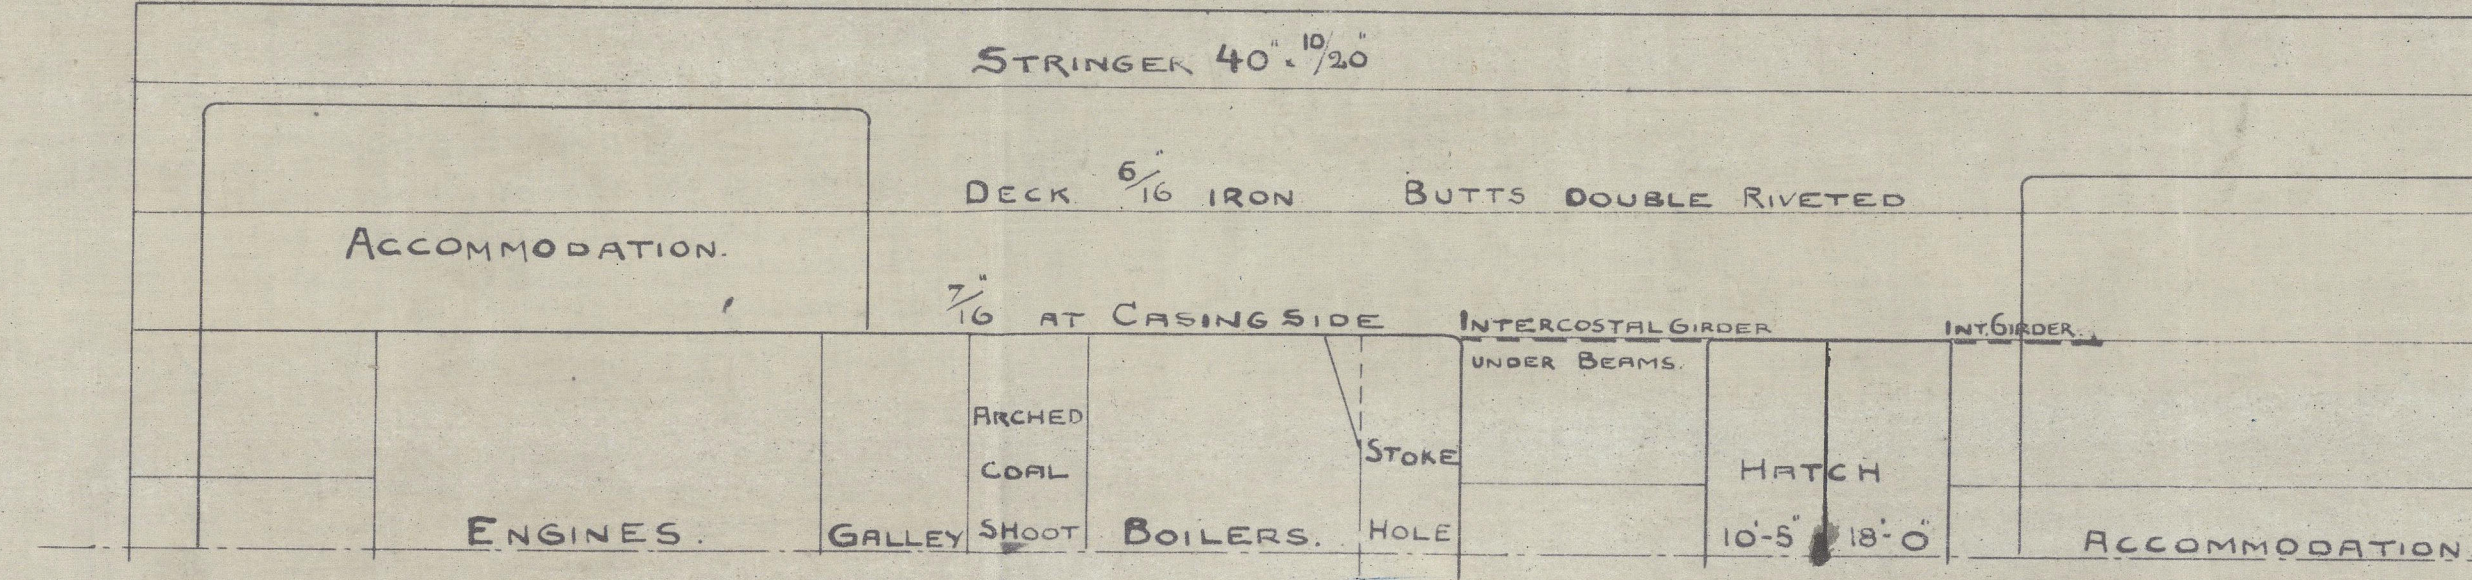


BRIDGE DECK

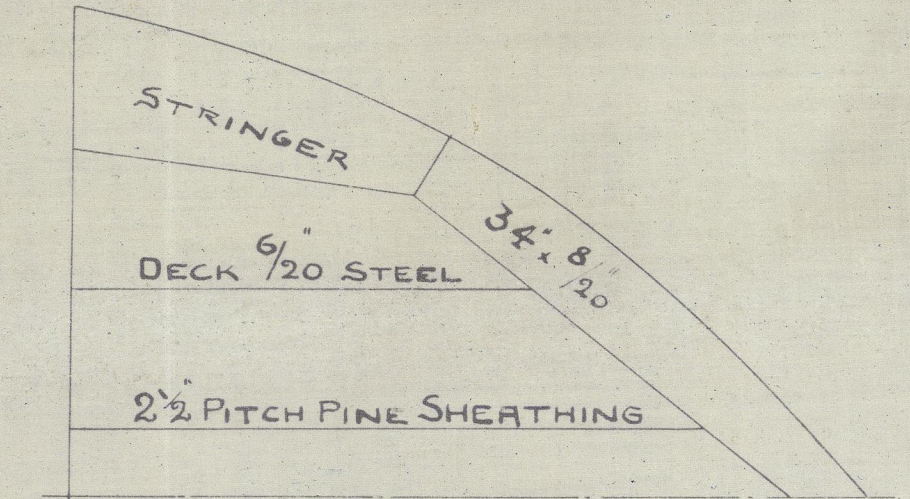

FORECASTLE DECK.

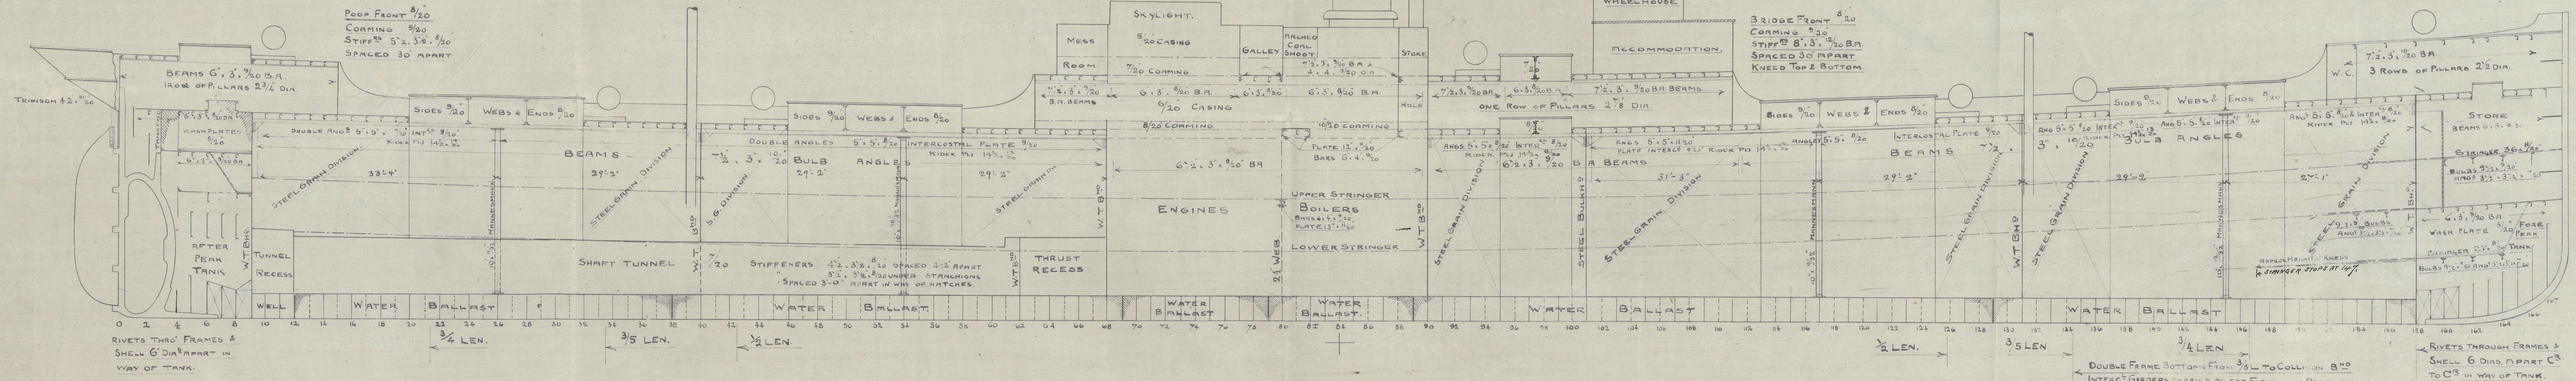

R CRAGGS & SONS LTD
 SHIPBUILDERS & REPAIRERS
 TEES DOCKYARD,
 MIDDLESBROUGH

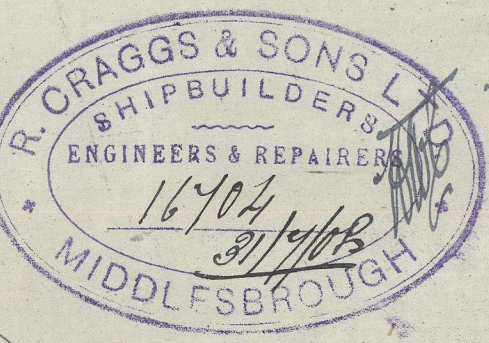

K. Craggs & Sons Ltd.

S. S. No. 222

Profile & Deck Plans
of vessel as built

S/S "Brika"

Ind. Rpt No 5521

RETAIN



© 2020

Lloyd's Register
Foundation

W914-0158