




PROFILE & DECK PLANS.
DIM^s 350'-0" B.P. x 49'-9" EXT. 25'-10" DEPTH MOULDED.
CLASS 100 A.T. LLOYDS 3DK RULE: 2DK FRAMING.
SCALE $\frac{1}{8}" = 1 \text{ FOOT.}$

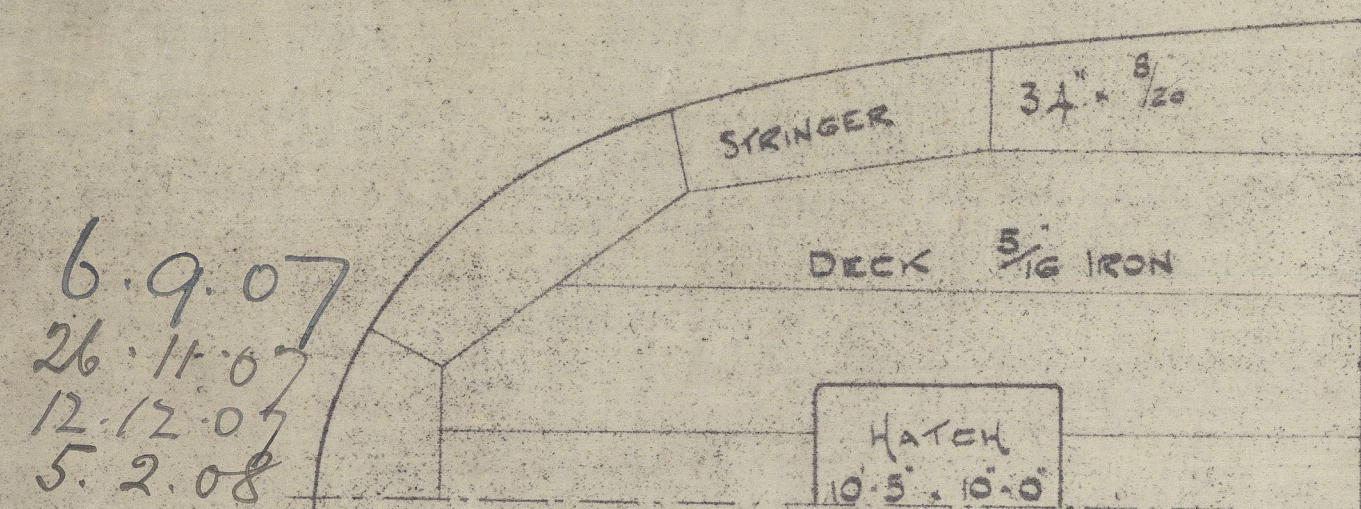


POOP DECK

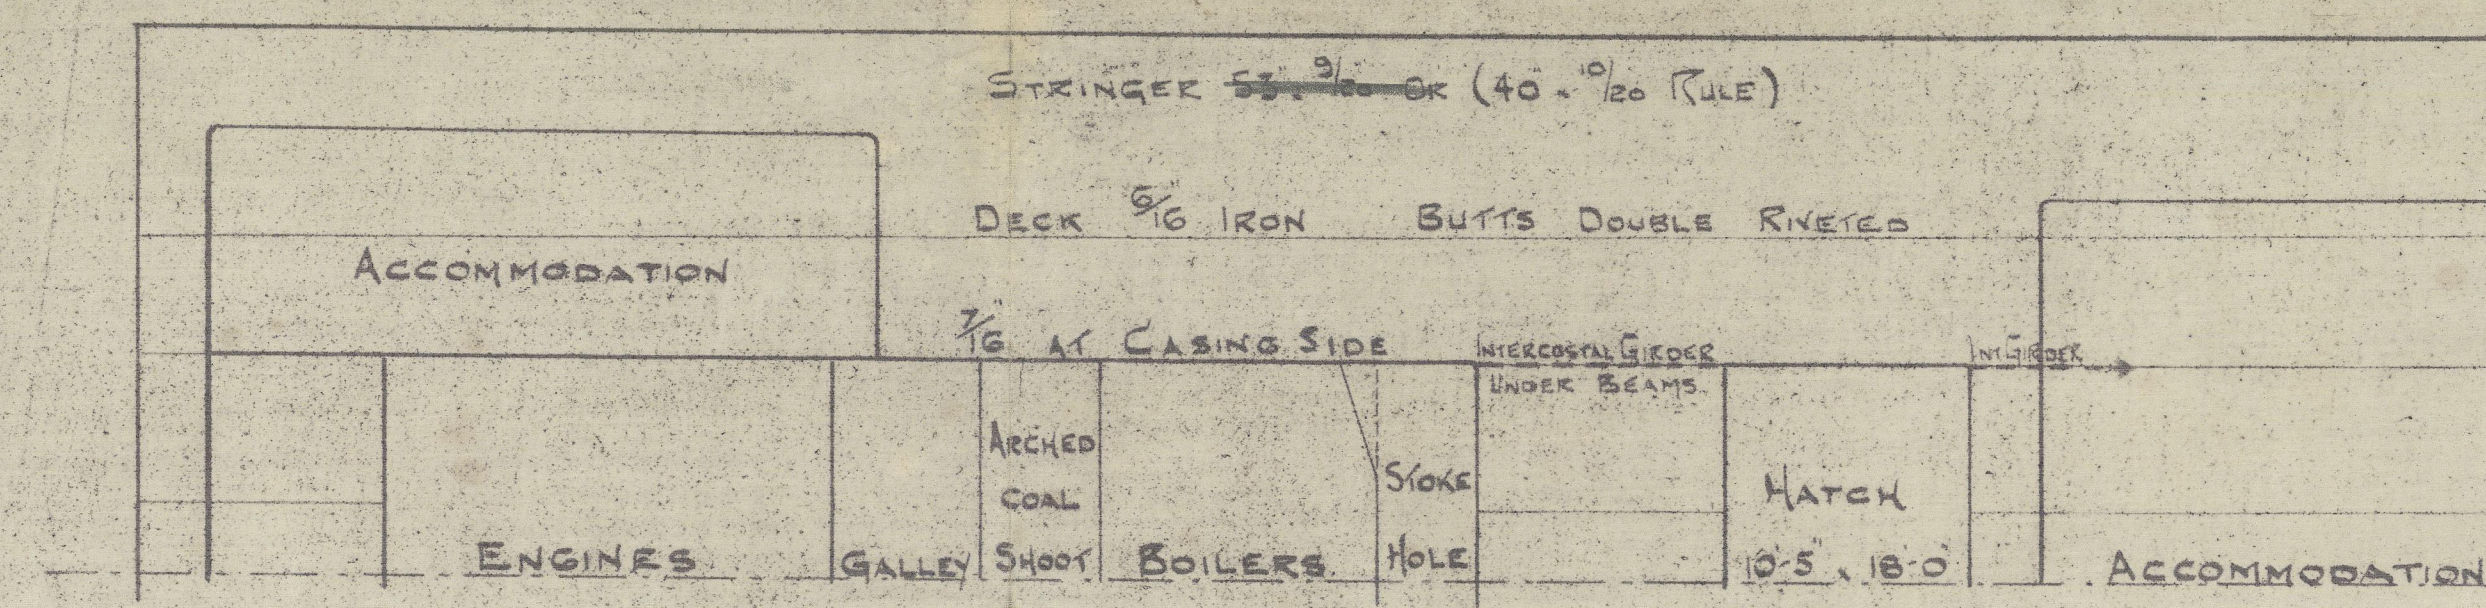

BRIDGE DECK

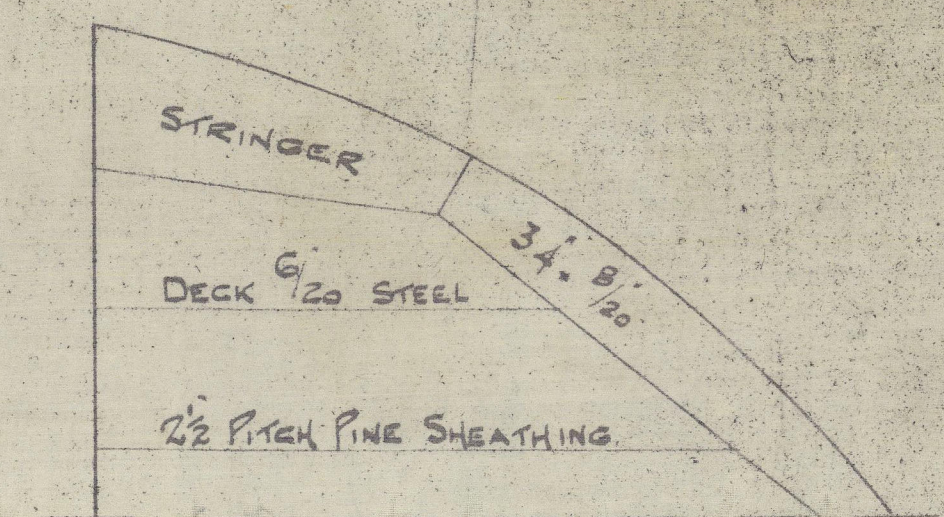

FORECASTLE DECK.

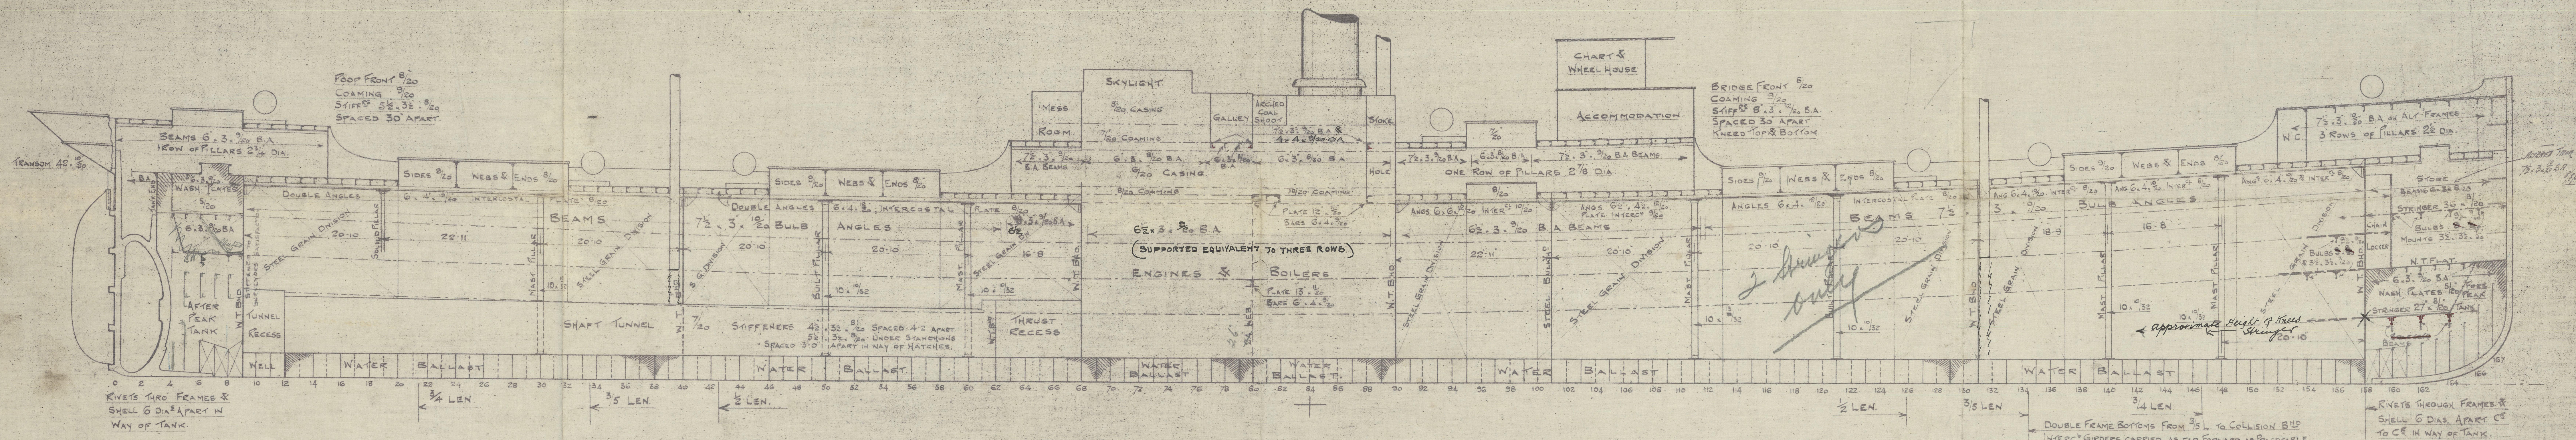

R. CRAGGS & SONS LTD
SHIPBUILDERS & REPAIRERS
KEES DOCKYARD.
MIDDLESBROUGH

IN LIEU OF FITTING DOUBLINGS, WE PROPOSE TO INCREASE THE THICKNESS OF ONE STRAKE ALONGSIDE OPENINGS AS INDICATED ON PLAN AND TO TREBLE RING THE BUTTS IN WAY OF OPENINGS.

C.B.
6.9.07.

222-3-4 © 2020



R. Craggs & Sons Ltd
S. S. No 222-3-4

Profile & Deck plans

No. 222

of Briku

Adl. Rpt. No. 5521

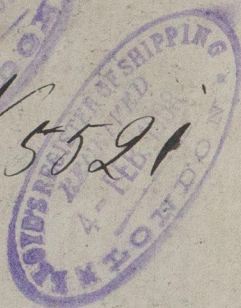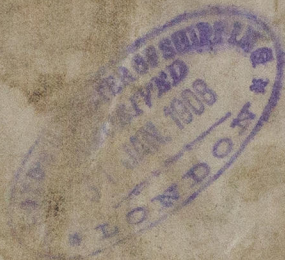

RETAIN

RETAIN



© 2020

Lloyd's Register
Foundation

W916-0159