

LLOYDS NUMERALS

<u>1st</u> BREADTH	24. 75	
<u>2^d</u> GIRTH	47. 66	
<u>DEPTH</u>	26. 83	
<u>1st No 2DK. FRAMING</u>	99. 24	= $\frac{97}{103}$
	7. 00	
<u>1st No 3DK. FRAMING</u>	92. 24	= $\frac{91}{97}$
	348. 16	
<u>2nd No 3DK. PLATING</u>	32114. 27	= $\frac{312}{33900}$
<u>2nd No 2DK. "</u>	34551. 39	= $\frac{339}{36800}$

LLOYDS DIMENSIONS.

<u>LENGTH</u>	=	<u>348.16</u>
<u>BREADTH MLO</u>	=	<u>49.50</u>
<u>DEPTH</u>	=	<u>26.83</u>

DEPTHS TO LENGTH 12.97

S.S. N° 222 - 334

LENGTH B.P. 350'-0" BREADTH EX. 49'-9" DEPTH MLD 25'-10"
CLASS 100.A.1. 3 DECK RULE 2 DECK FRAMING.


Corrected to Lloyds approved. Plan 12/9/07

<u>EQUIPMENT NUMERALS</u>	
POOP	30.33
BRIDGE	100.90
FCSLE	36.00
	<u>166.33</u>
	7.5
	<u>831.65</u>
	<u>116431</u>
	1247.475
	623.737
	<u>1871212</u>
<u>TWO DK N°</u>	99.24
	348.16
	<u>34551.39</u>
<u>ERECTIONS</u>	1871.21
ENG ^S 28.7	196.00
SAL 20.7	140.00
<u>NUMBER :</u>	<u>36758.60</u>
<u>GRADES</u>	361/39400

EQUIPMENT.

2 BOWER ANCHORS. STOCKLESS	52½ CWT.
1 " " " "	44½ "
1 STREAM " EX STOCK	14 "
1 KEDGE " " " "	6 "

270 FATHOMS 2½" STUD CHAIN CABLE
STREAM CHAIN TOWLINE E.G. AS PER T. 22.

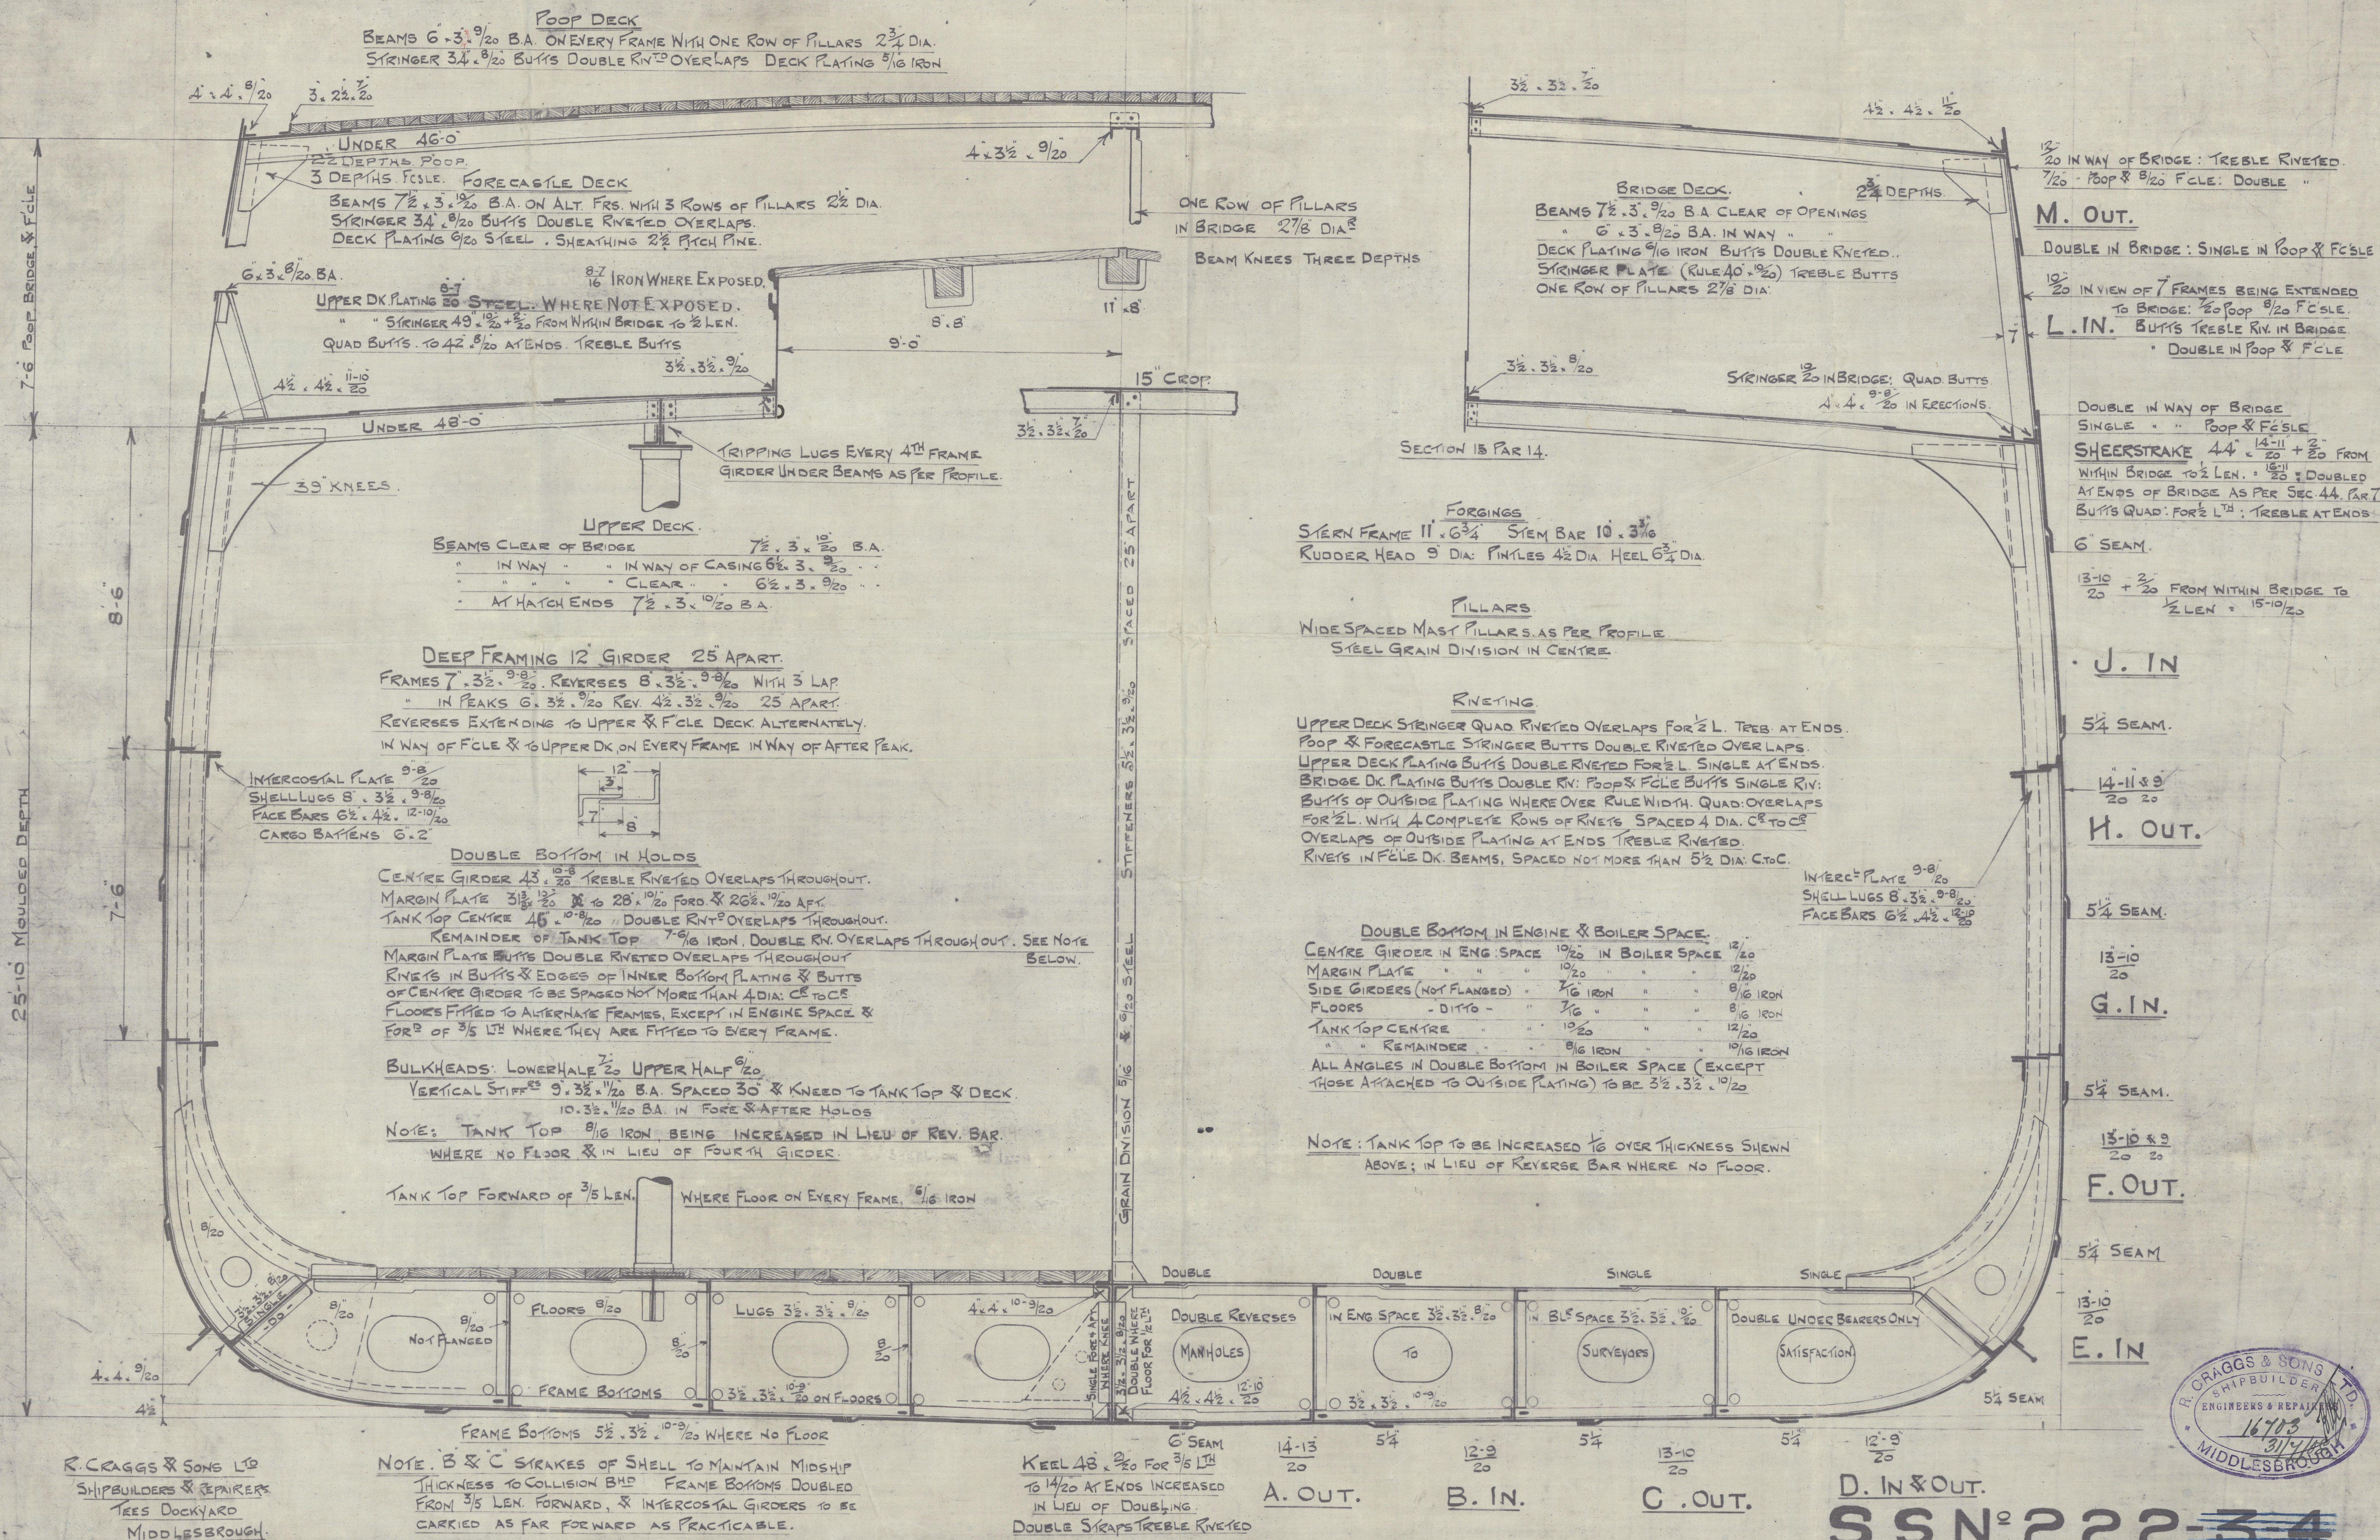

R. CRAGGS & SONS LTD
SHIPBUILDERS & REPAIRERS
TEES DOCKYARD
MIDDLESBROUGH.

R. CRAGGS & SONS
SHIPBUILDER
ENGINEERS & REPAIRERS LTD.
16703
31/7/1906
MIDDLESBROUGH

S.S. N° 222-3-4

Our Stamp
15/8/08
Lloyd's Register
Foundation
W914-0161

R. Craggs Sons
Sp No 222

Midship Section
of
vessel as built-

Sp. Bricks
Mod Rpt No 5221

W914-0161



© 2020

Lloyd's Register
Foundation