



30.10.08

NAAML. VENNOOTSCHAP.

WERF J. H. RYKÉE & CO.

ROTTERDAM.

Screw Steamer No 133.

to build of steel.

to class 100 AI at Lloyds.

Scale 1/8 inch to the foot.

Midship section

Scale = 1/2 an inch to the foot.

Scantlings


67.30 for table S 1
13.79 for tables S 2, S 3, S 4, S 5, S 7
Beam 34.0 for table S 4
Proportion of length to depth 12.91
" " " " Breadth 6.69


Dimensions

Length between p p 230.0
Breadth 34.4
Depth at side 17.11
" amidship 17.93
Girth of 1/2 midship frame 32.4

Anchors cables and pawes

2 stockless anchors 28 cwt each
1 " " 24 " "
1 stream excel stock 7 " "
1 kedge 4 " "
240 fathoms 1 1/2" steel chain cables
120 " 4" steel wire } as per Owners
4 x 90 " 2 1/2" " } specification
4 x 90 " 5 1/2" Manila


 


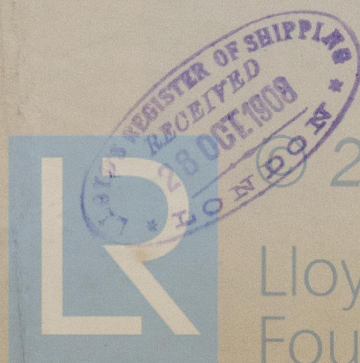

2020

Lloyd's Register
Foundation

Ryke's 133

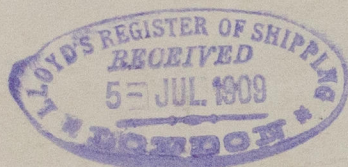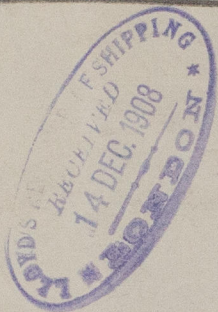

General Plan.

V.P. Duisland.

Port. of. Rotterdam.

Report. No. 6162^a

RETAIN



© 2020

Lloyd's Register
Foundation

W913-0105