

7.12.08.
15.12.08.
4.1.09



PROFILE & DECK PLAN

STEEL SCREW TRAWLER

Nº 451

DIM^S 165'-0" B.P. x 26'-0" EX x 14'-11" DEPTH MLD

SCALE $\frac{1}{4}$ " = 1 FOOT.

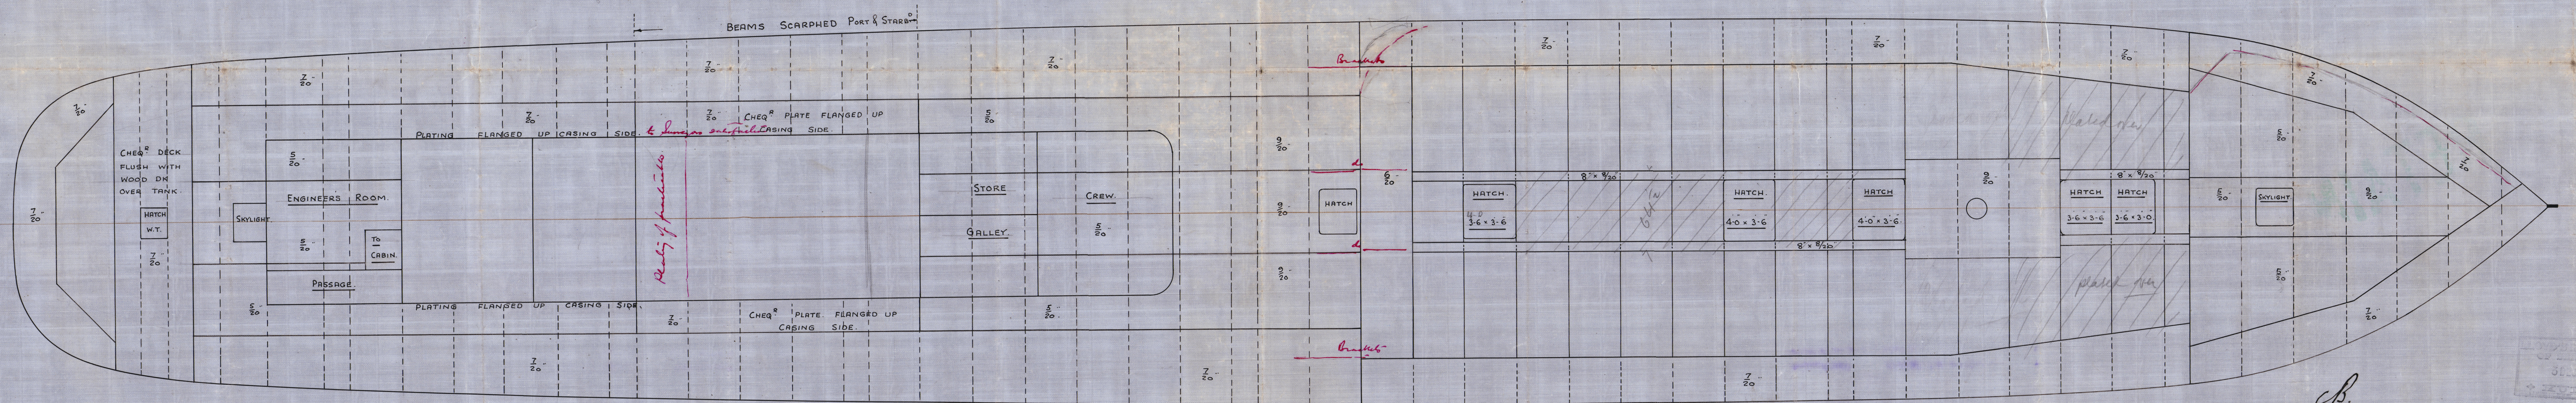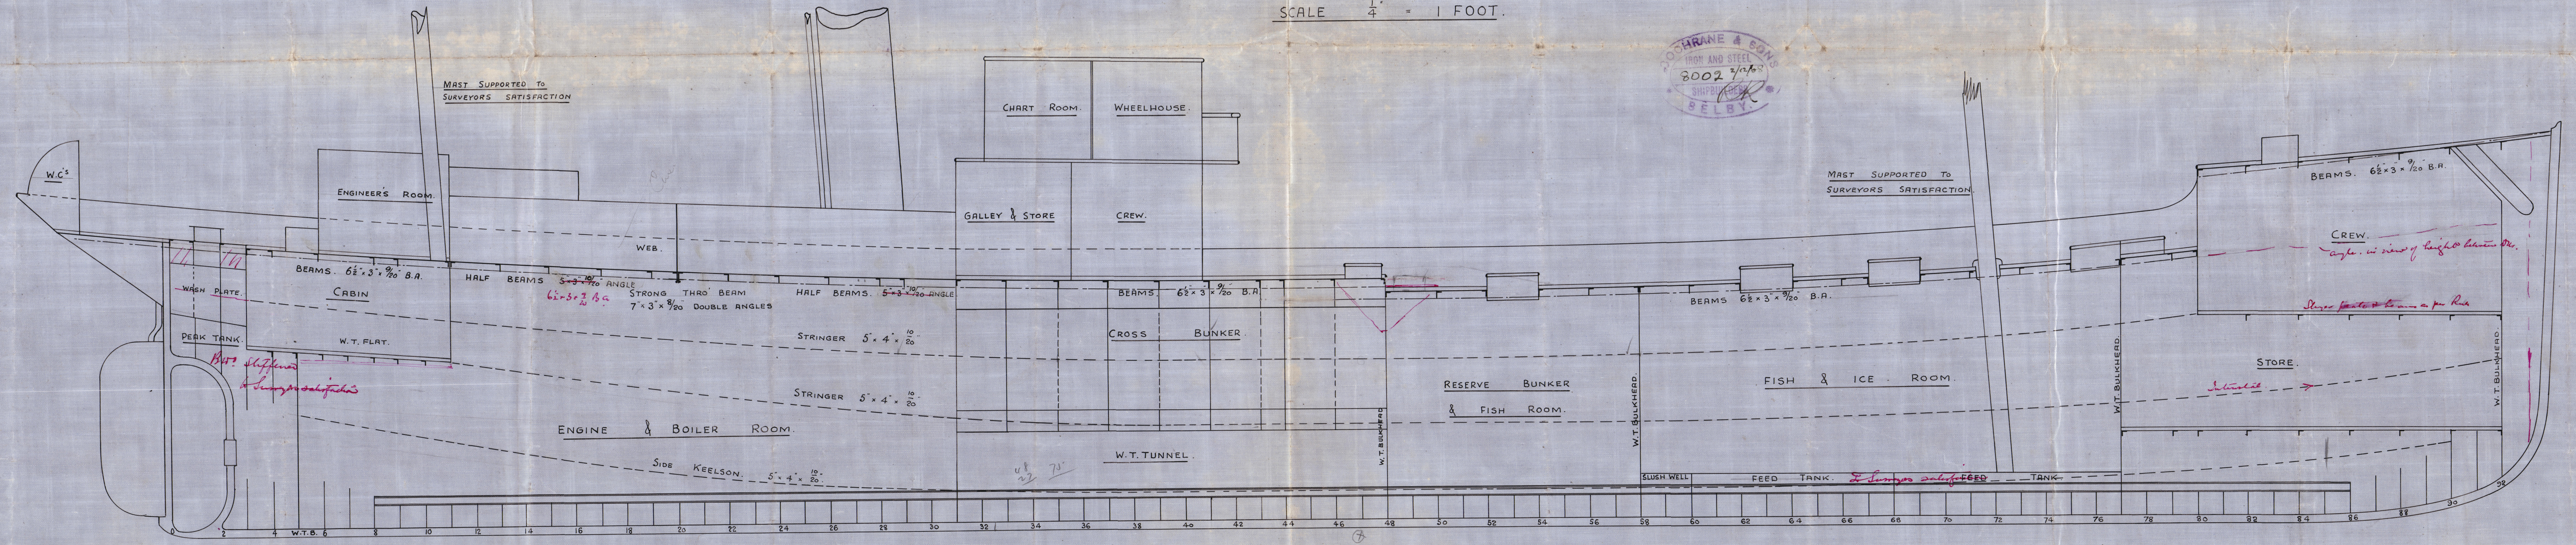

PILLARS TO SURVEYORS SATISFACTION.

EX-1072 001 1001-2


RECEIVED
2 JAN 1909
LLOYD'S REGISTER OF SHIPPING

Cochrane & Sons
No. 451.

Profile & Deck Plan
s/s Canada
Hull Report No-21.153

21.15.22
S.P.

RECEIVED
17 JAN 1909
LLOYD'S REGISTER OF SHIPPING

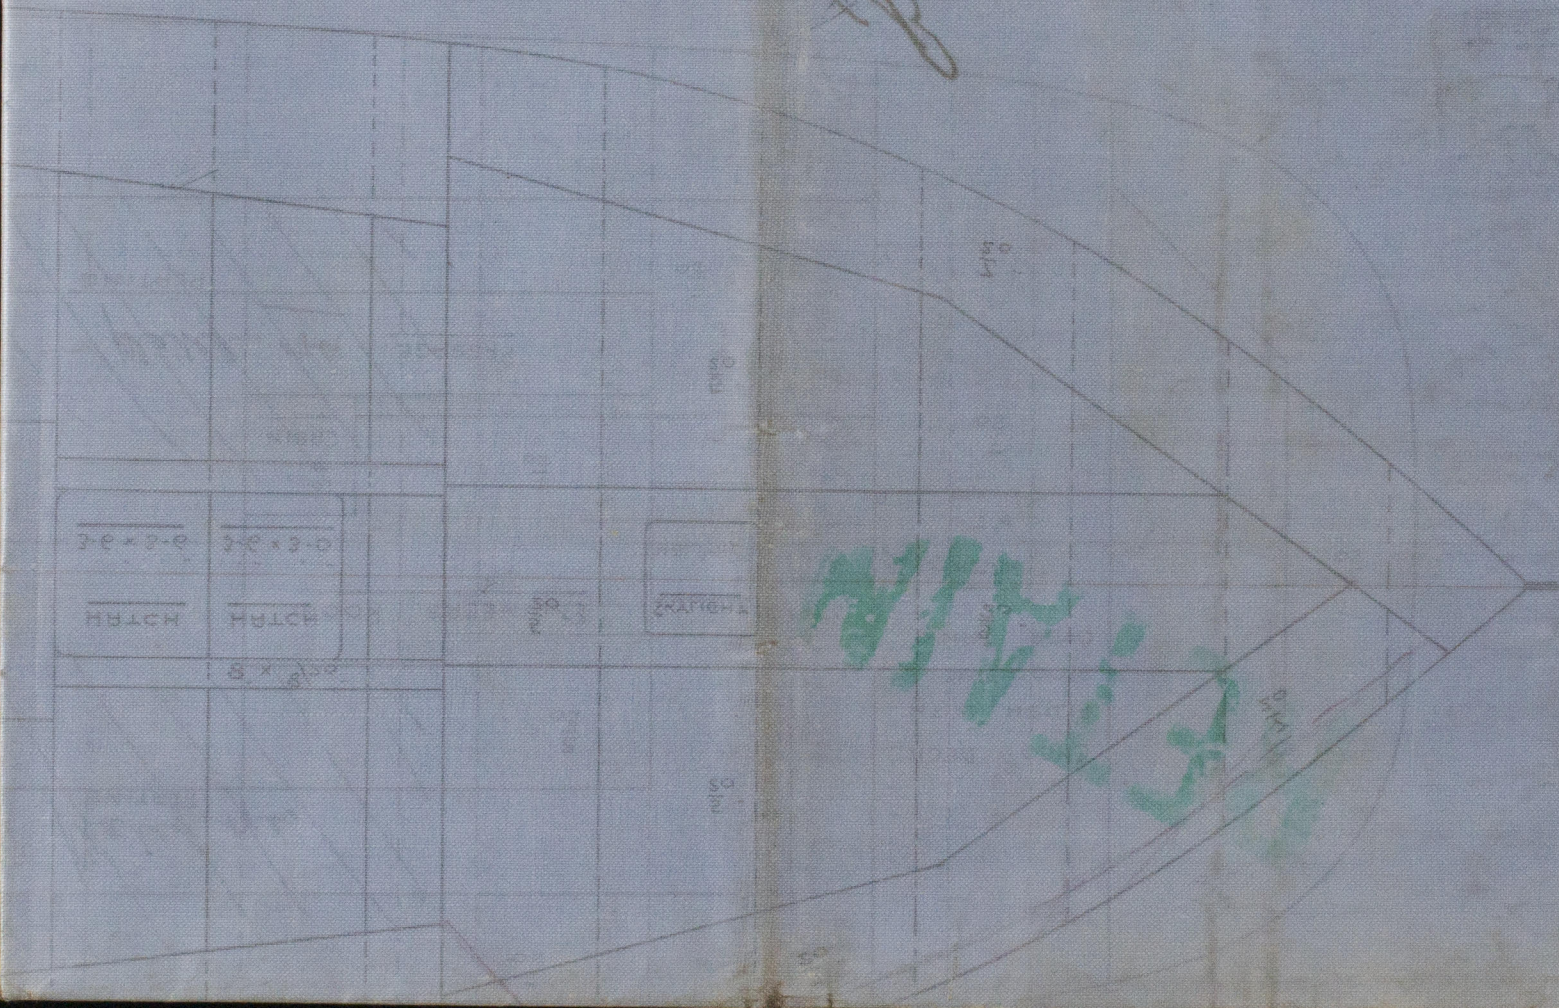

© 2020

Lloyd's Register
Foundation

W918-0088