

W. 83
5
LONDON

Horizontal Multitubular Steel Boiler 10'-3" diameter by 9'-6" long. 90 lbs W. T.


To pass Lloyd's Survey.

For Messrs Short Brothers. Sunderland = 5/6 3/4.

Scale 1" = 1 foot.

Boiler No 3265.

April 1903.

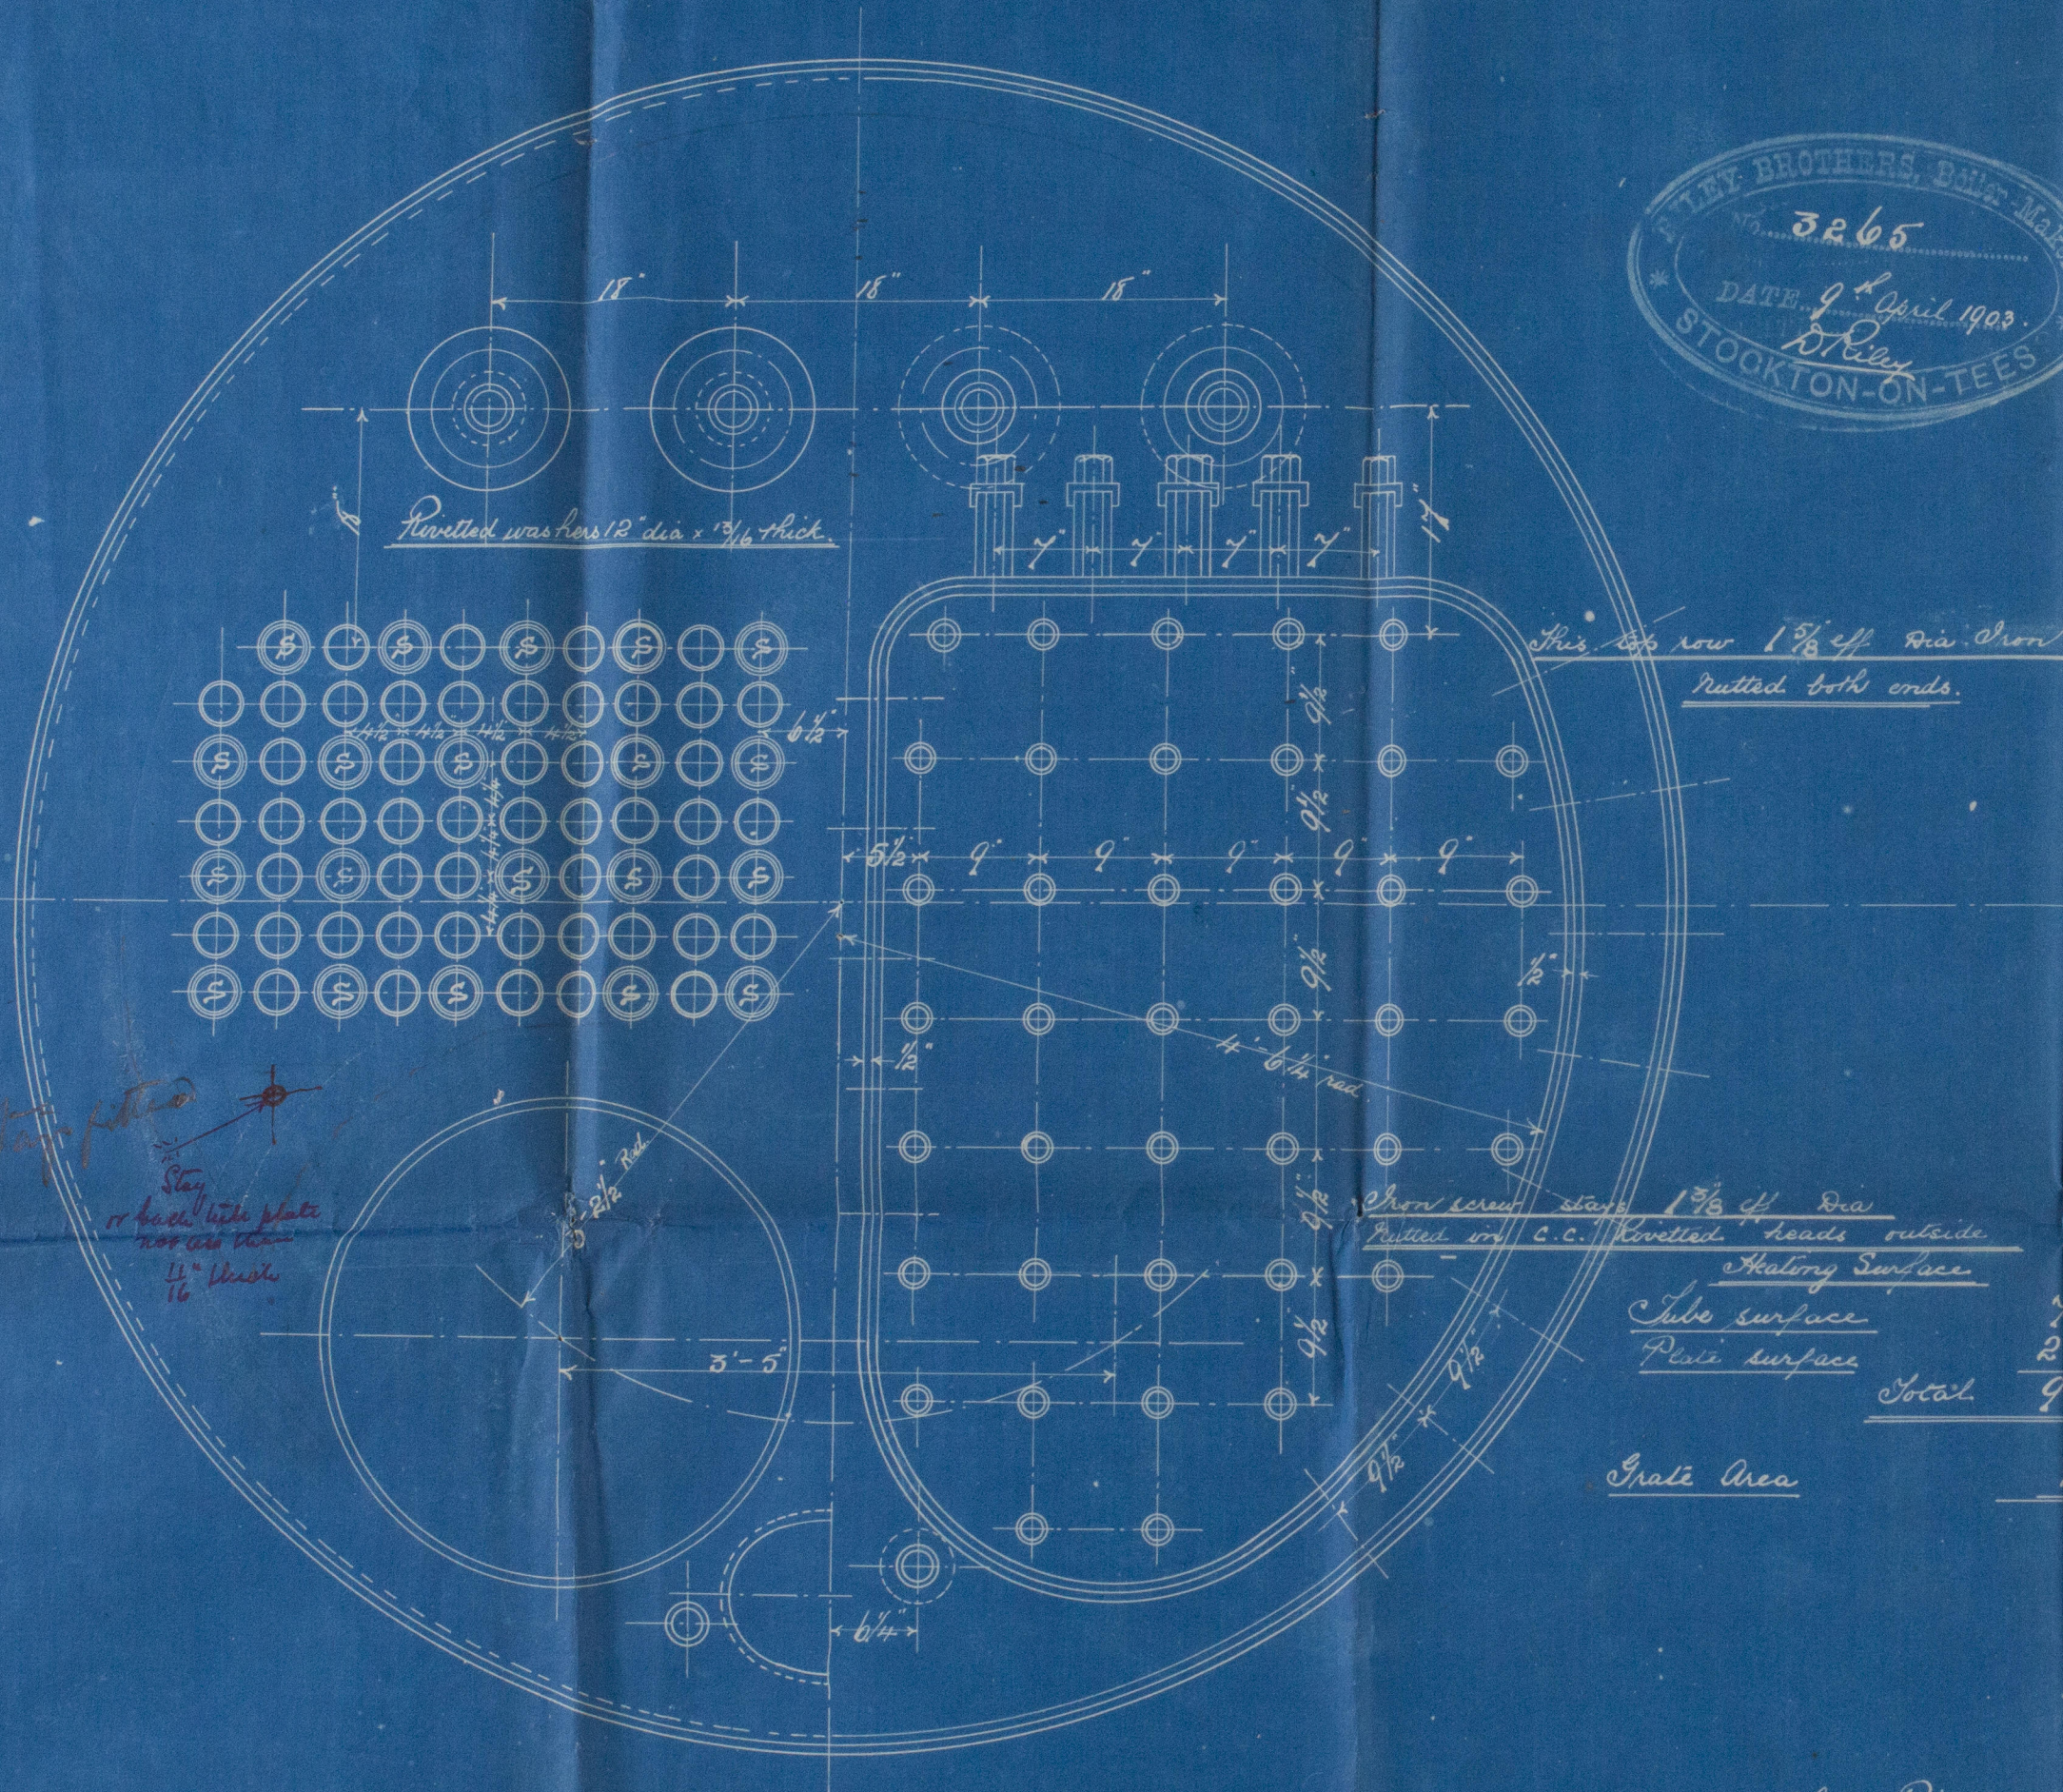

Tube surface	752.75 sq ft.
Plate surface	200.75 "
Total	953.50

Gross Area 26.10

Shell Rivetting.


Steel plates & steel rivets.

Plates not less than 28 tons tensile.

All holes drilled in position after bonding.

Longitudinal seams lap joint tube rivetted 5/16 holes 3 3/8 pitch. Lap 6 1/2.

Circumferential seams lap joint double rivetted 5/16 holes 3 1/4 pitch. Lap 4 3/4.

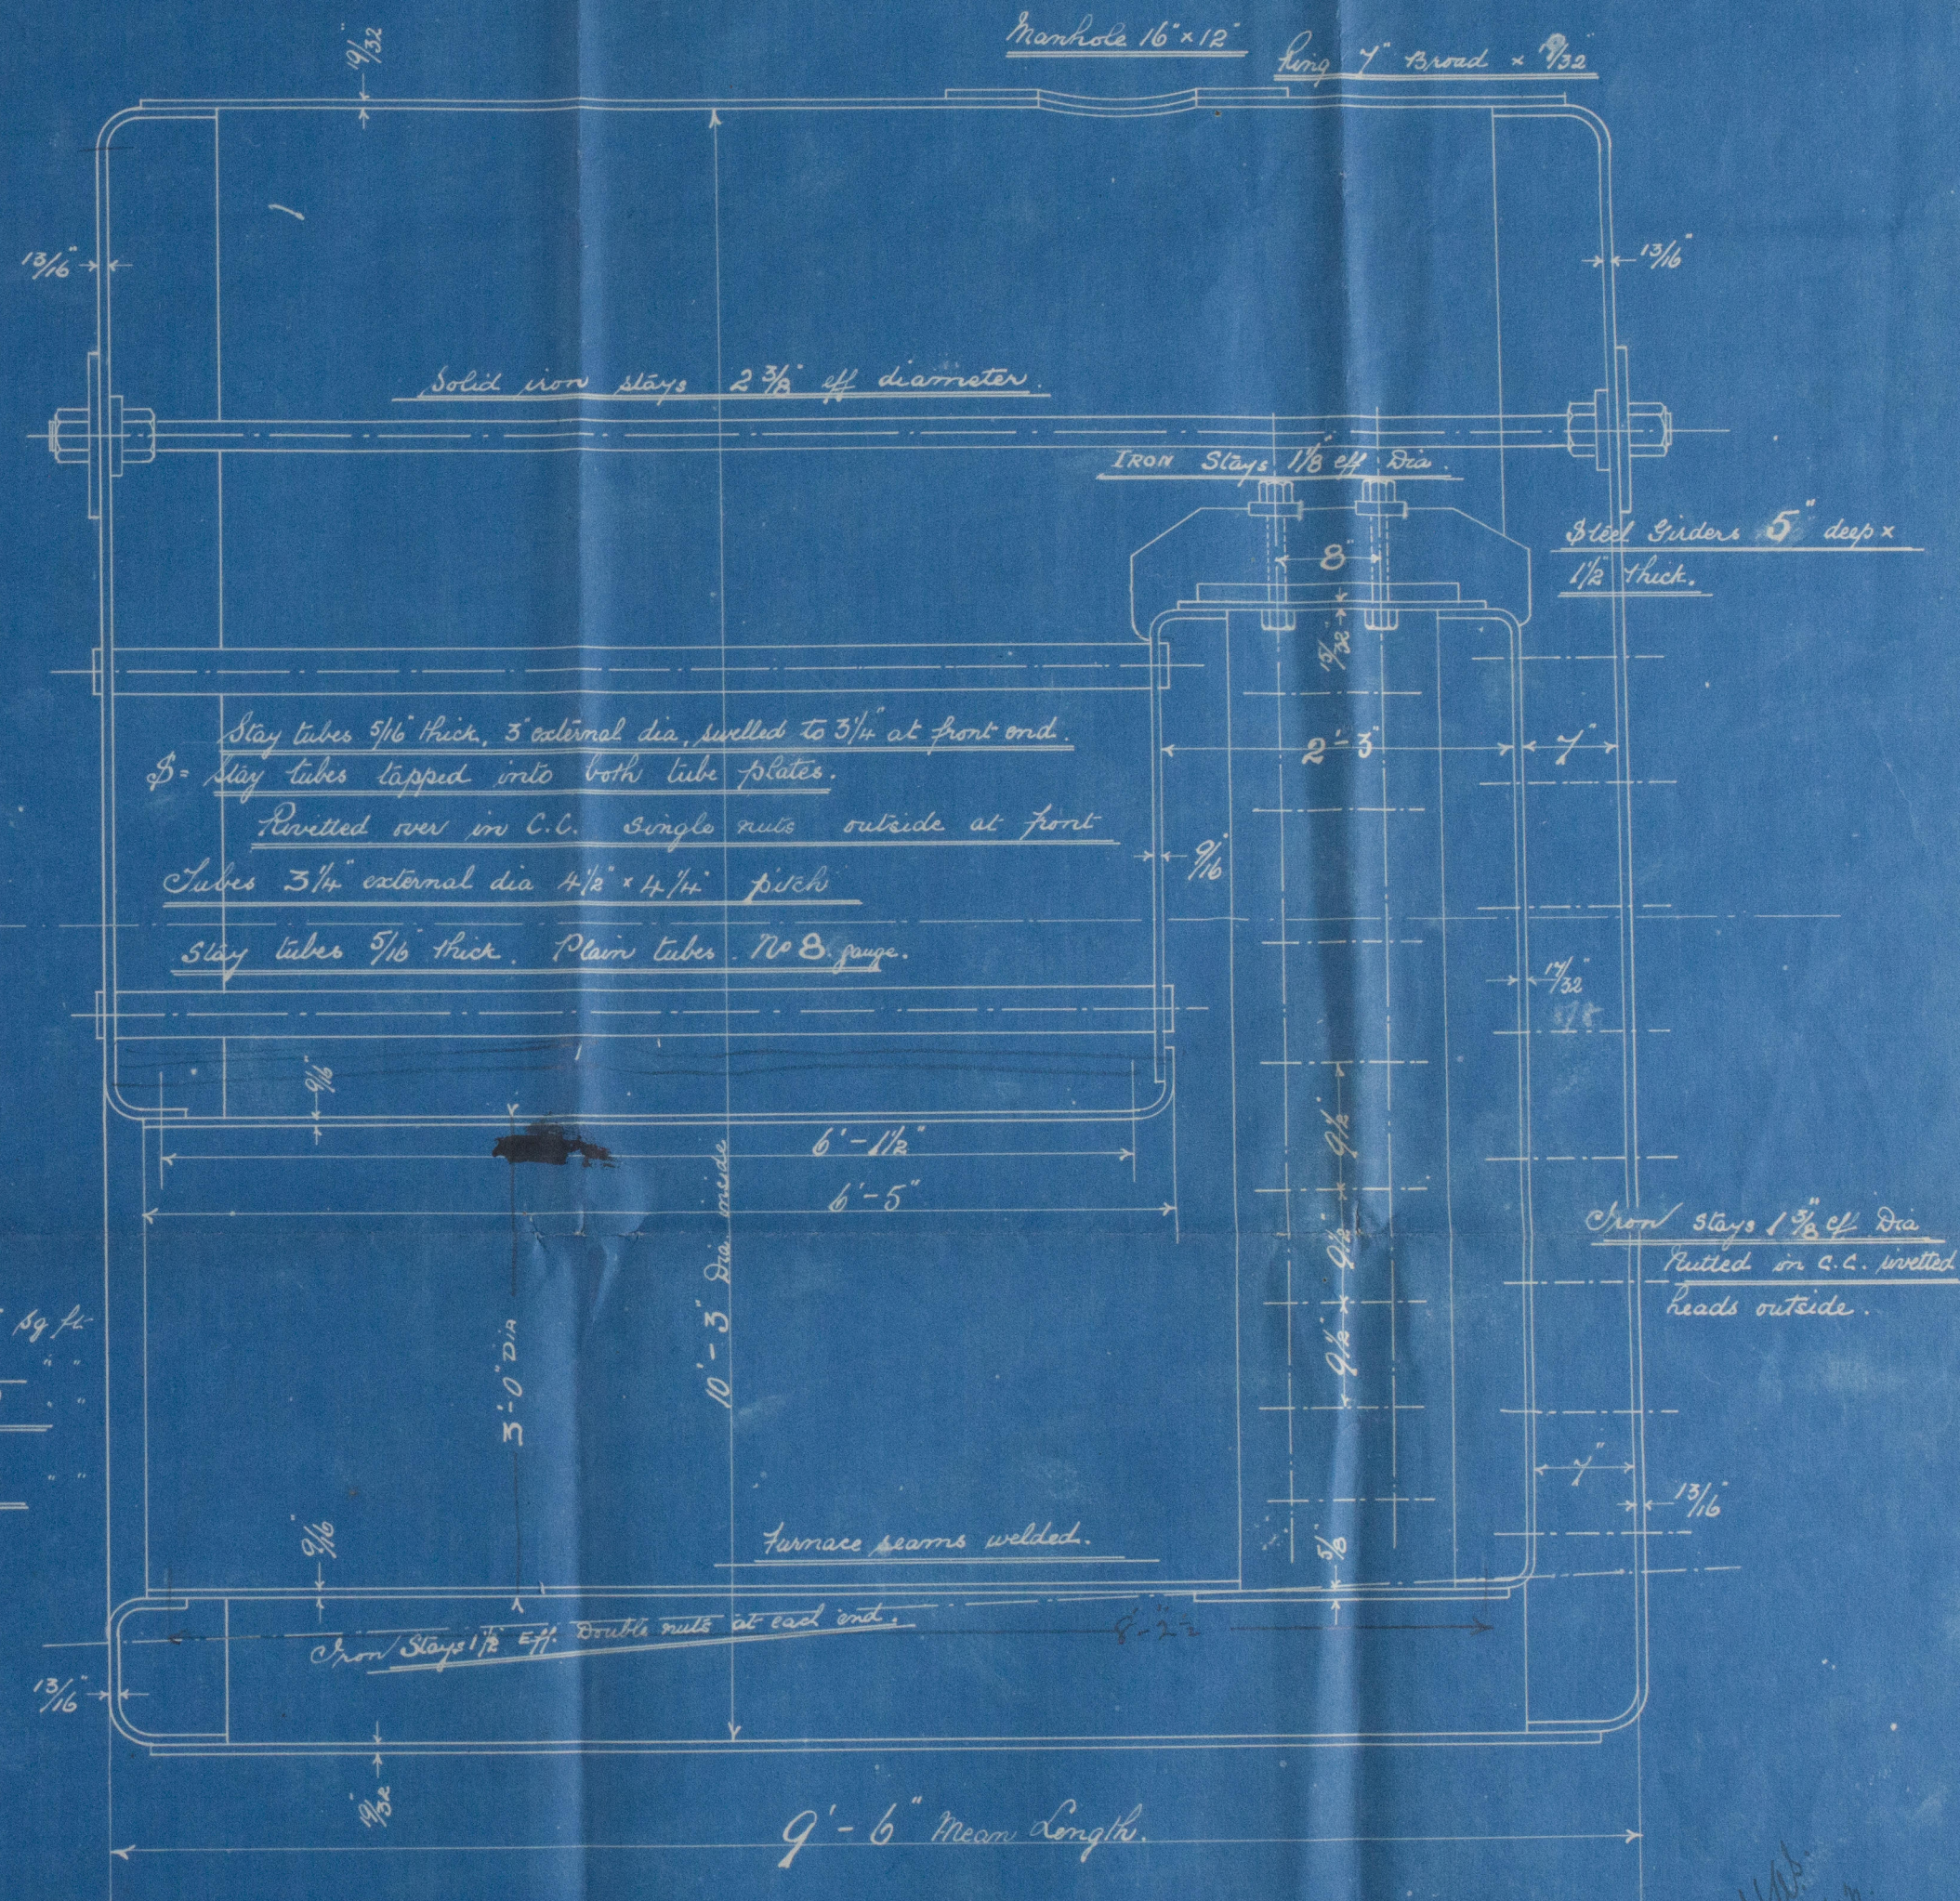

5.5.03
R

© 2020


Lloyd's Register Foundation

Misses Riley Bros
3765
No 3265

Misses Short Bros
S.S. No 314.

10-3 x 9'-6" W.P. 90lb.

Also No 3288

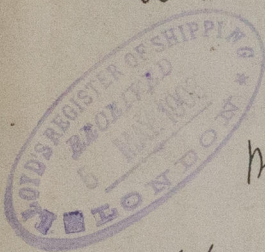

Misses Webster + Barradough

Misses Prestman & Co. No 100

Sp/2 'Clifton'
Indt report No 3444
Std. J.C. No. 21708.

REMAINDER



© 2020

Lloyd's Register
Foundation