



28.7.03  
3.10.03

— PROFILE S.S. N° 314 —  
SCALE 1" = ONE FOOT.

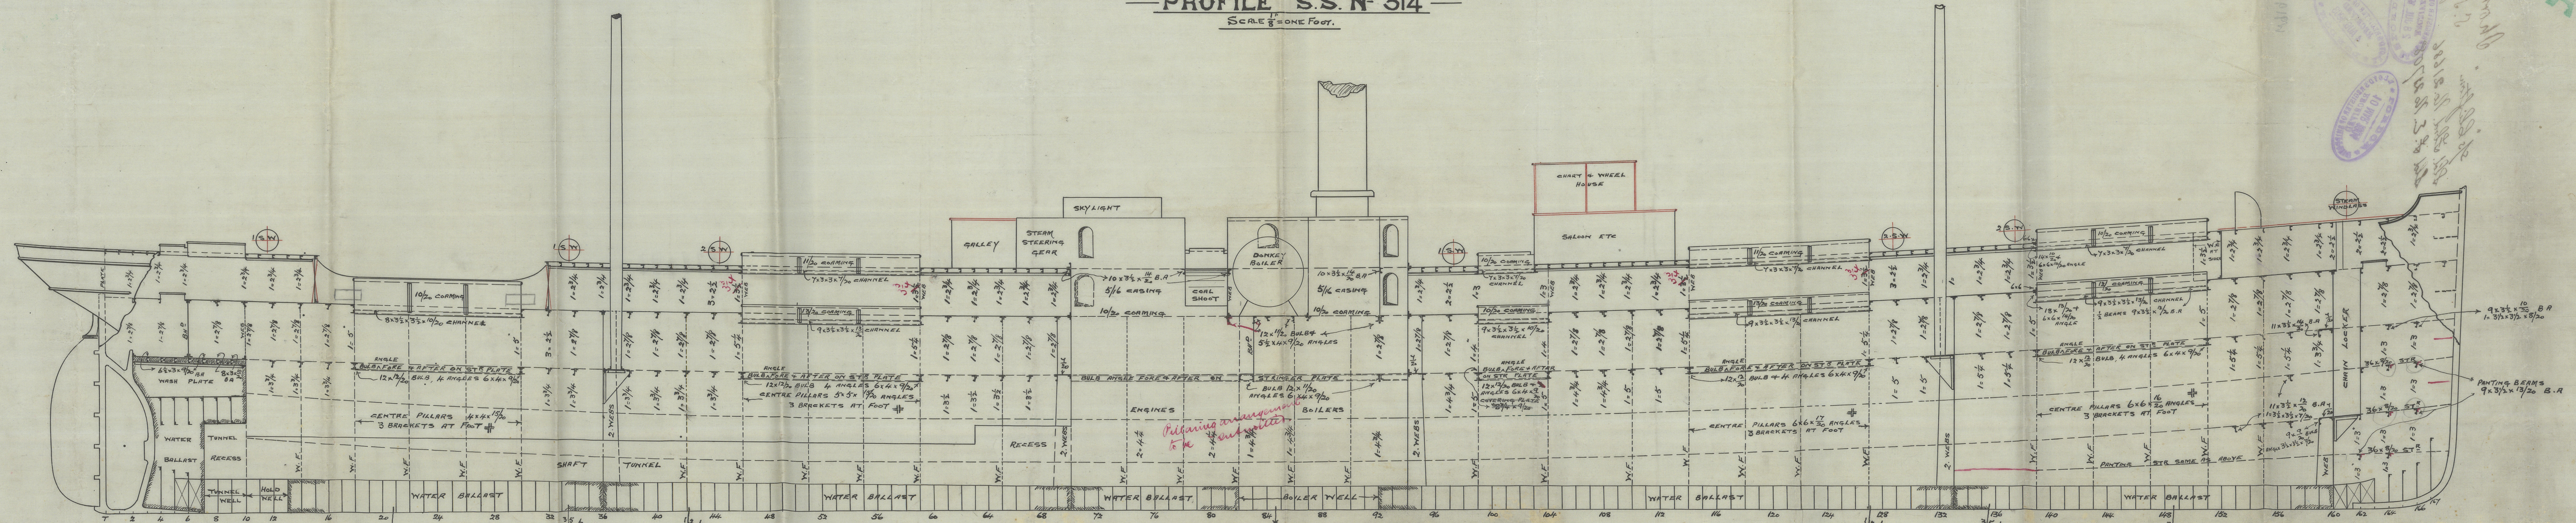

note through frames  
splitting bottom  
apart.

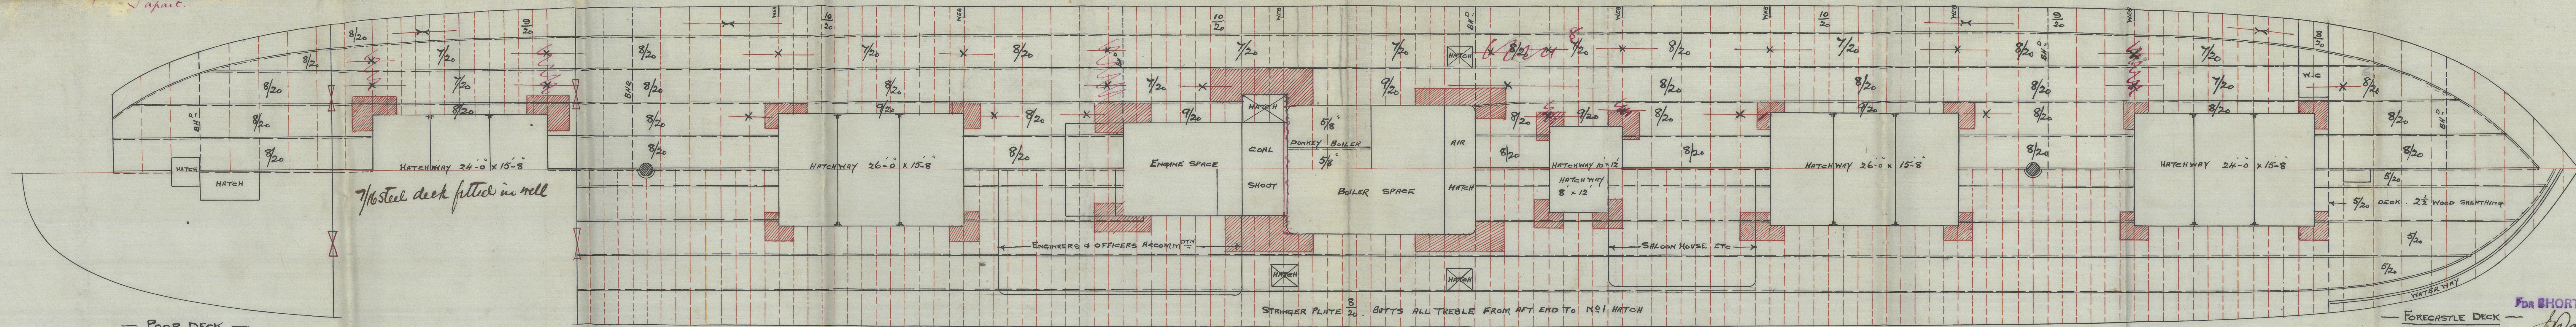

POOP DECK

BRIDGE DECK PLAN

FORECASTLE DECK  
For SHOROT BROTHERS, LIMITED.  
24/7/03




PLAN N° 9303

BRIDGE DECK PLATING ALL 16 IN OR 20 STEEL BUTTS SINGLE OVERLAP

act  
27-7-03



*sp. "Blifton"*  
 S. S. No 314  
 Profile  
 Sld. Libd. No. 21686  
 Sld. F. E. No 21708

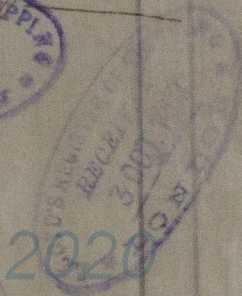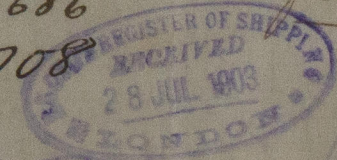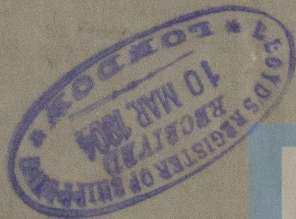

© 2020

Lloyd's Register  
Foundation

W919-012