


SHEWING MODIFIED POSITION OF BULKHEADS, AND BUILT FLOORS  
AND RE-ARRANGEMENT OF HATCH ENDS AND WIDTHS.

SCALE  $\frac{1}{8}'' = 1$  FOOT

DIMENSIONS:- 405'-0" B.P. x 54'-6" B.M. x 27'-8" D.M. TO SECOND DECK  
x 36'-2" D.M. TO UPPER DECK

MASTS, WINDLASS, WINCHES & STEERING GEAR TO BE  
SUPPORTED TO SURVEYORS SATISFACTION.

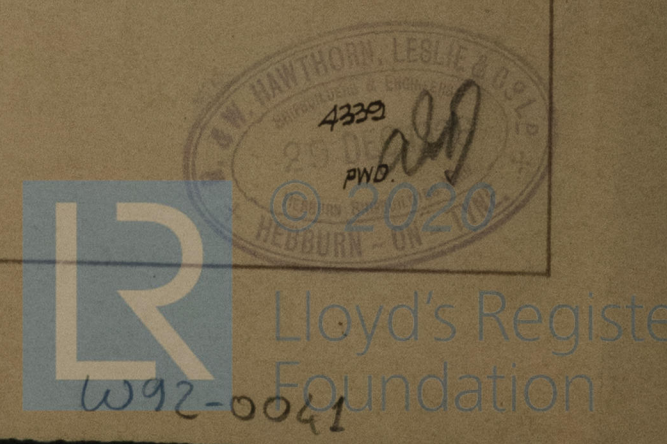



ENCLOSURE TO

31/02832.

FROM R. & W. HAWTHORN, LESLIE & CO. LTD.,  
HEBBURN-ON-TYNE.

W 92-0041



5

Hawthorn Leslie's

546

Profile & deck plans (2<sup>nd</sup> submission)

S. S. "TRELAWNY"  
NEWCASTLE ON TYNE.

Drawn by 81827.

W92-0041



© 2020

Lloyd's Register  
Foundation