


DIMS 130'-0" BP x 23'-6" EXT x 13'-6" MLD
SCALE 1/4" INCH

SHIPBUILDERS, SELBY
DATE 3/3/14

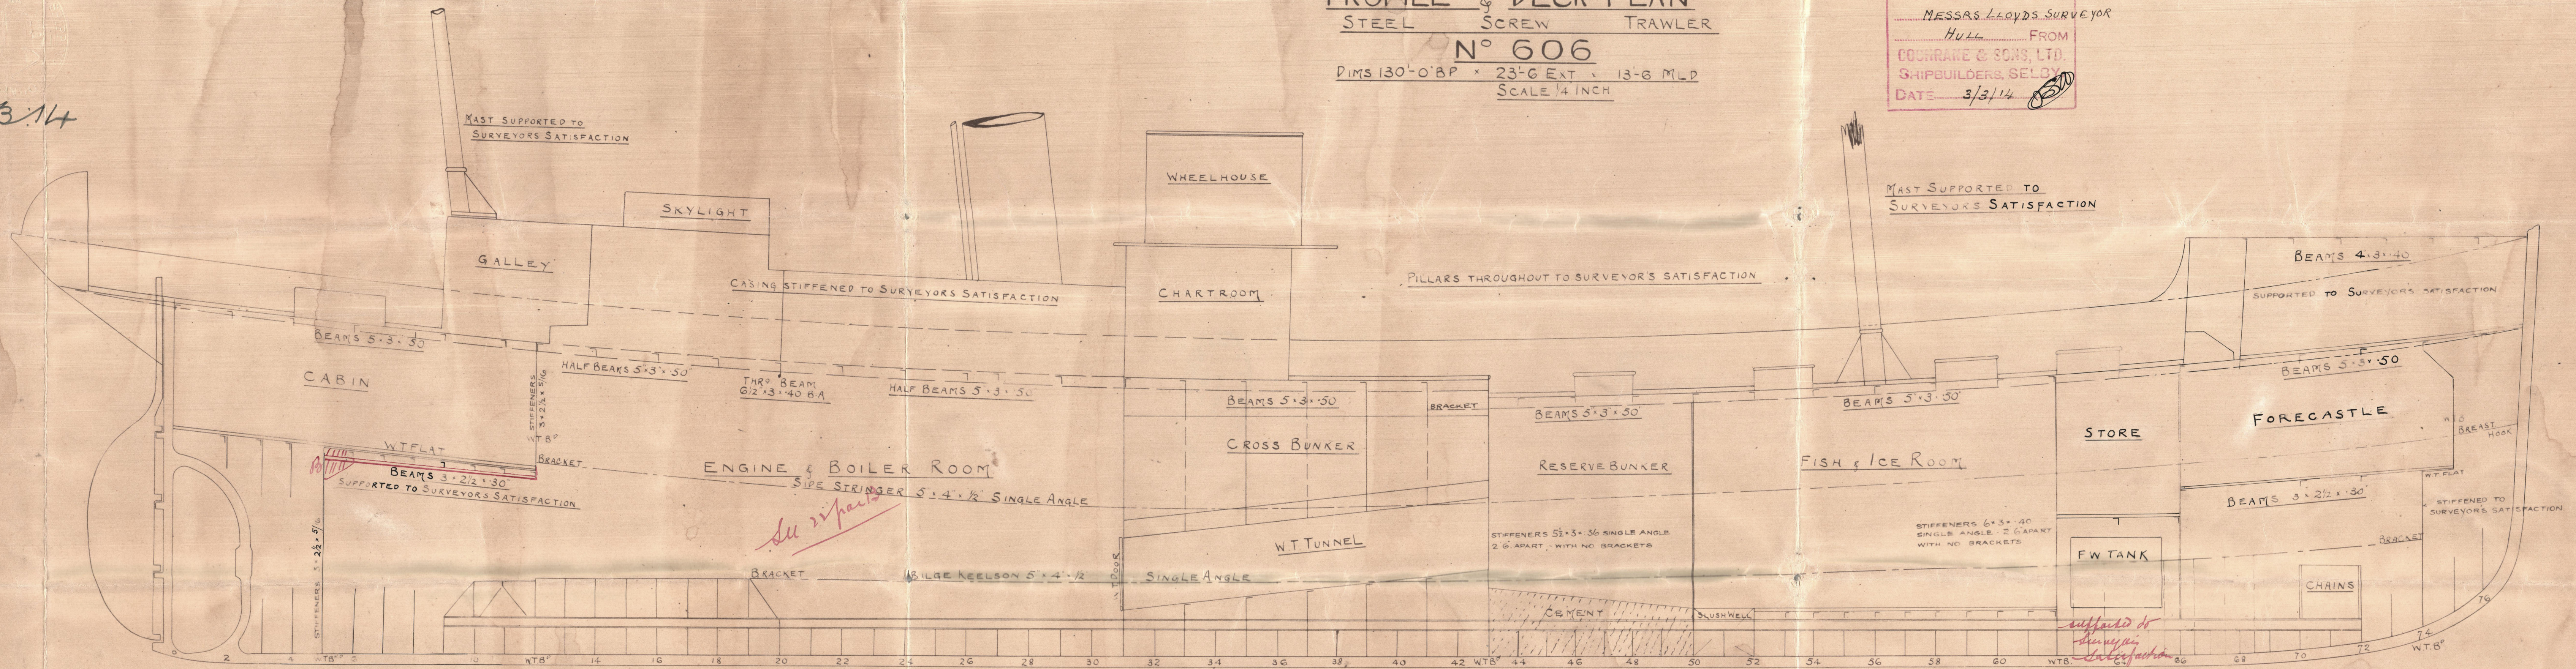


6.3.14

Cochrane & Sons
No 606.

Profile and Deck
Dimensions

130-0 x 23-38 x 13-5

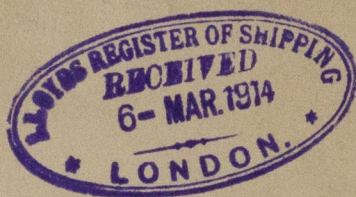

s/s Velia

Hull Rpt No. 27915

W92-0055



Lloyd's Register
Foundation