

PLAN No. 4005  
FOR ENCLOSURE TO  
MESSRS LLOYDS SURVEYOR  
6.3.14 HULL FROM  
COCHRANE & SONS, LTD.  
SHIPBUILDERS, SELDY  
DATE 27/2/14


# MIDSHIP SECTION STEEL SCREW TRAWLER

N<sup>o</sup> 606

DIMS 130'-0" BP x 23'-6" EX x 13'-6" MLD

SCALE 1/2" INCH

TO CLASS 100A1 STEAM TRAWLER DECK PLATED OVER IN WAY  
OF MACHINERY SPACE. E & B. CASING AS PREVIOUSLY APPROVED

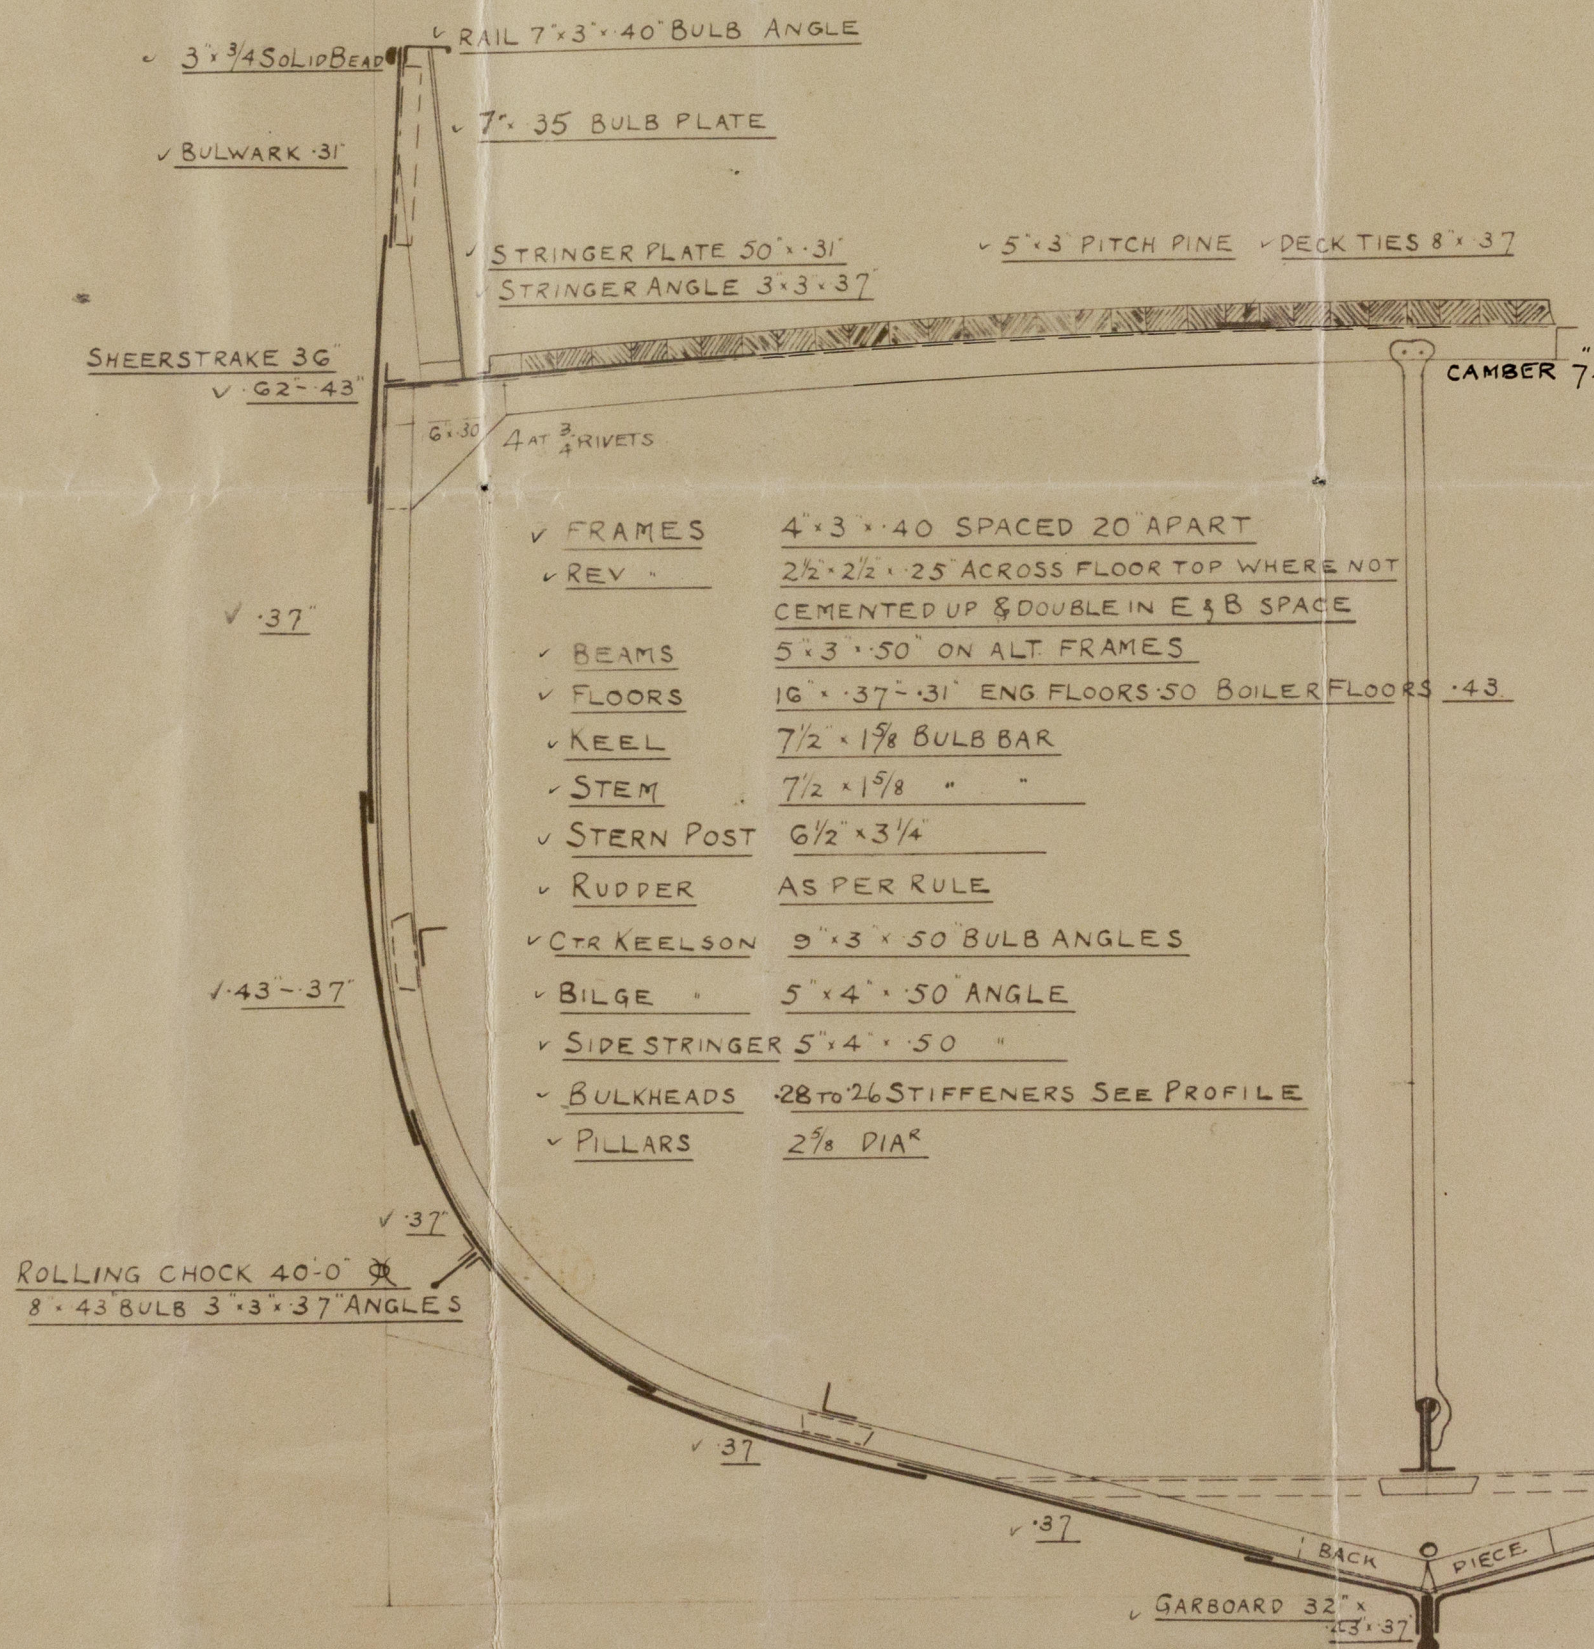

## NUMERALS

B+D — — — 36.88  
L x (B+D) — — — 4794.40

## PROPORTIONS

110 — — — 9.82  
84.0 — — — 5.56

## EQUIPMENT

1<sup>ST</sup> BOWER ANCHOR 6 CWT<sup>S</sup> E<sup>X</sup> STOCK 7 1/2 STOCKLESS  
2<sup>ND</sup> " " 5 1/2 " " 7 STOCKLESS  
KEDGE " 3 " " "  
120 FATHOMS 1 3/4" STUD LINK CABLE  
GO " 6" HAWSER  
GO " 5" WARP

## RIVETING

BUTTS OF SHELL PLATING TO BE LAPPED & DOUBLE  
RIVETTED EXCEPT GARBOARD & SHEERSTRAKE,  
WHICH ARE TO BE STRAPPED & DOUBLE RIVETED  
LANDINGS DOUBLE RIVETED BULKHEADS SINGLE RIVETED

*BBF*  
6.3.14



© 2020

Lloyd's Register  
Foundation



Cochrane & Sons

Nº 606


Midship Section.

Dimensions

130.07 23.38 x 13.5

% Vela

Hull Rpt No 27915

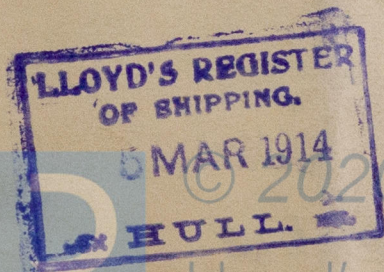

W92-0057

Lloyd's Register  
Foundation