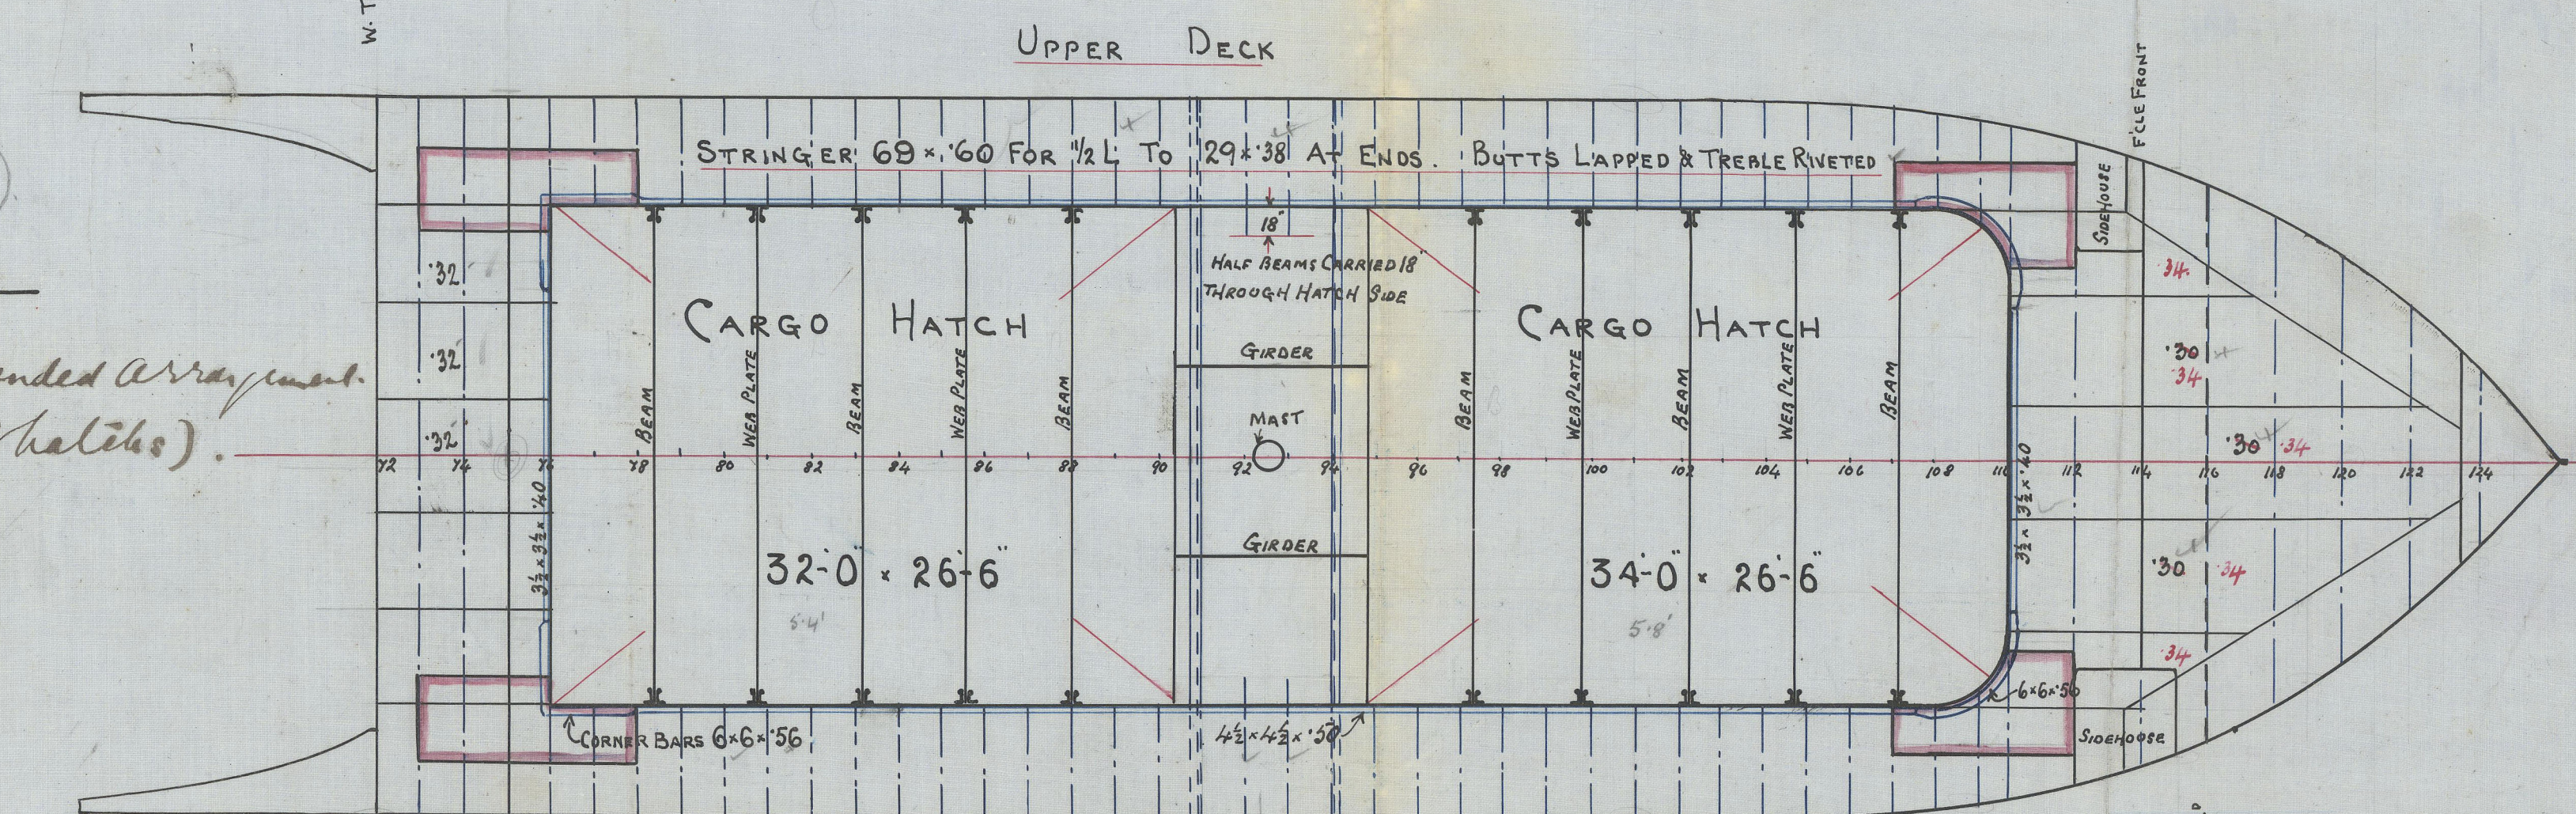
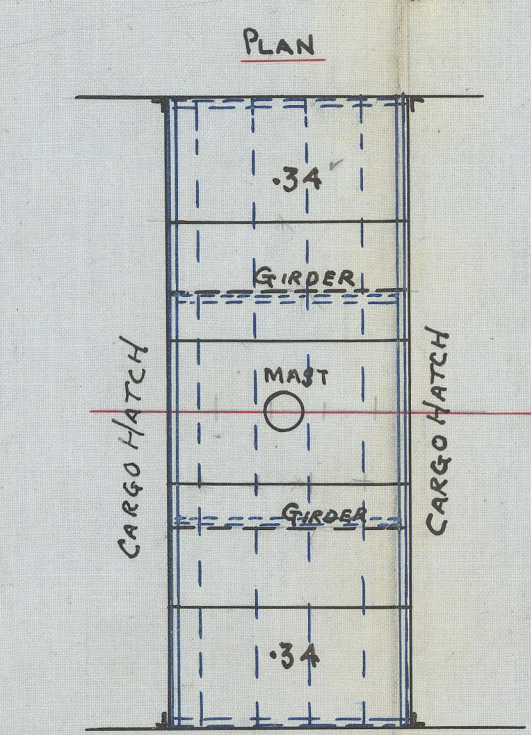
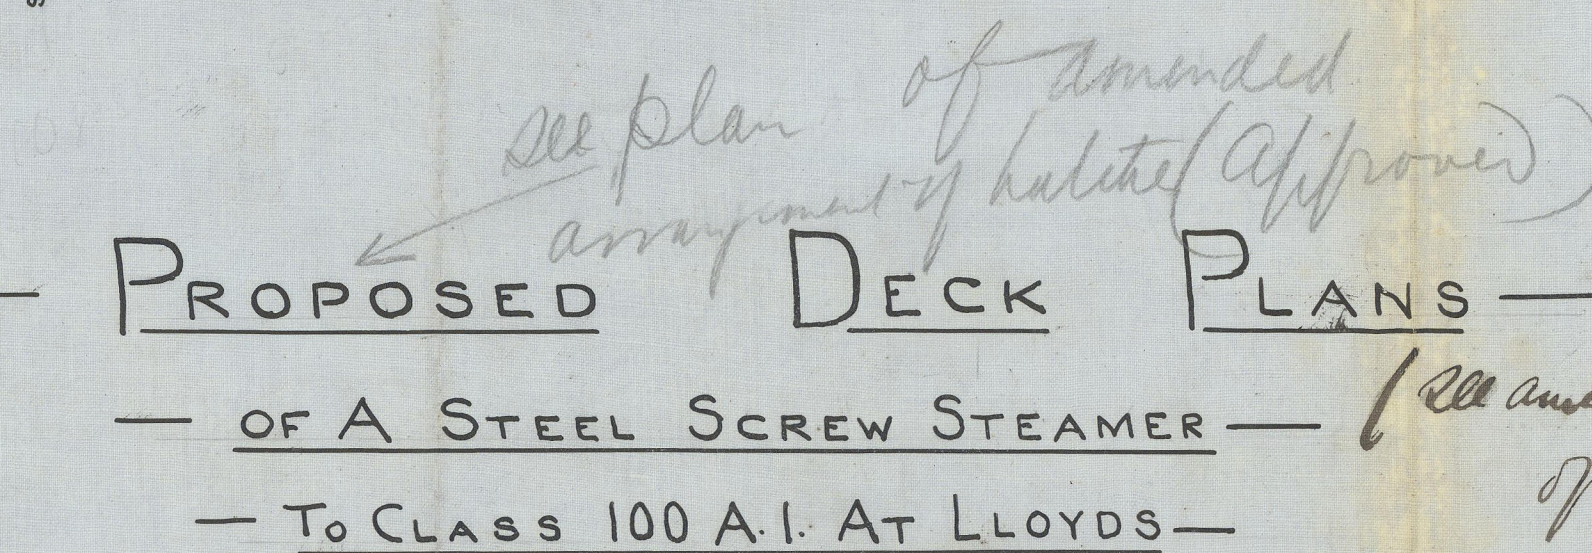
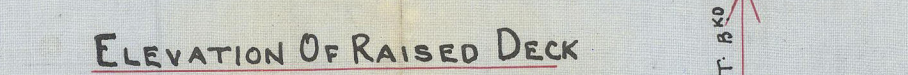
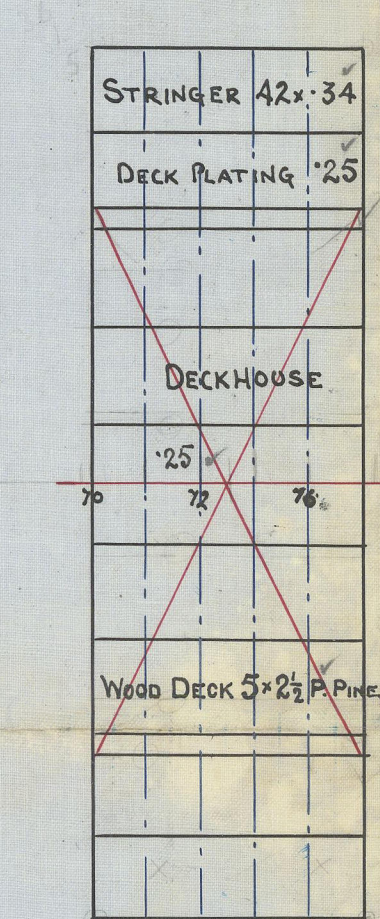
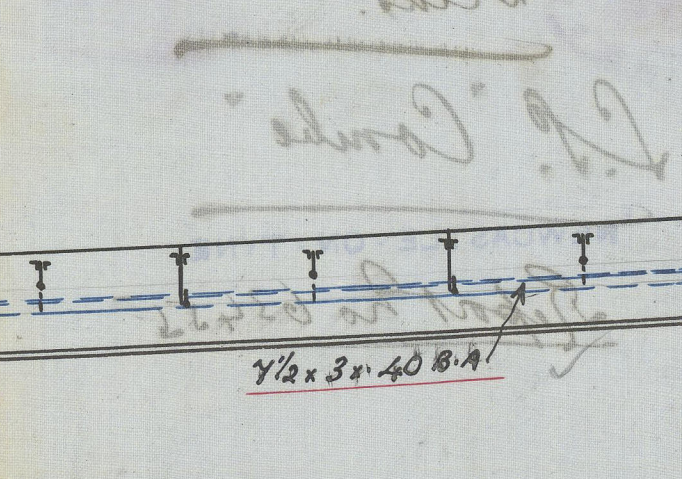


[illegible]

C.B.
19.3.12.

W922-0126

Wood Plumber's notes

Decks.

L.P. Combe

Report No 63455

WHEEL HOUSE

NEWCASTLE ON TYNE

GALLEY

FORECASTLE DECK

RETAIN



© 2021

Lloyd's Register
Foundation