



REGISTER OF SHIPS
10-3-03

PROFILE AND DECK PLAN.
S.S. "COLNE" N^o 256.
LENGTH B.P. 235'0" BREADTH M.D. 31'6" DEPTH M.D. 16'2".
CLASS 100 A.L. LLOYDS. SCALE 1/8" = 1 FOOT.

10-3-03

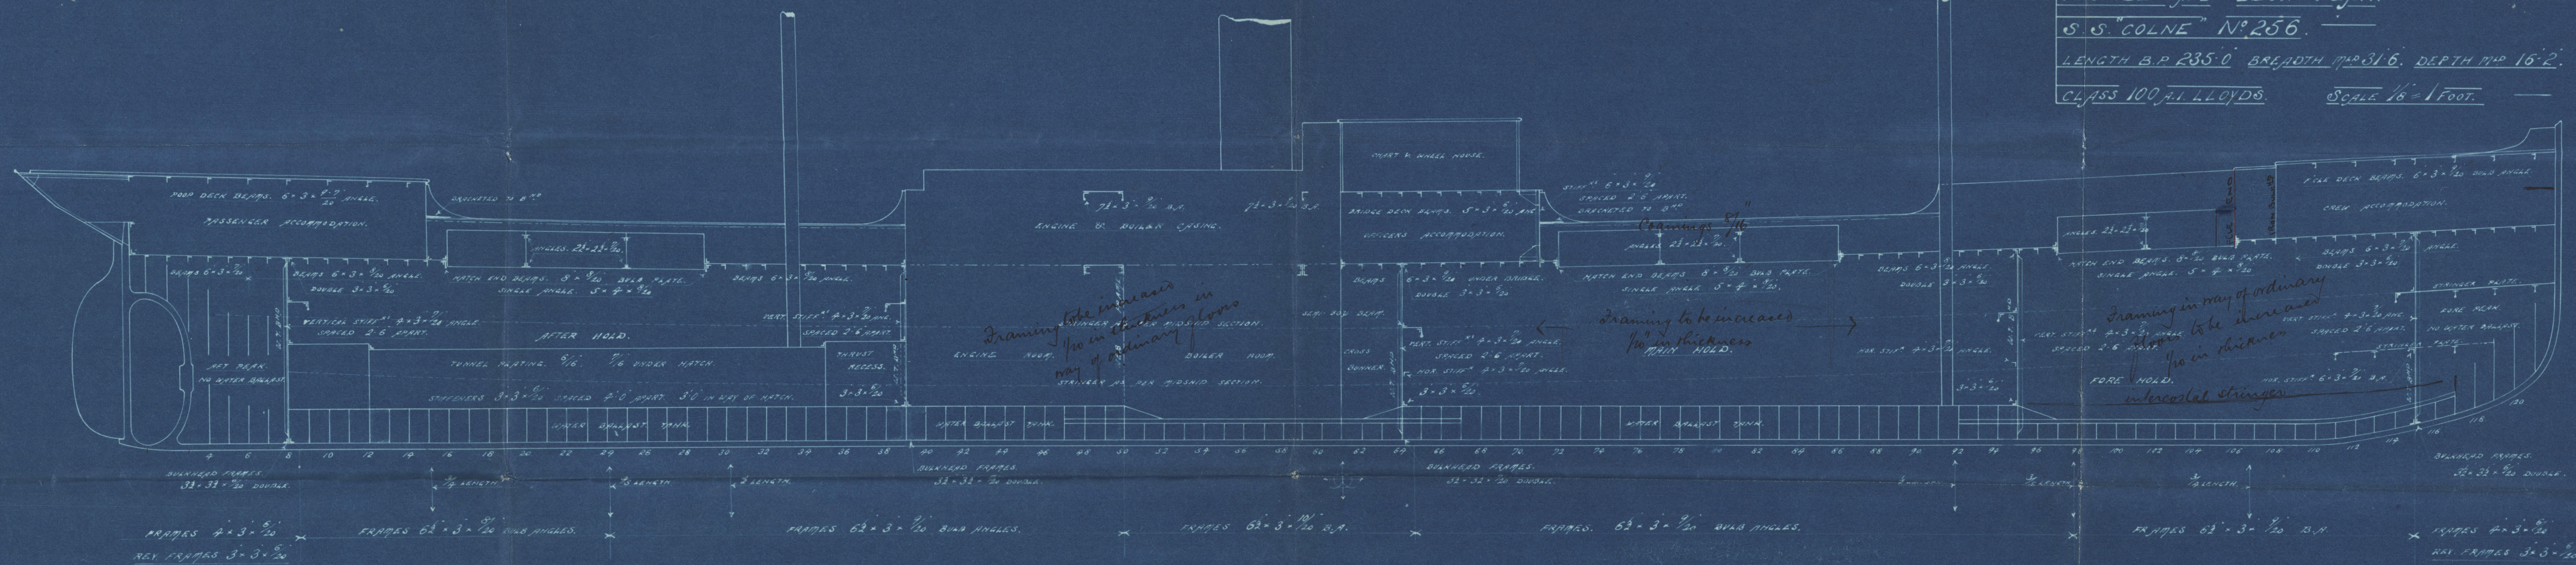

Hatchway pillars as per rules

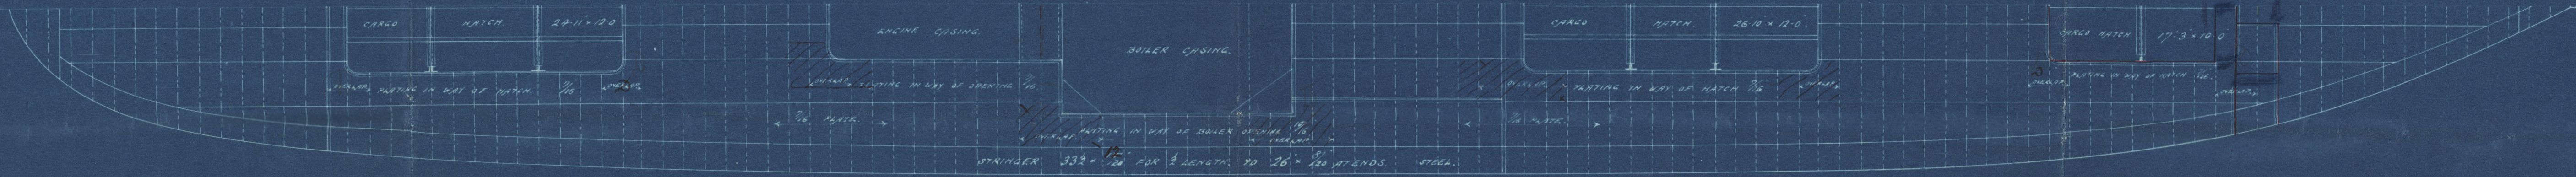

MATCH CENTRE FORE & AFTER 9' x 7' WOOD.
SIDE " " " 6' x 6' "

BUTTS OF DECK PLATING LAPPED & DOUBLED 1/4" FOR 1/2 LENGTH. BUTT AT ENDS.

DECK PLATING 8/16 IRON.


BUTTS OF MAIN DECK STRINGER LAPPED & DOUBLED 1/4" FOR 1/2 LENGTH. BUTT AT ENDS.

MATCH CENTRE FORE & AFTER 9' x 7' WOOD.
SIDE " " " 6' x 6' "

10-3-03
642
99P

W923-0203

Amended profile + deck plan
Clyde S/B & Co No 256.

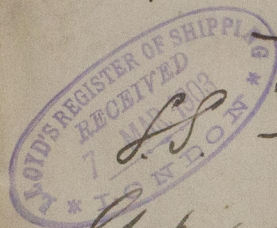


S.S. Colne

Grk report No 13723



RETAIN

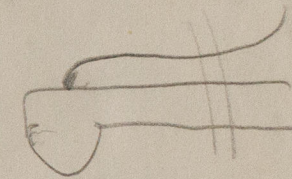

W923-0203



© 2020

Lloyd's Register
Foundation