

MIDSHIP SECTION.

SCALE $\frac{1}{2}$ " = ONE FOOT


<u>DIMENSIONS.</u>	<u>BUILDERS.</u>	<u>LYONDS.</u>
<u>LENGTH B.P.</u>	281' 6"	279' 83
<u>BREADTH EX</u>	42' 6"	42' 32
<u>DEPTH OF HOLD</u> (TO TOP OF GARDEN)	16 8 1/2"	19' 87
<u>DEPTH MOULDED</u>	19' 0"	1/2 GIRTH 37' 33
<u>Nº FOR FRAMES</u>	78' 36	1/2 BREADTH 21' 16
<u>" " PLATING</u>	2' 927' 47	<u>DEPTH</u> 19' 87
<u>" " EQUIPMENT</u>	24' 668' 40	<u>78' 36</u>
<u>DEPTH TO LENGTH</u>	14' 08	
<u>BREADTHS " "</u>	6' 61	<u>CLASS 100 A. 1</u>

EQUIPMENT No.

$$\frac{21927.47}{8} = 2740.93 + 21927.47 = 24668.40 \text{ EQUIPMENT N}^\circ$$

EQUIPMENT.

2 BOWER ANCHORS. (STOCKLESS) 40 CWT^S
 / ----- " ----- H 3 ----- 34 ----- "
 / STREAM ----- (EX STOCK) 10½
 / KEDGE ----- " ----- 5½"
 240 FATHOMS STUD CHAIN CABLE ----- 1 ^{1 3}/₁₆" DIA^R
 75 ----- " ----- STREAM CHAIN ----- 1 ²/₁₆" (OR 4 ¼" STEEL WIRE)
 90 ----- " ----- OF 12^s TOWLINE (OR 4" STEEL WIRE)
 90 ----- " ----- 7" WARP (2 OFF)
 90 ----- " ----- G" ----- (2 OFF)

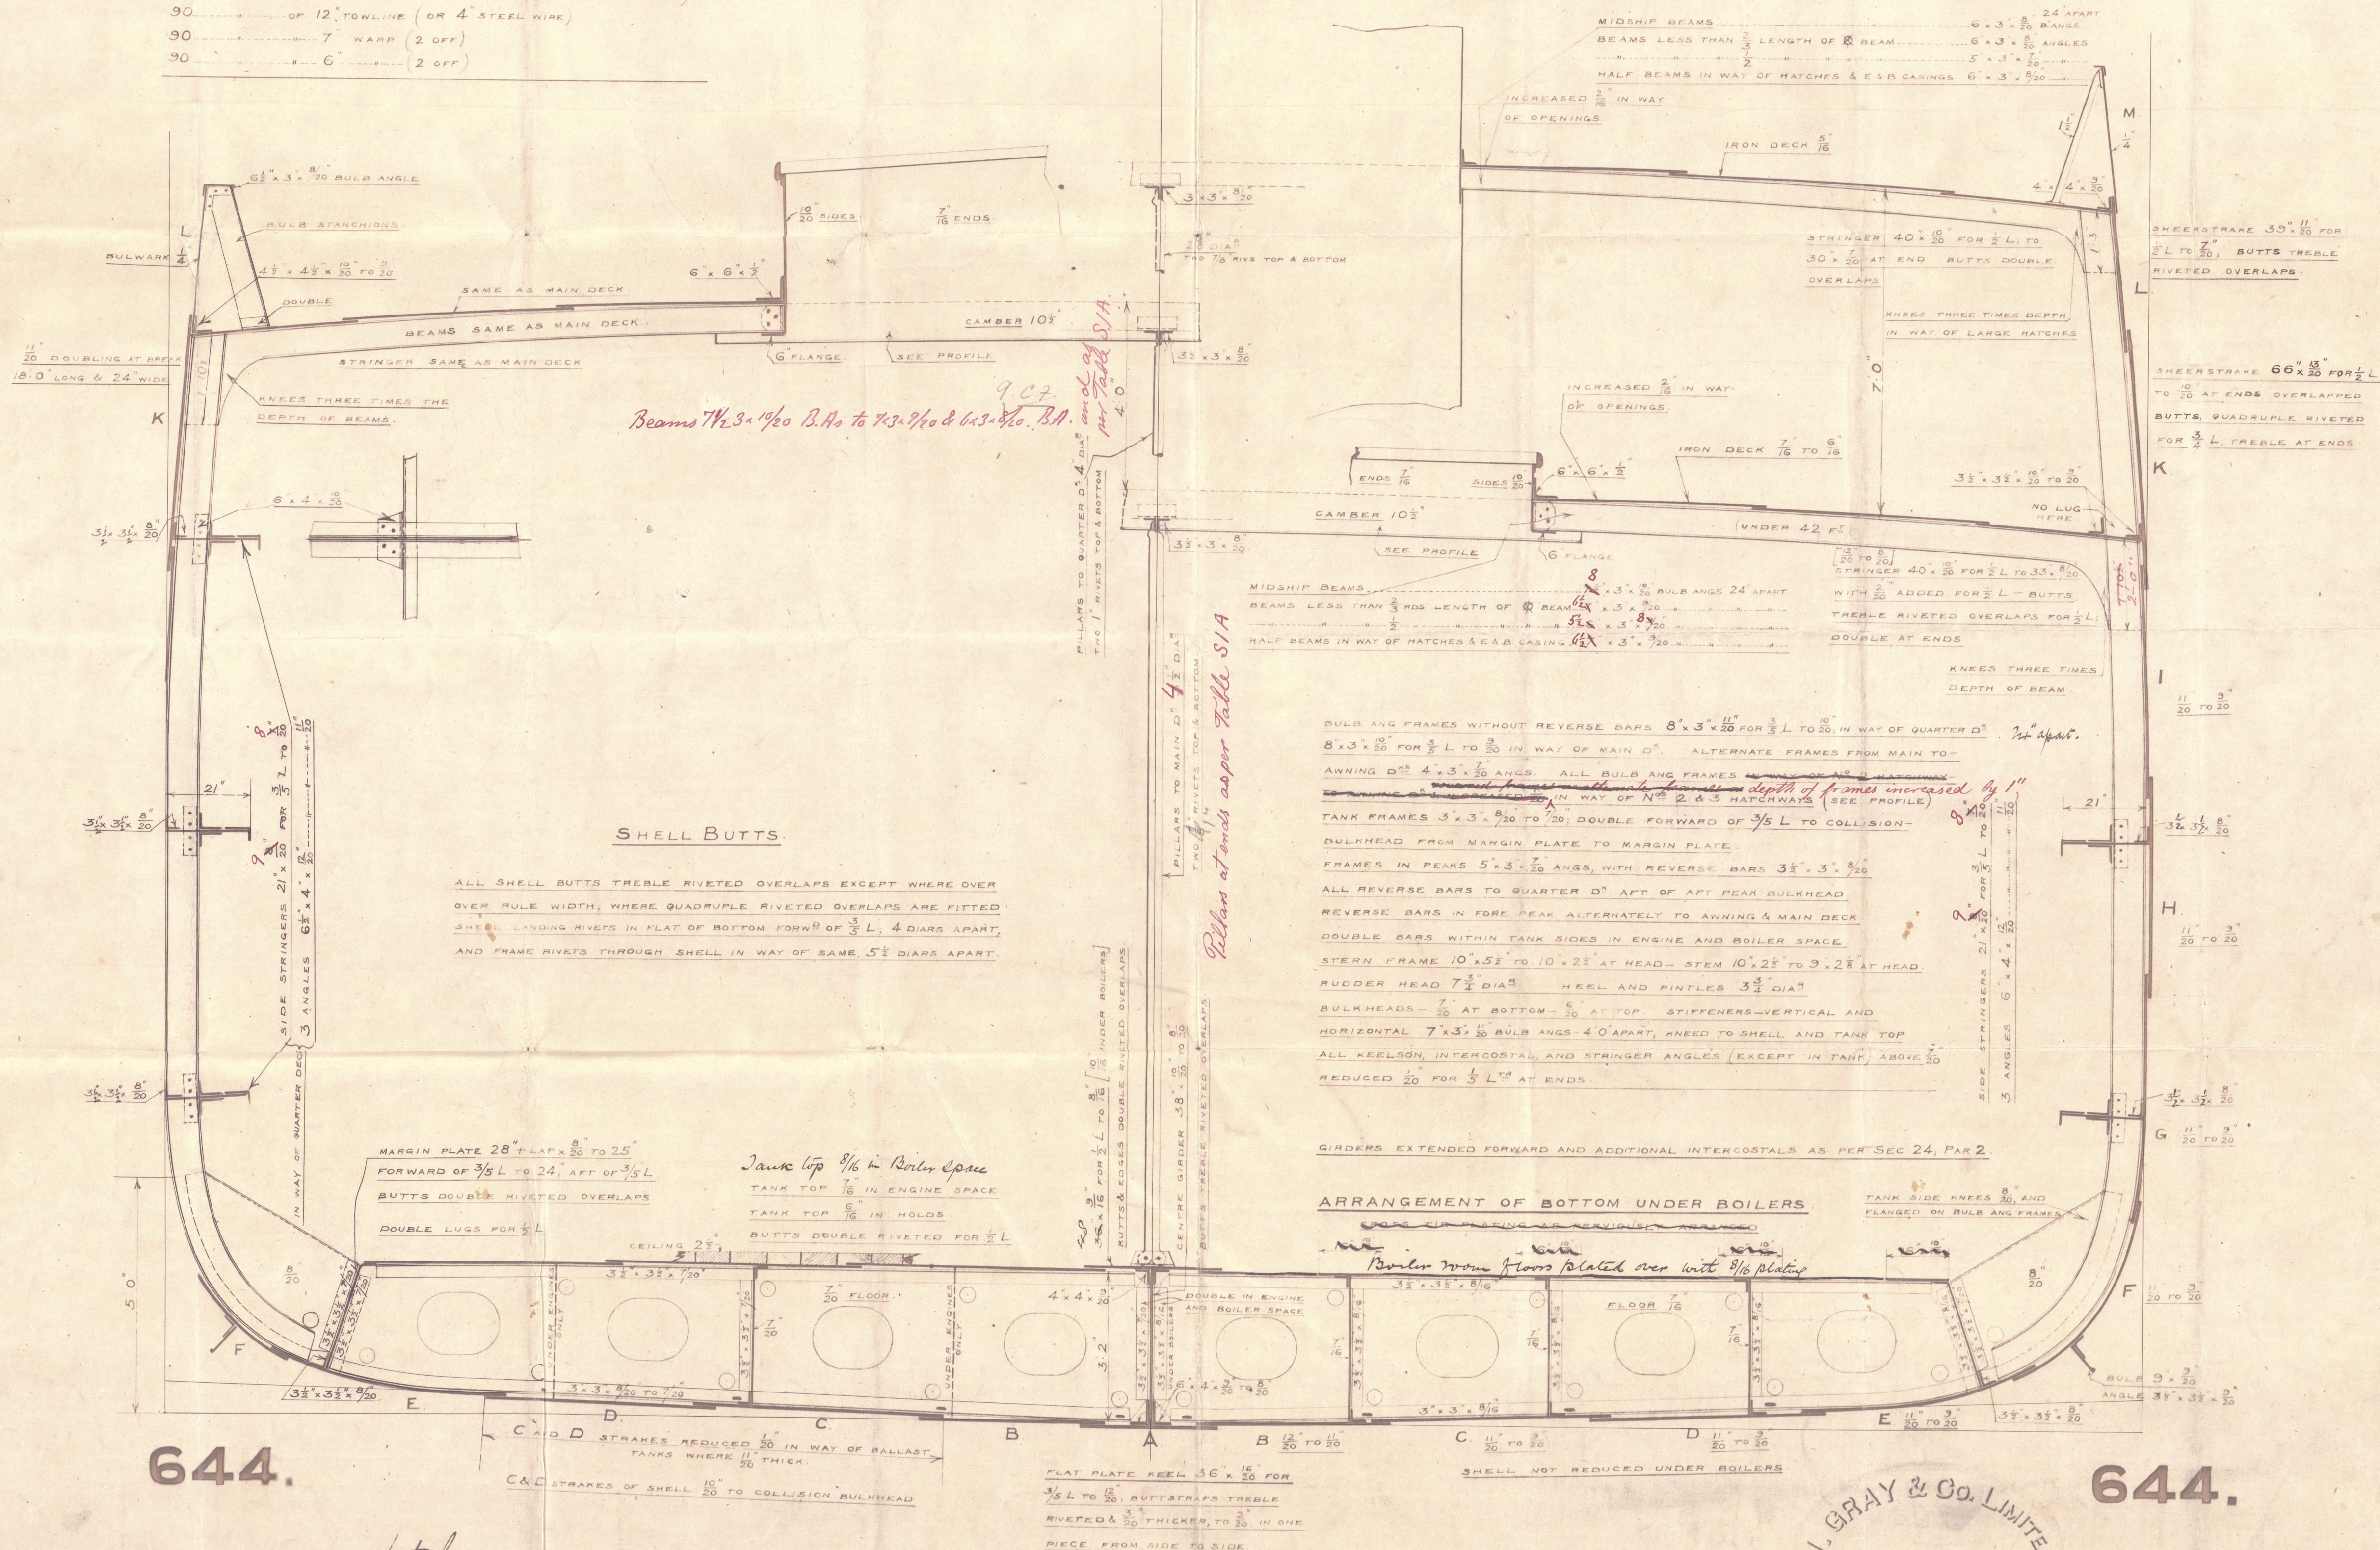

644.

644.



W. GRAY & Co. LIMITED
WEST HARTLEPOOL

21/1/0.



W924-0021

Wray & Co.
No. 844 ~~653~~

Midships Section

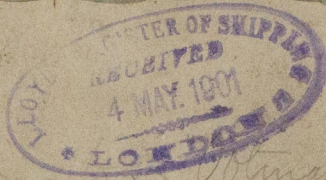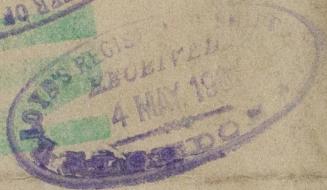

Belarne Apr 11650.

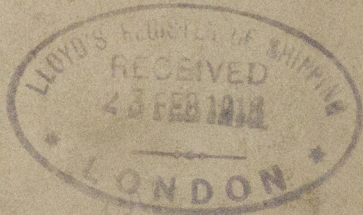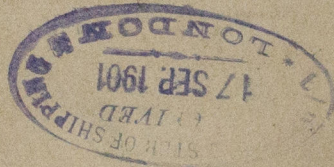

© 2020

Lloyd's Register
Foundation