

SCALE 1"=1 FOOT
190# WORKING PRESSURE
REVISED JULY 23, 1915
REVISED MAY 26, 1915



Fore River 252

also for 247 + 249

Main Boilers

Cubadest
Rm 8-2

WP 190#

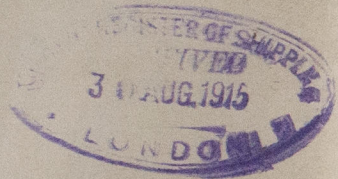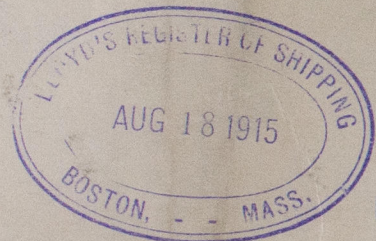

Part of plan
RETURN

W926-0115

LLOYD'S REGISTER OF SHIPPING
89 STATE ST.
BOSTON, MASS.

RECEIVED
FORE RIVER SHIPBUILDING CORPN.
AUG 14 1916
Ans'd. By
Noted. By



© 2021

Lloyd's Register
Foundation