


Cochrane + Son

N-348

Profile & Deck


Hull Report No. 18960

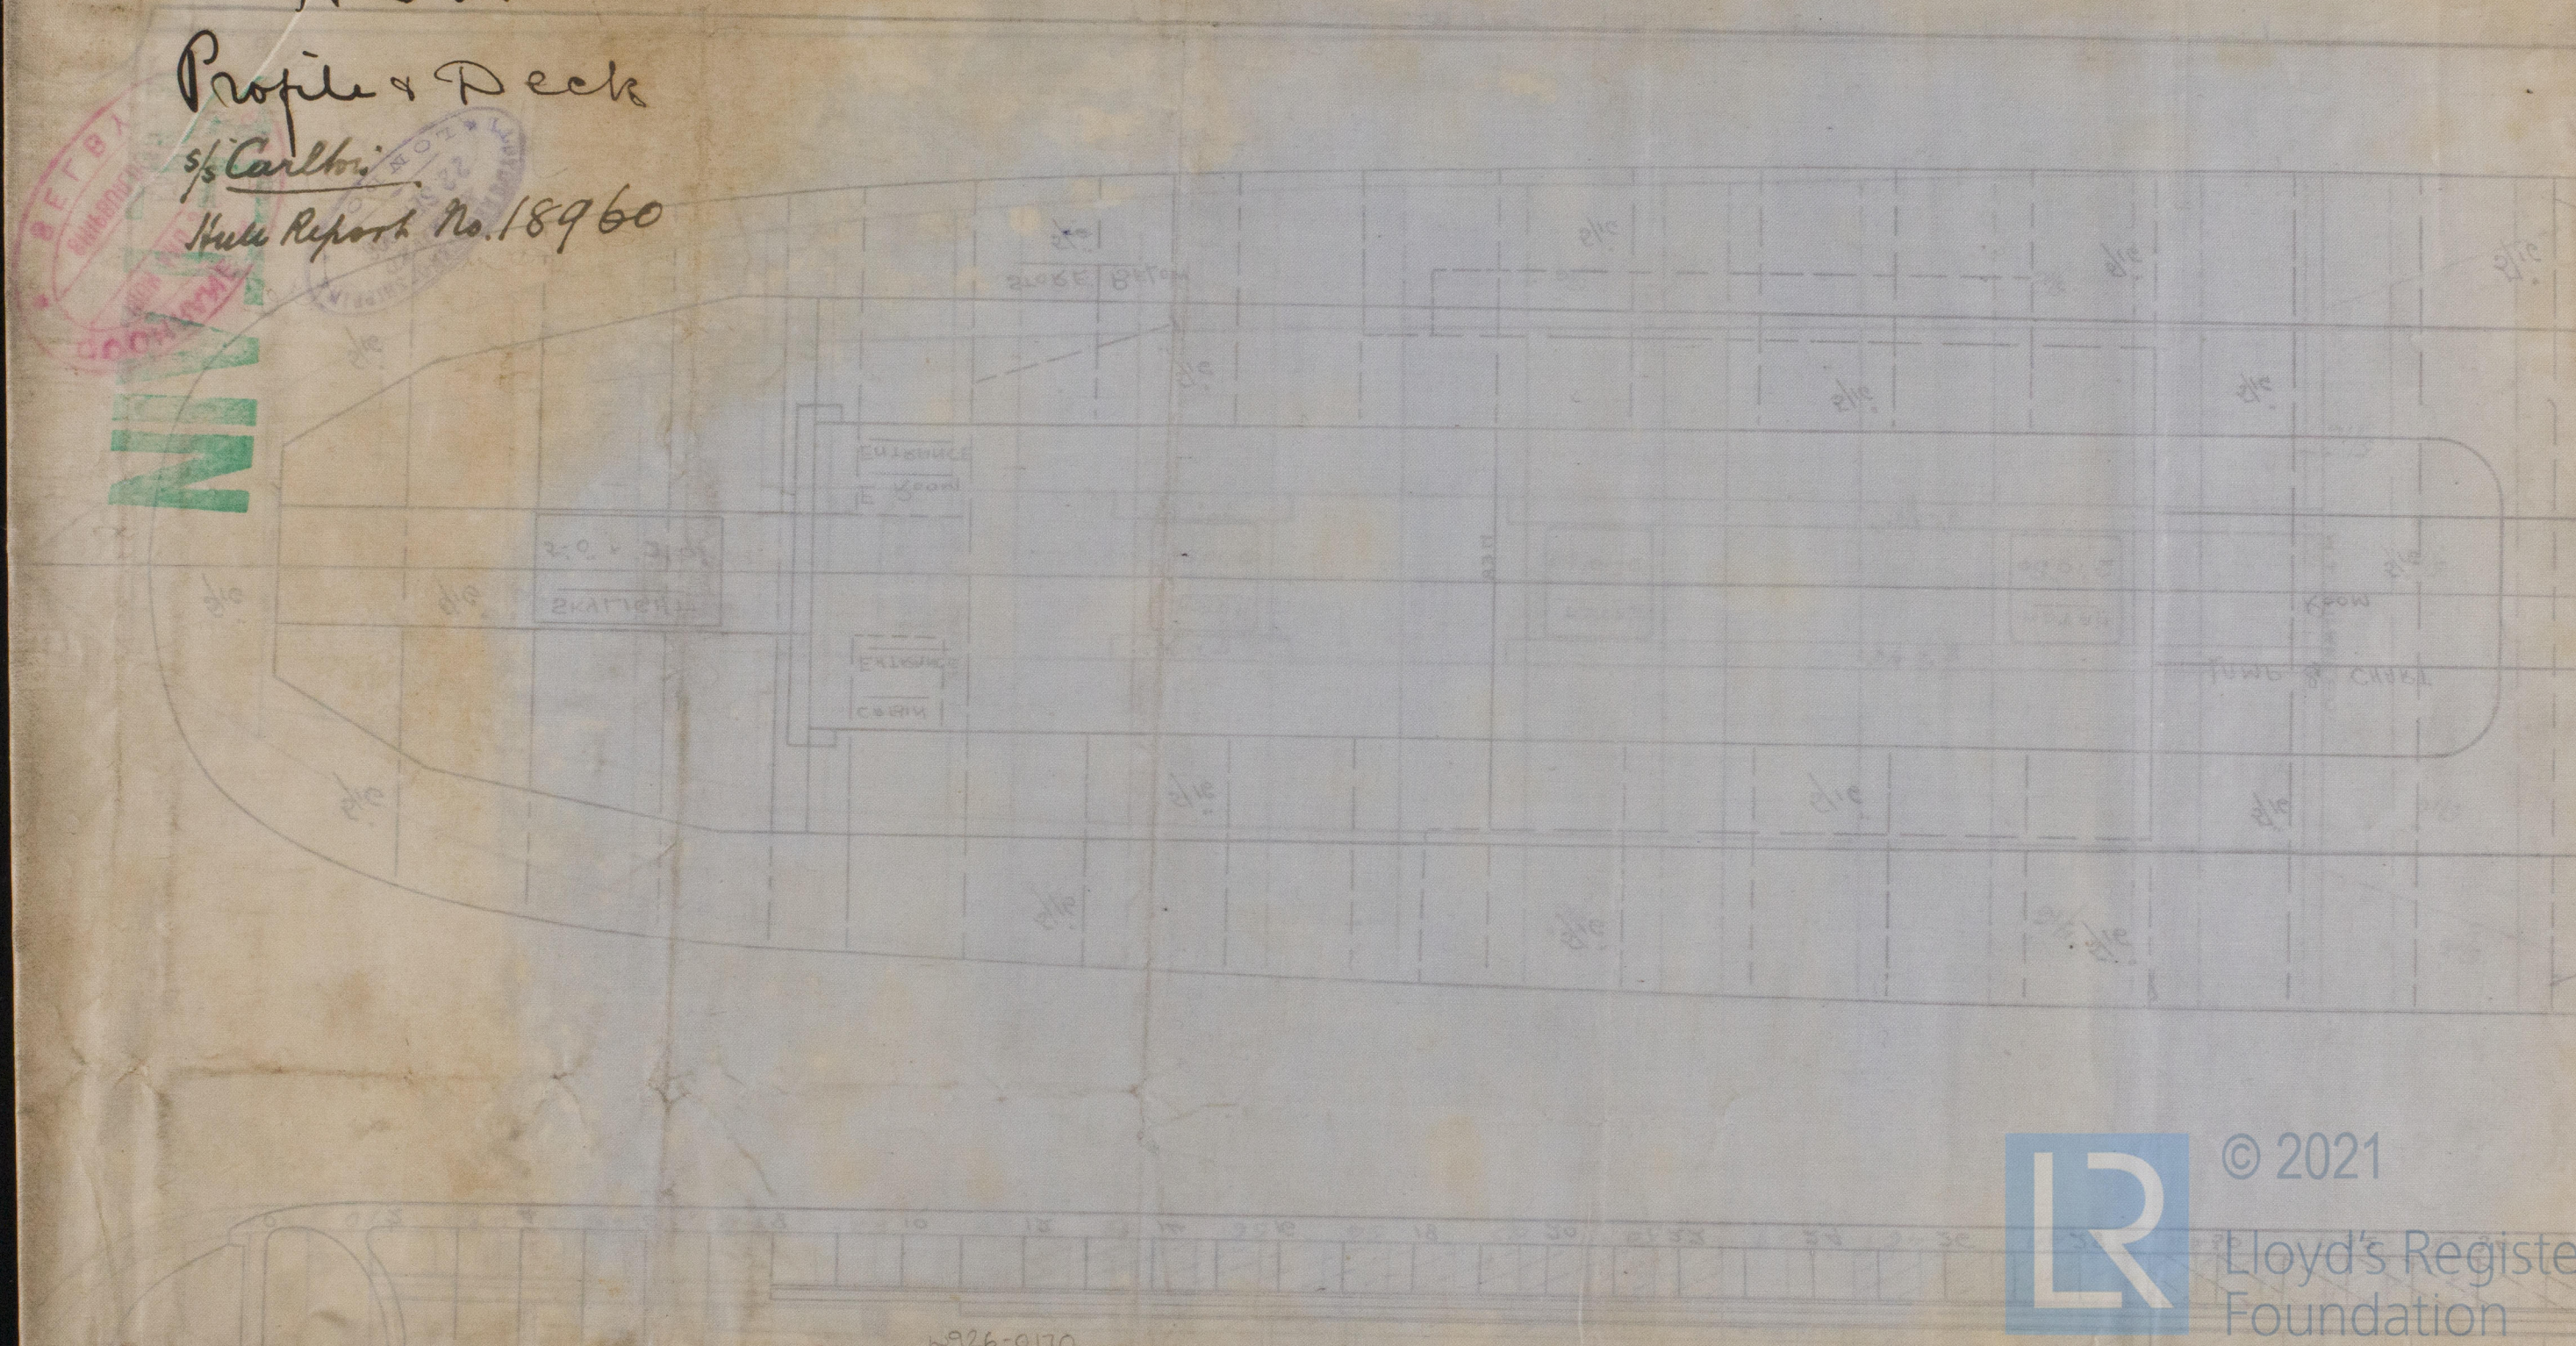

© 2021

Lloyd's Register
Foundation

W926-0170