


ELEVATION

DIMENSIONS 190'-0" x 30'-0" x 15'-7" MLD:

SCALE $\frac{1}{8}'' = 1 \text{ FOOT.}$

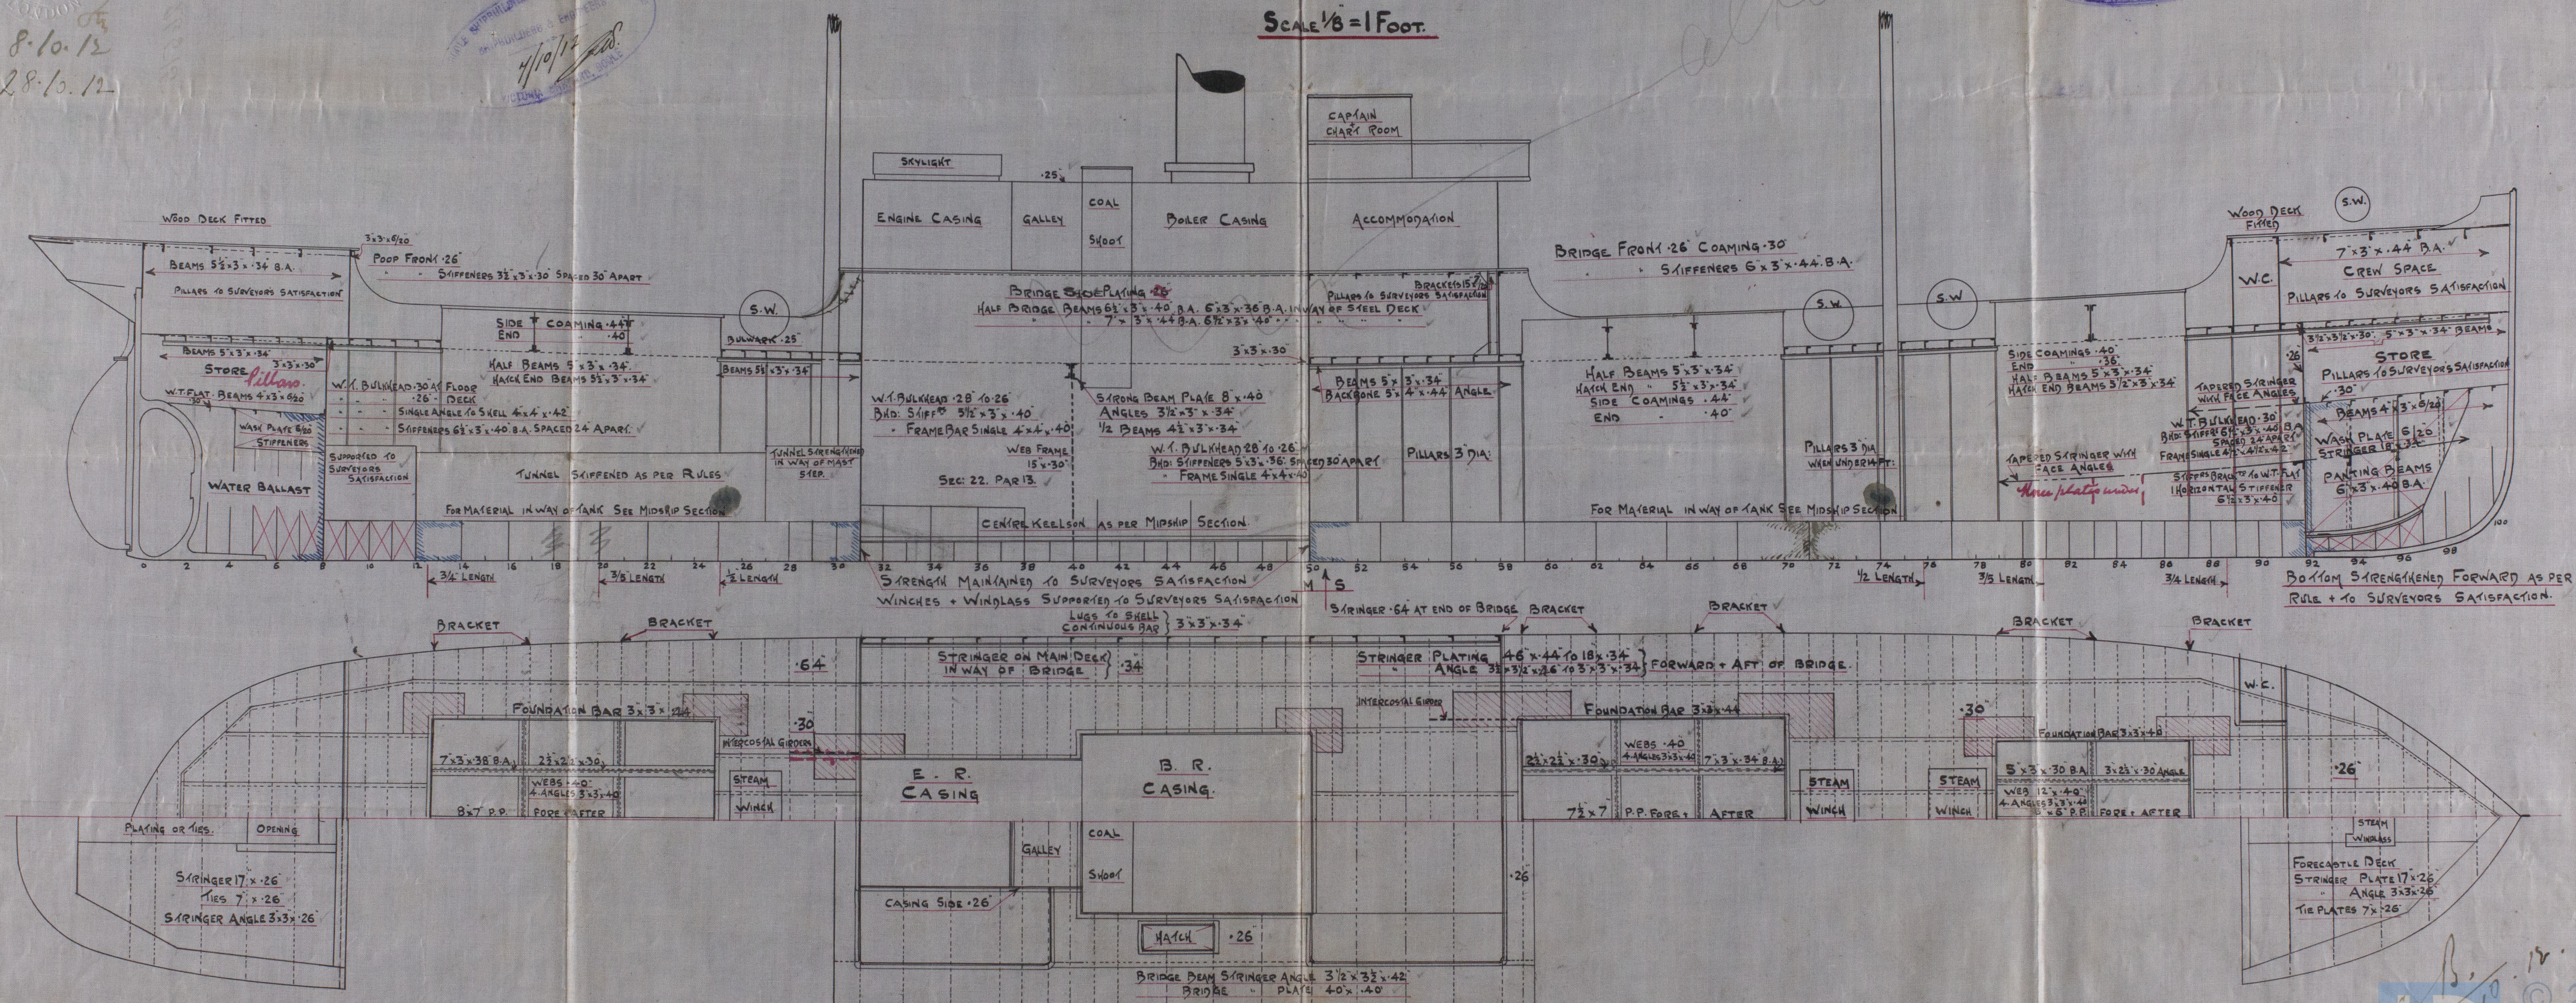

Goole S. B. & R. Co

No. 155

Profile & Deck

W. Derner

Hull Rpt No: 26515

W928-0087



© 2020

Lloyd's Register
Foundation