

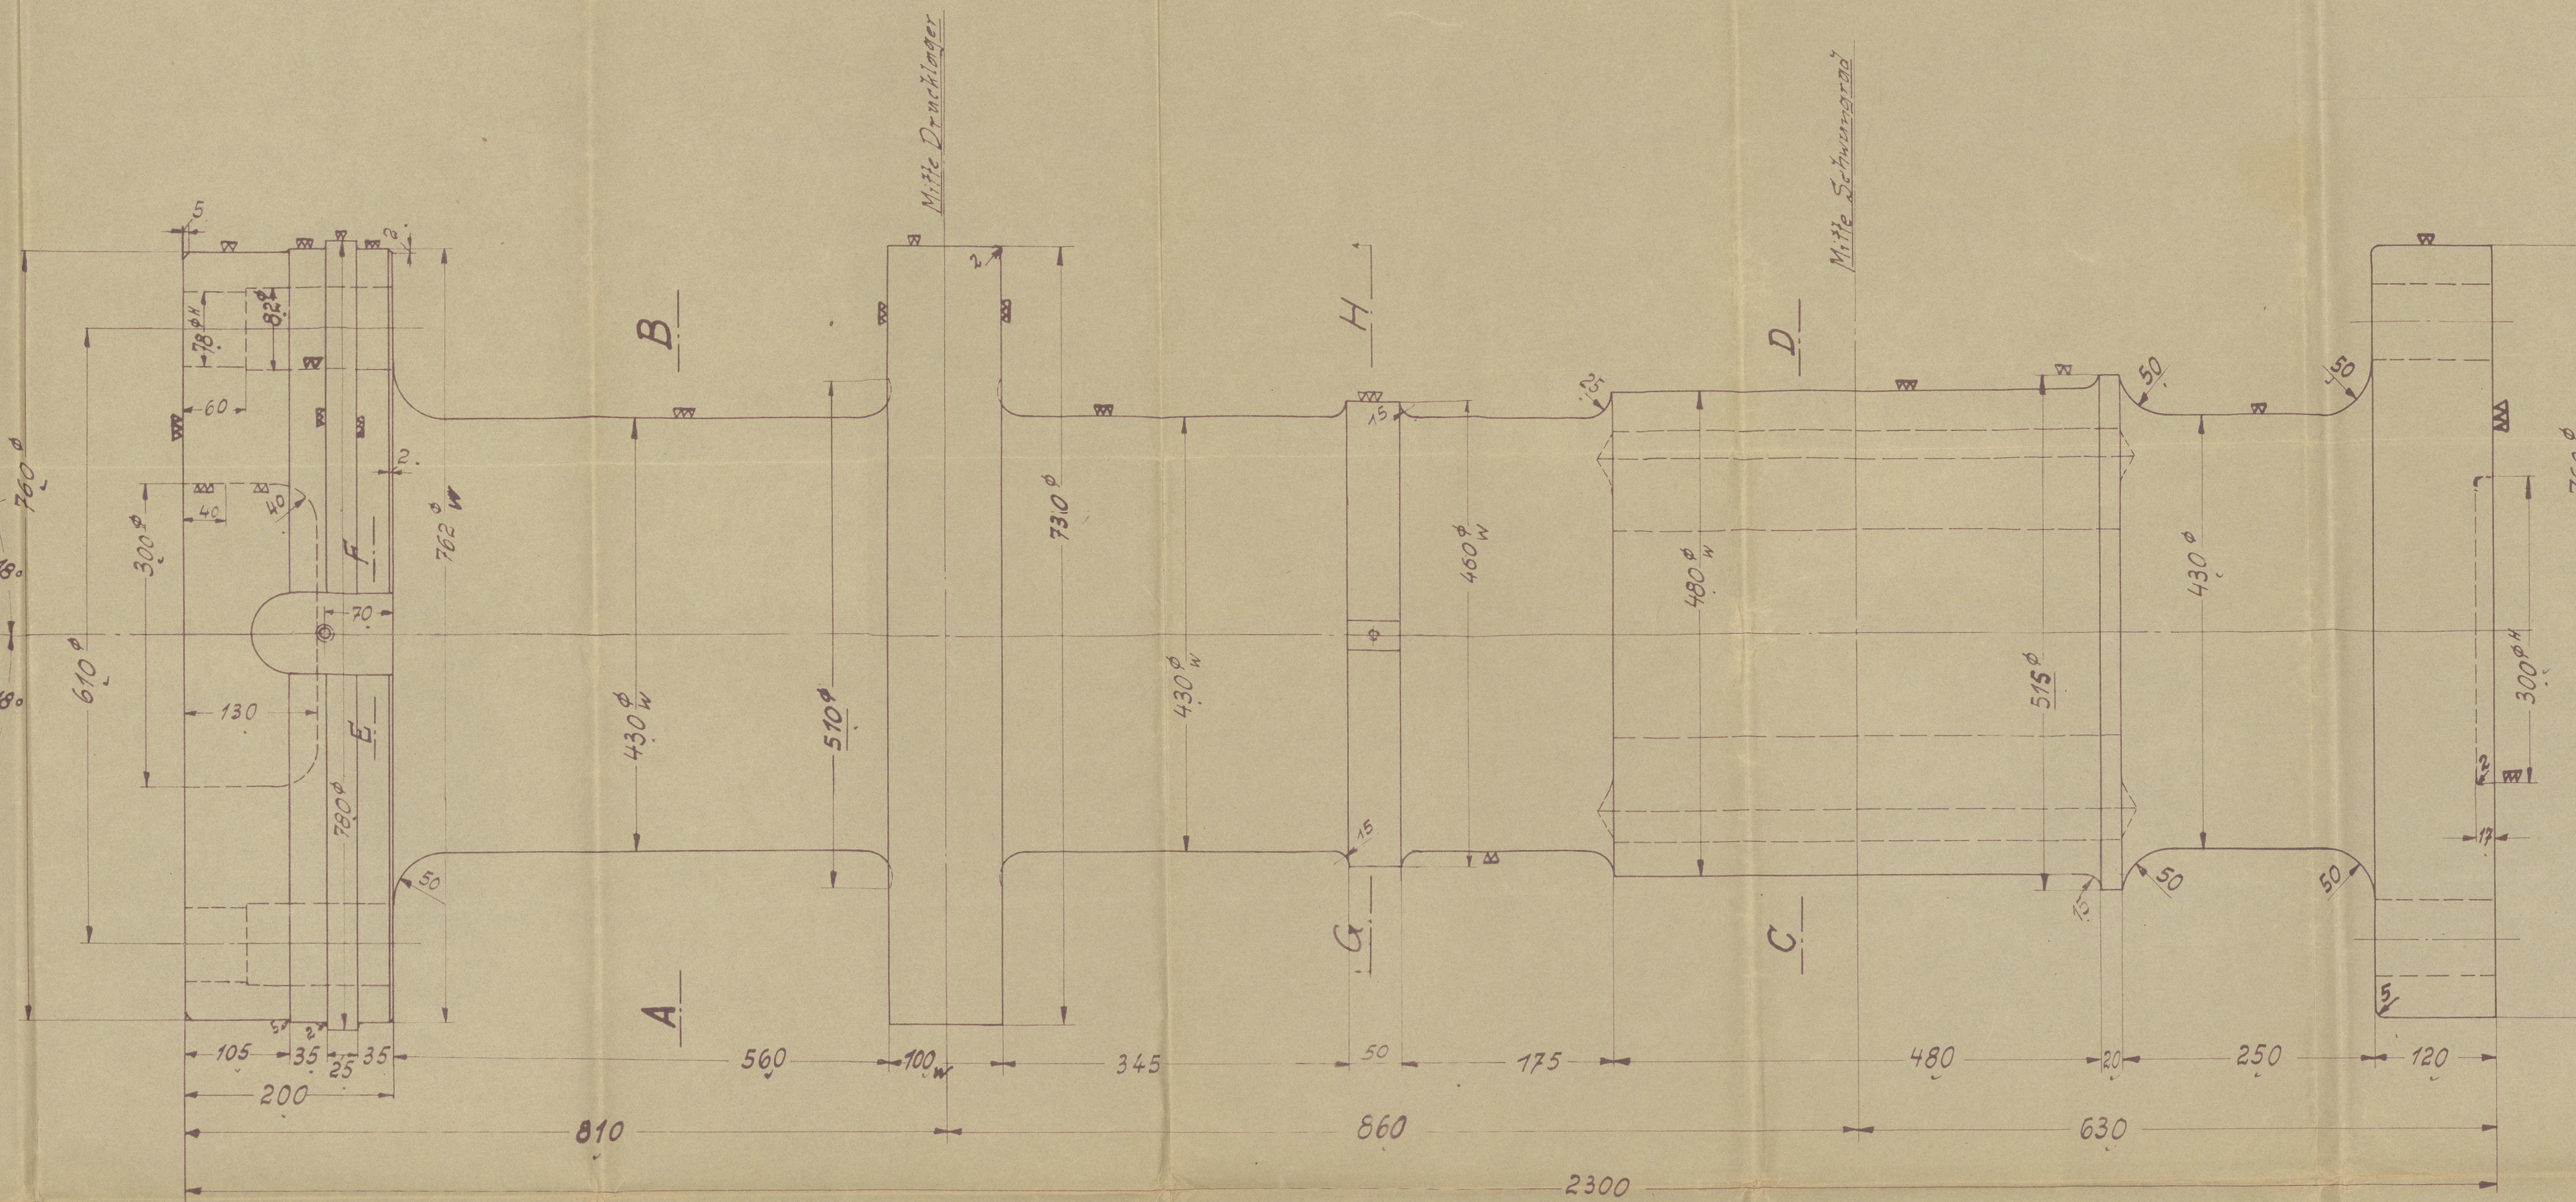
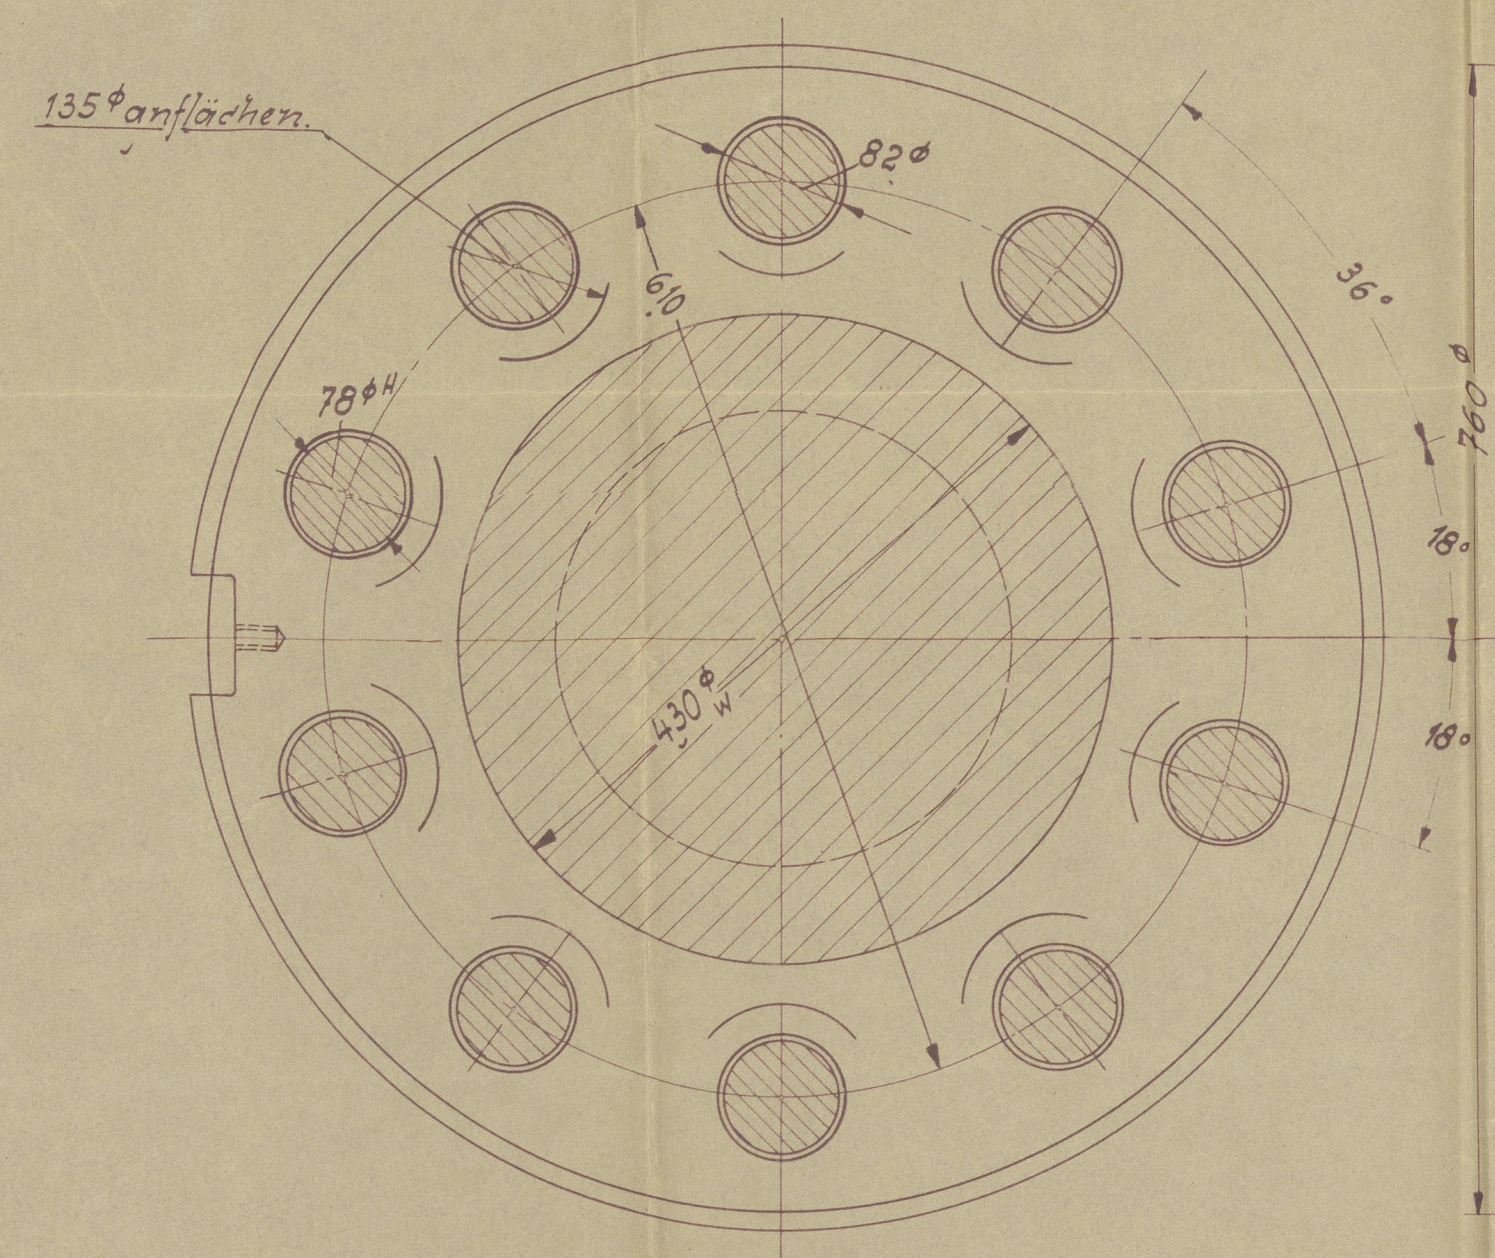


27/8/34


Schnitt A-B

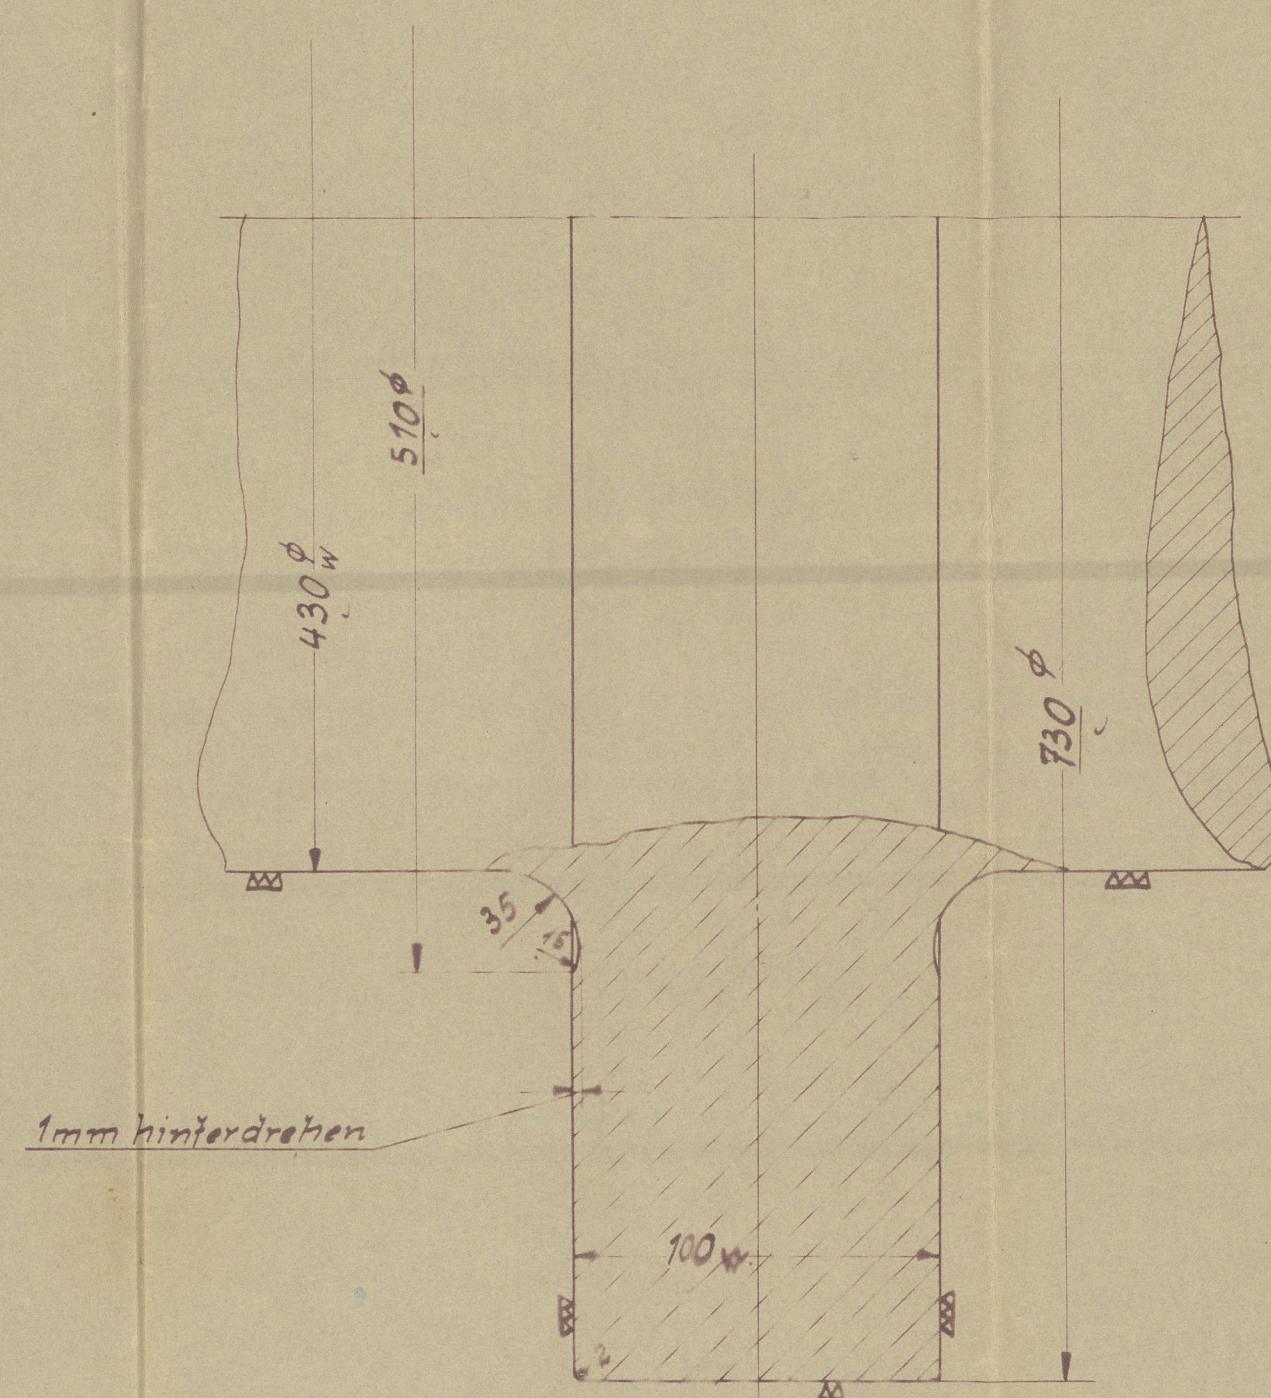


Schnitt E-F

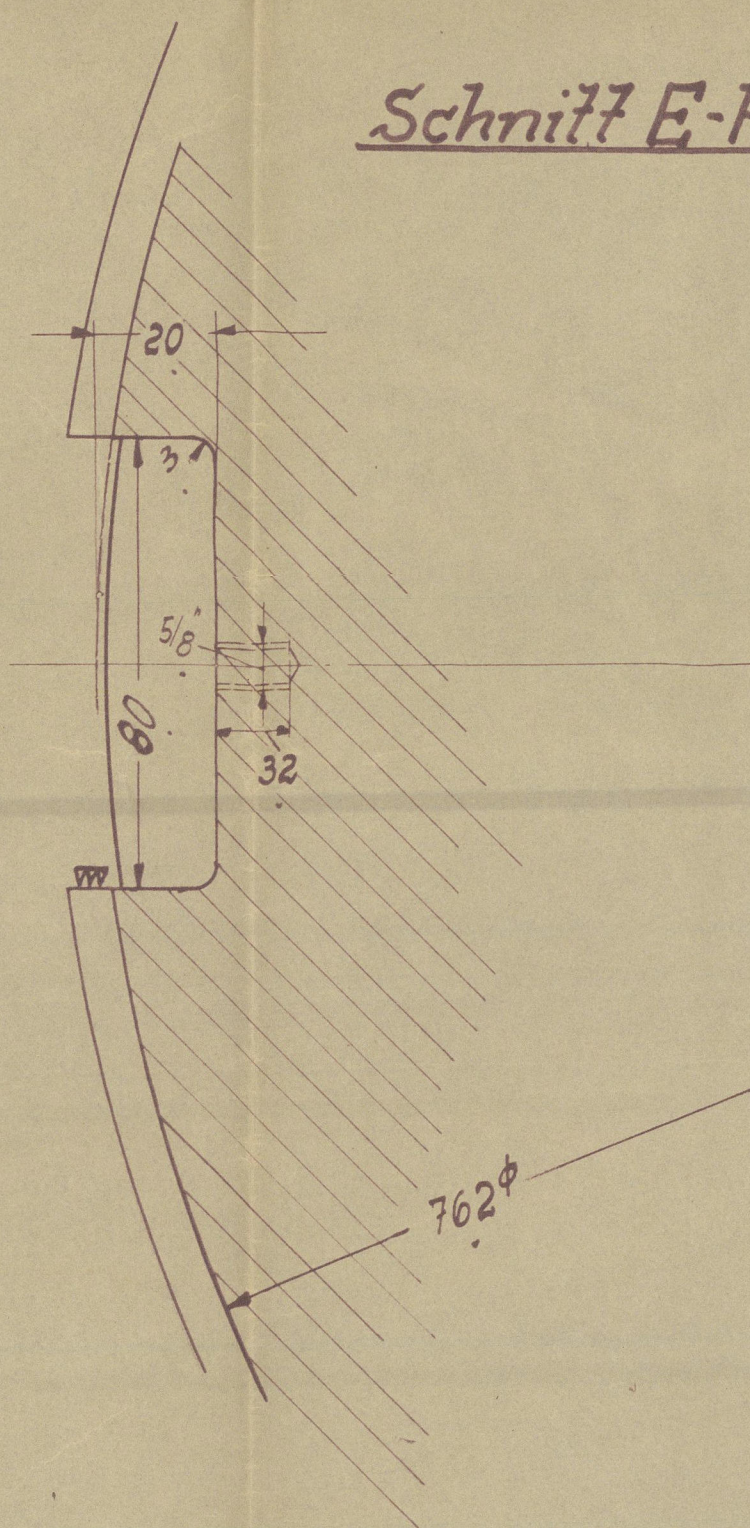


Schnitt G-H

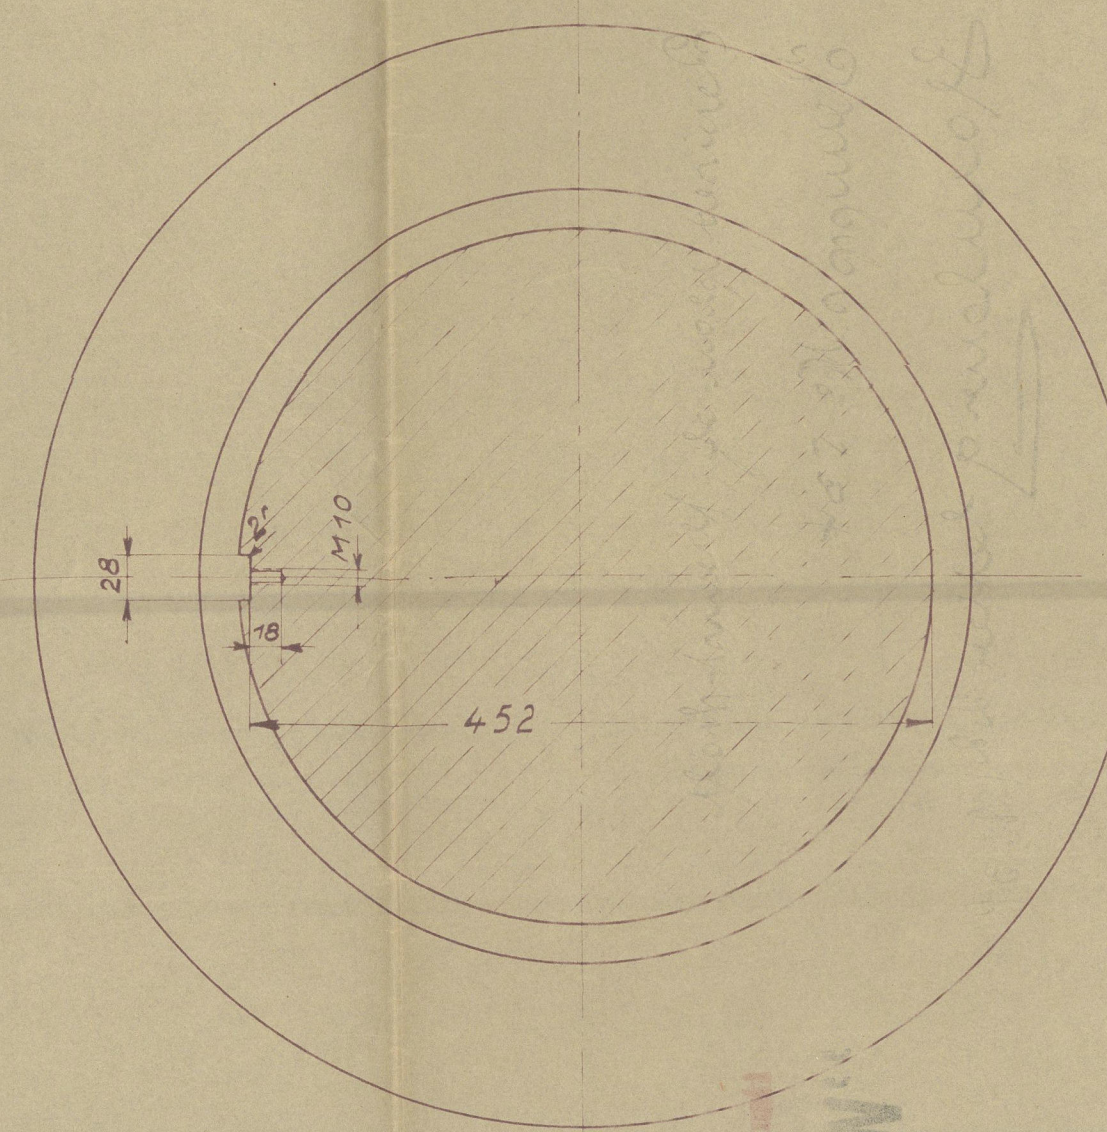

Schnitt C-D

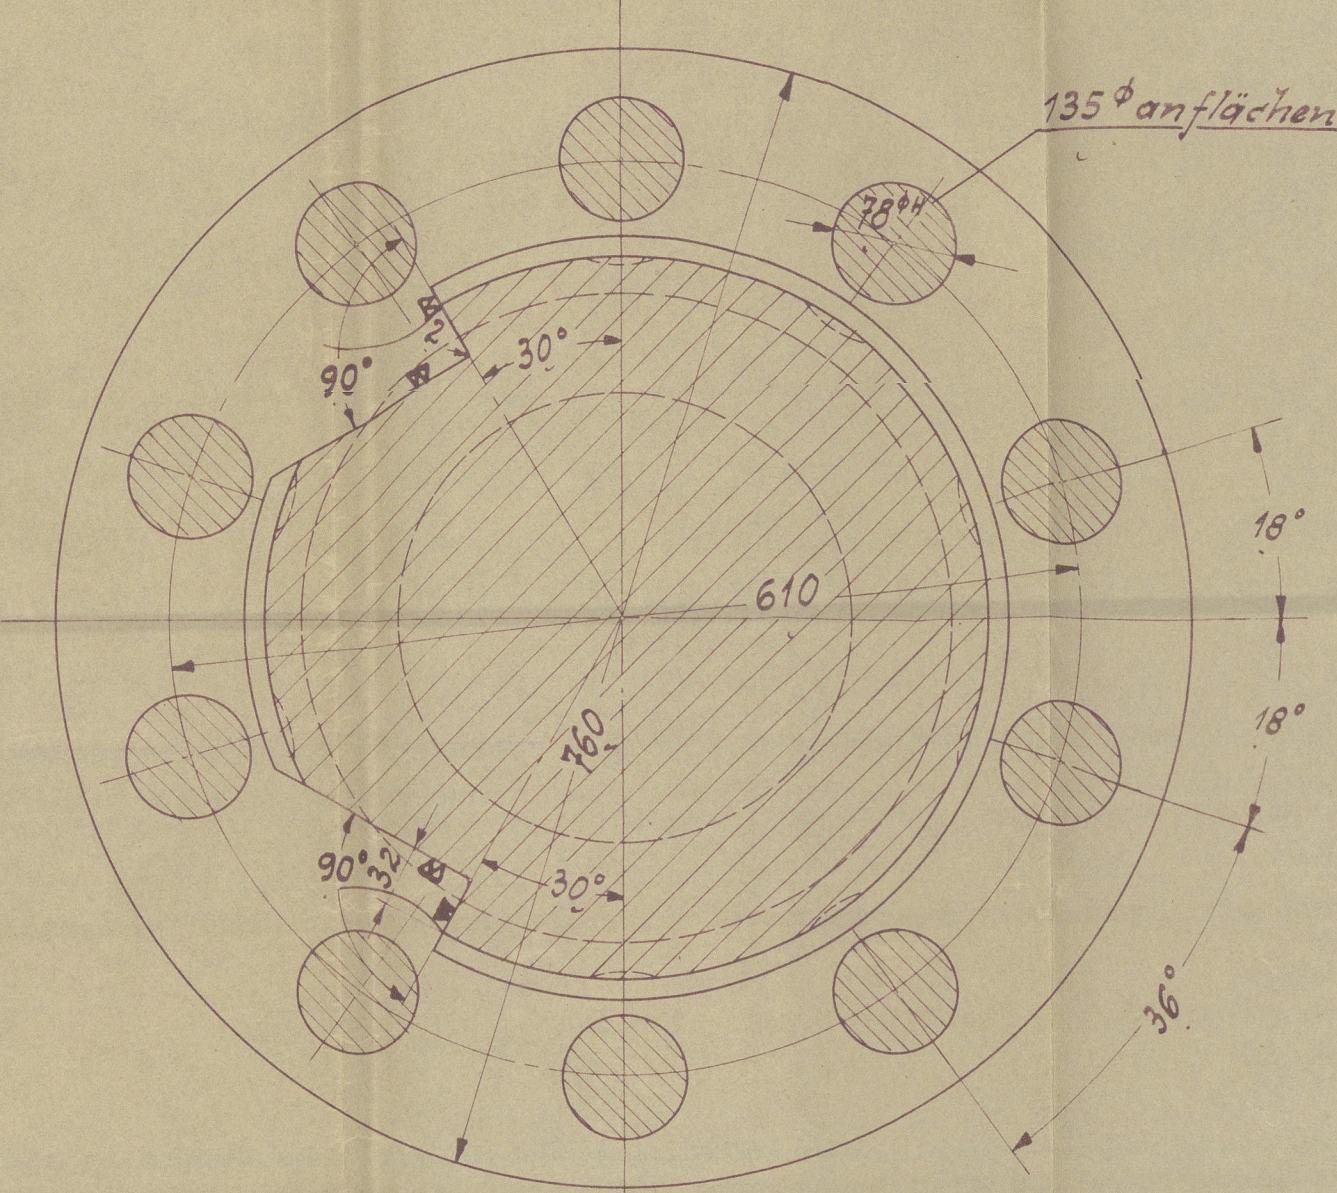

W.G.F.
25/8/34

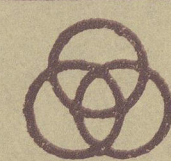

Fried. Krupp
Germaniawerft A.G.

Druckwelle

Werkstoff: St 50.11

St.Gew. in kg 3650

Name: *G. K. Meyer*

Datum: 30.7.34

Modell-Nr.

Type: 65/125 ex. a

Mo. 81118

Gr.-Z. 2035

© 2012 Lloyd's Register Foundation

193-0847


Hemp's No 534

Hamburg letter 22/8.34

Hamburg Report Nr. 21578

"W.B.WALKER"



W93-0047

© 2020

Lloyd's Register
Foundation