

7.12.05

Scale 1:25.





© 2020
Lloyd's Register
Foundation
W93-0101




2. 15. 8


Howaldt Werke №444+5
Sketch of proposed web
frame on frame №108 in
line of the Bulkhead required
by the Rules

Hamburg letter
29. 11. 05

№444 Secalia
№445 Eximetic

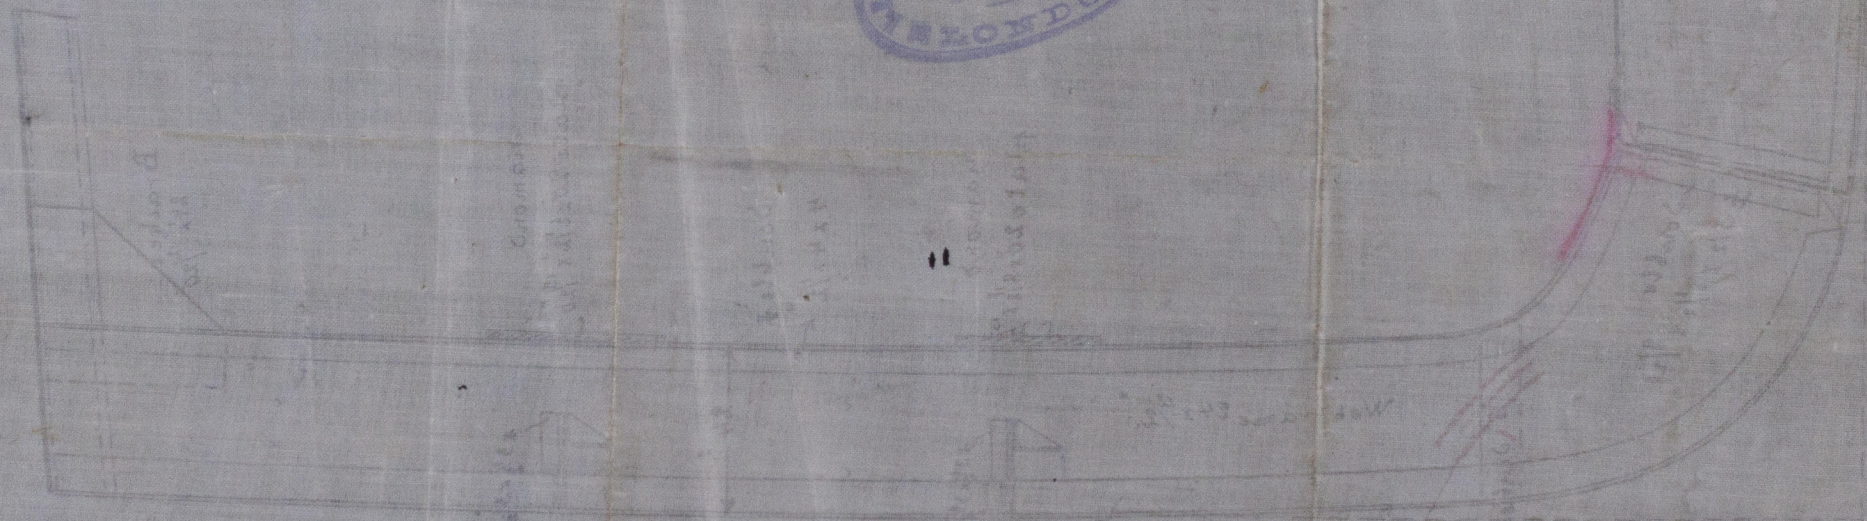

W193-0101

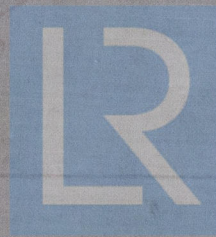

© 2020
Lloyd's Register
Foundation