


2. 11. 05  
30. 6. 06

**Awning.**  
**Single Deck Cargo Steamer.**  
1:100.  
N<sup>o</sup> 444/45.

Principal Dimensions:  
Length betw. PP. 284'-0"  
Breadth extreme 42'-0"  
Depth (moulded) 20'-7"

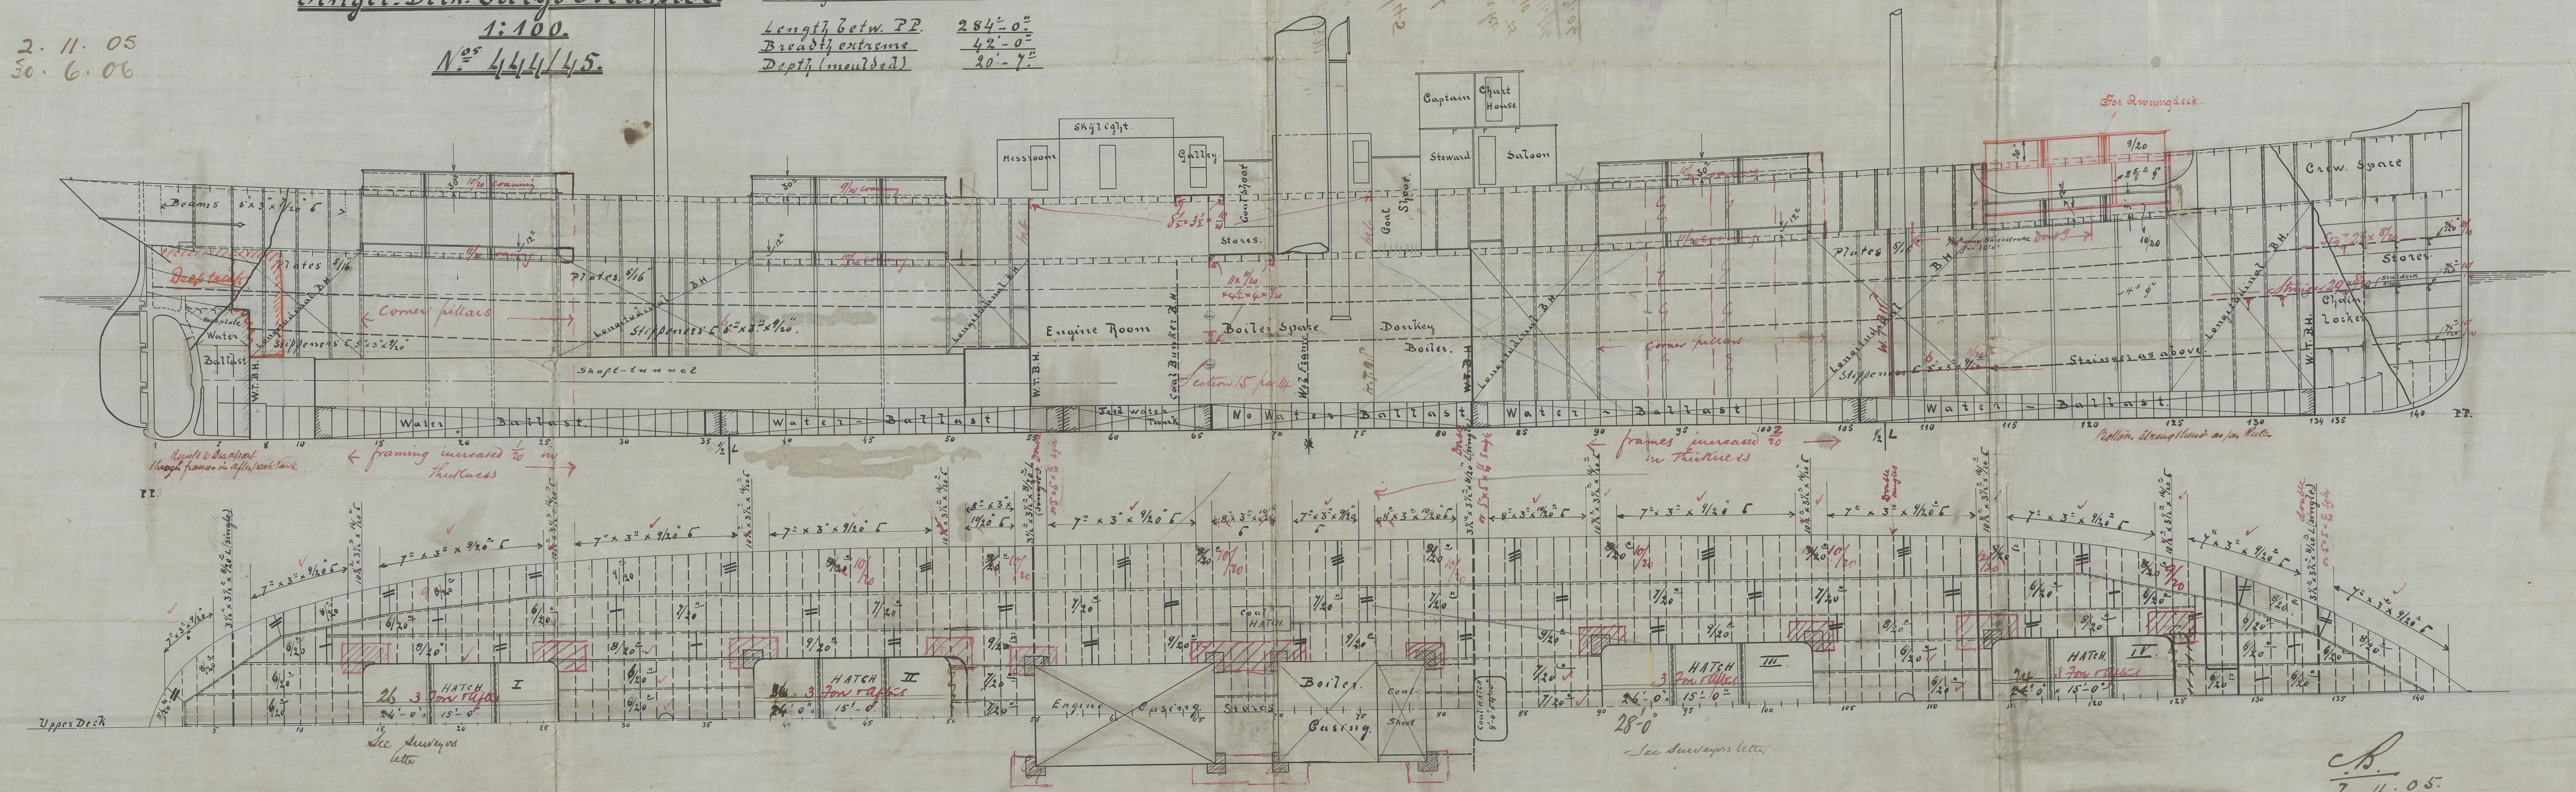

HOWALDTSWERKE  
KIEL.  
N<sup>o</sup> 17323 d. 27. 11. 05  

*C.B.*  
2. 11. 05.  
30. 6. 06.



1/6 Secalia Ham. Tel. N. 9310

1/5 Frumentia " N.

S. S. N. 444/45

Longitudinal

Howaldtswerke


Ham. letter 28/10 '05

" " 25/6/06

" " 23.7.06

Secalia 444

Frumentia 445

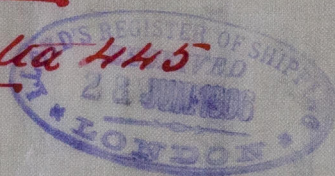

W193-0102



© 2020

Lloyd's Register  
Foundation