


ALL HOLES TO BE DRILLED IN PLACE

[illegible]

" GRATE AREA BARS 3 BLRS =

AND LLOYDS. REQUIREMENTS

TEST " 426 " " " "

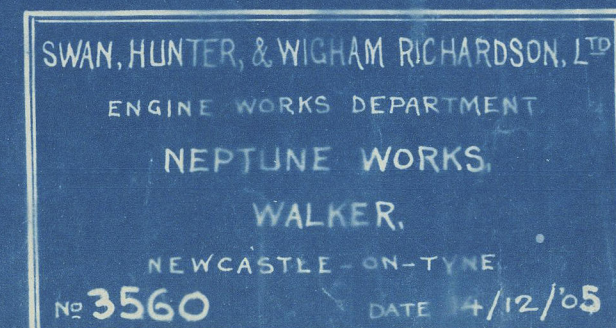

MAIN BOILERS N° 760

— SCALE 1" = 1 FOOT —

460

Amended plans of main and donkey
boilers. showing bottom longitudinal stays
increased to 2 7/8"

W/93-0133



© 2020

Lloyd's Register
Foundation

Duplicate 7328
98 Rheing. cl.
New Castle on Tyne
S H & W R
S. S. No 760
Main Boilers

S. S. "Braunfels"
Newcastle Report
No. 51 R23.

No 7250
Rly. Lnt
426 H.
L-H-H
18-6-06-

W 93-0133



© 2020

Lloyd's Register
Foundation