



16.11.05  
30.11.05  
13.12.05


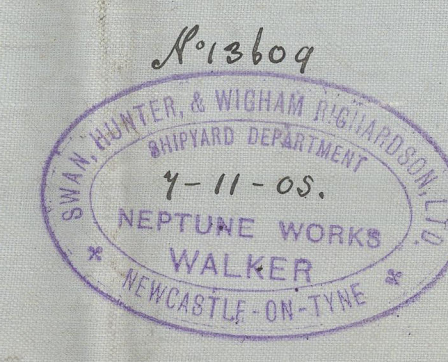


*Amu*

SECTION IN WAY OF  
AFTER TWIN DR TANK

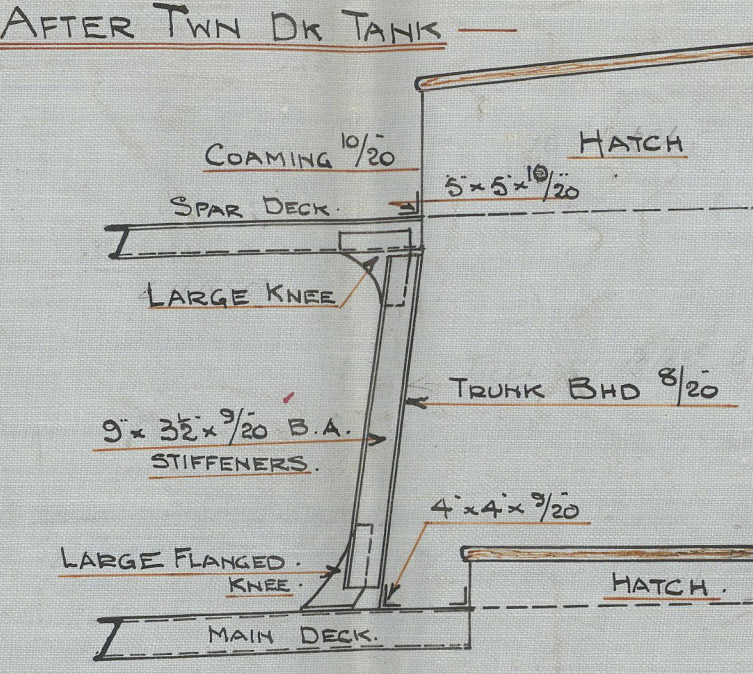

— NO 760 —  
— PROFILE & DECK PLANS —  
SCALE 1/8" = 1 FOOT  
DIMENSIONS 421' 10" PP x 35' 3" EXT x 31' 2" HLD. TO SPAR DECK  
TO CLASS 100A1 AT LLOYDS. SPAR DECK RULE

  

*17/11/05*



J.P. 'Braunfels'

Newcastle Report

No 51. x 23

W/93-0134



© 2020



Lloyd's Register  
Foundation



Swan Hunter & Wig: Rich La

SS N<sup>o</sup> 760

Profile & Deck Plan

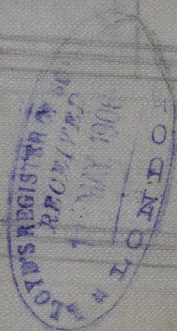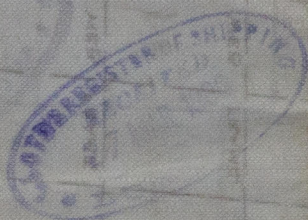

W193-0134



© 2020

Lloyd's Register  
Foundation