


2-11-05

S.S. N° 86.

ELEVATION

DIMS: 130'-0" BP x 22'-0" x 12'-3" M^o


SCALE 1/4" = 1 FT.

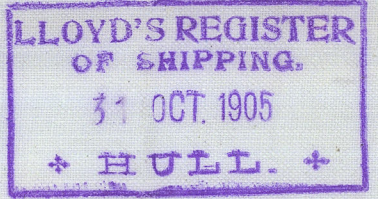


6.4.11.05

6.4.11.05

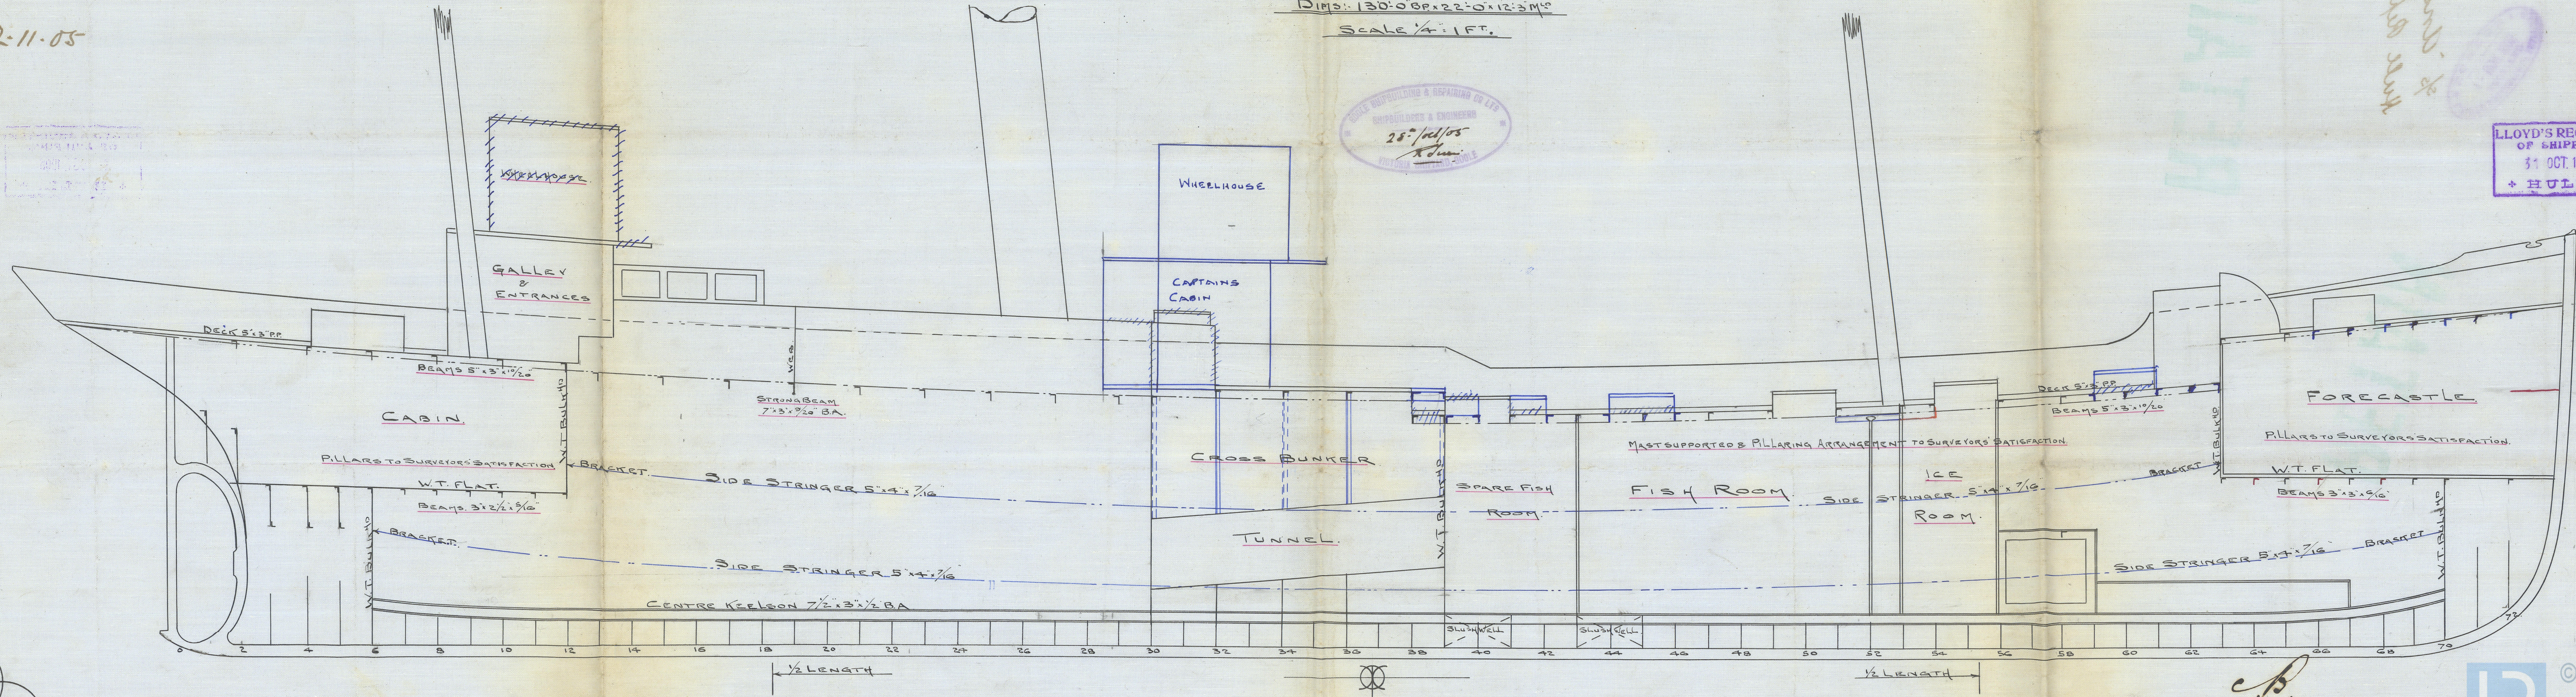


№ 86.

Profile

s/s "Anaconda"
Hull Report No. 18030

© 2021

Lloyd's Register
Foundation

W930-0064