

For the information of Surveyors and the Committee only.



Received at

Lloyd's Register of British & Foreign Shipping.

(Report on Vessel No. 18030 Port Hull of s anaconda)

The words FORGINGS or CASTINGS, IRON or STEEL, should be struck out as may be required.

No. 349A SHIP FORGINGS OR CASTINGS.

I have to report that the undermentioned Iron or Steel Forgings or Castings, manufactured by Messrs. J.S. Foster & Sons, Ltd. of Pallion for the Vessel No. 86, being built by The Goole S.B. Co. of Goole. have been inspected by me as set forth below and found to be, so far as can be seen, sound.

Mark on Forgings.



Lloyd's No. 349A F.C.

Frank Cook.

Sunderland 26-4-06

Table with 3 columns: STERN FRAME, RUDDER FRAME, STEM. Rows include Material* (Scrap), How made (Forged), Dimensions (6x3, 4 1/2 to 3x3), Progress on Inspection (Forged & omitted), and Date when Inspected (31/10/05 to 30/11/05, 8/2/06 to 12/3/06).

SKETCHES OF FRAMES SHOWING POSITION AND DESCRIPTION OF WELDS OF FORGINGS, OR PARTICULARS OF TESTS APPLIED TO CASTINGS.

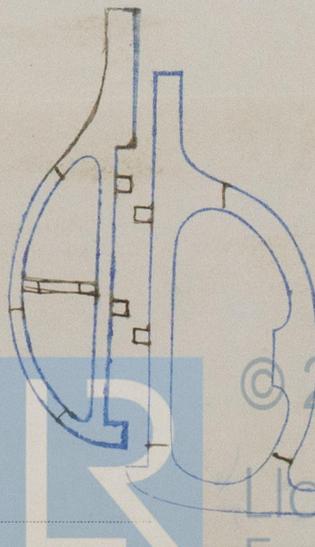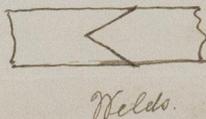

Fee (if any chargeable) £

To be paid at

© 2021

Lloyd's Register Foundation

* If of Iron, state whether scrap or puddled Iron.



© 2021

Lloyd's Register
Foundation *arsw*