





Cochrane & Sons  
No. 359

Profile & Deck

RETAIN

*s/s 'Clifton'*  
Hull Report No. 17705



© 2021

Lloyd's Register  
Foundation



Cochrane & Sons


No. 359

Profile & Deck

REMAIN

1/2 Clifton

Hull Report No. 17705

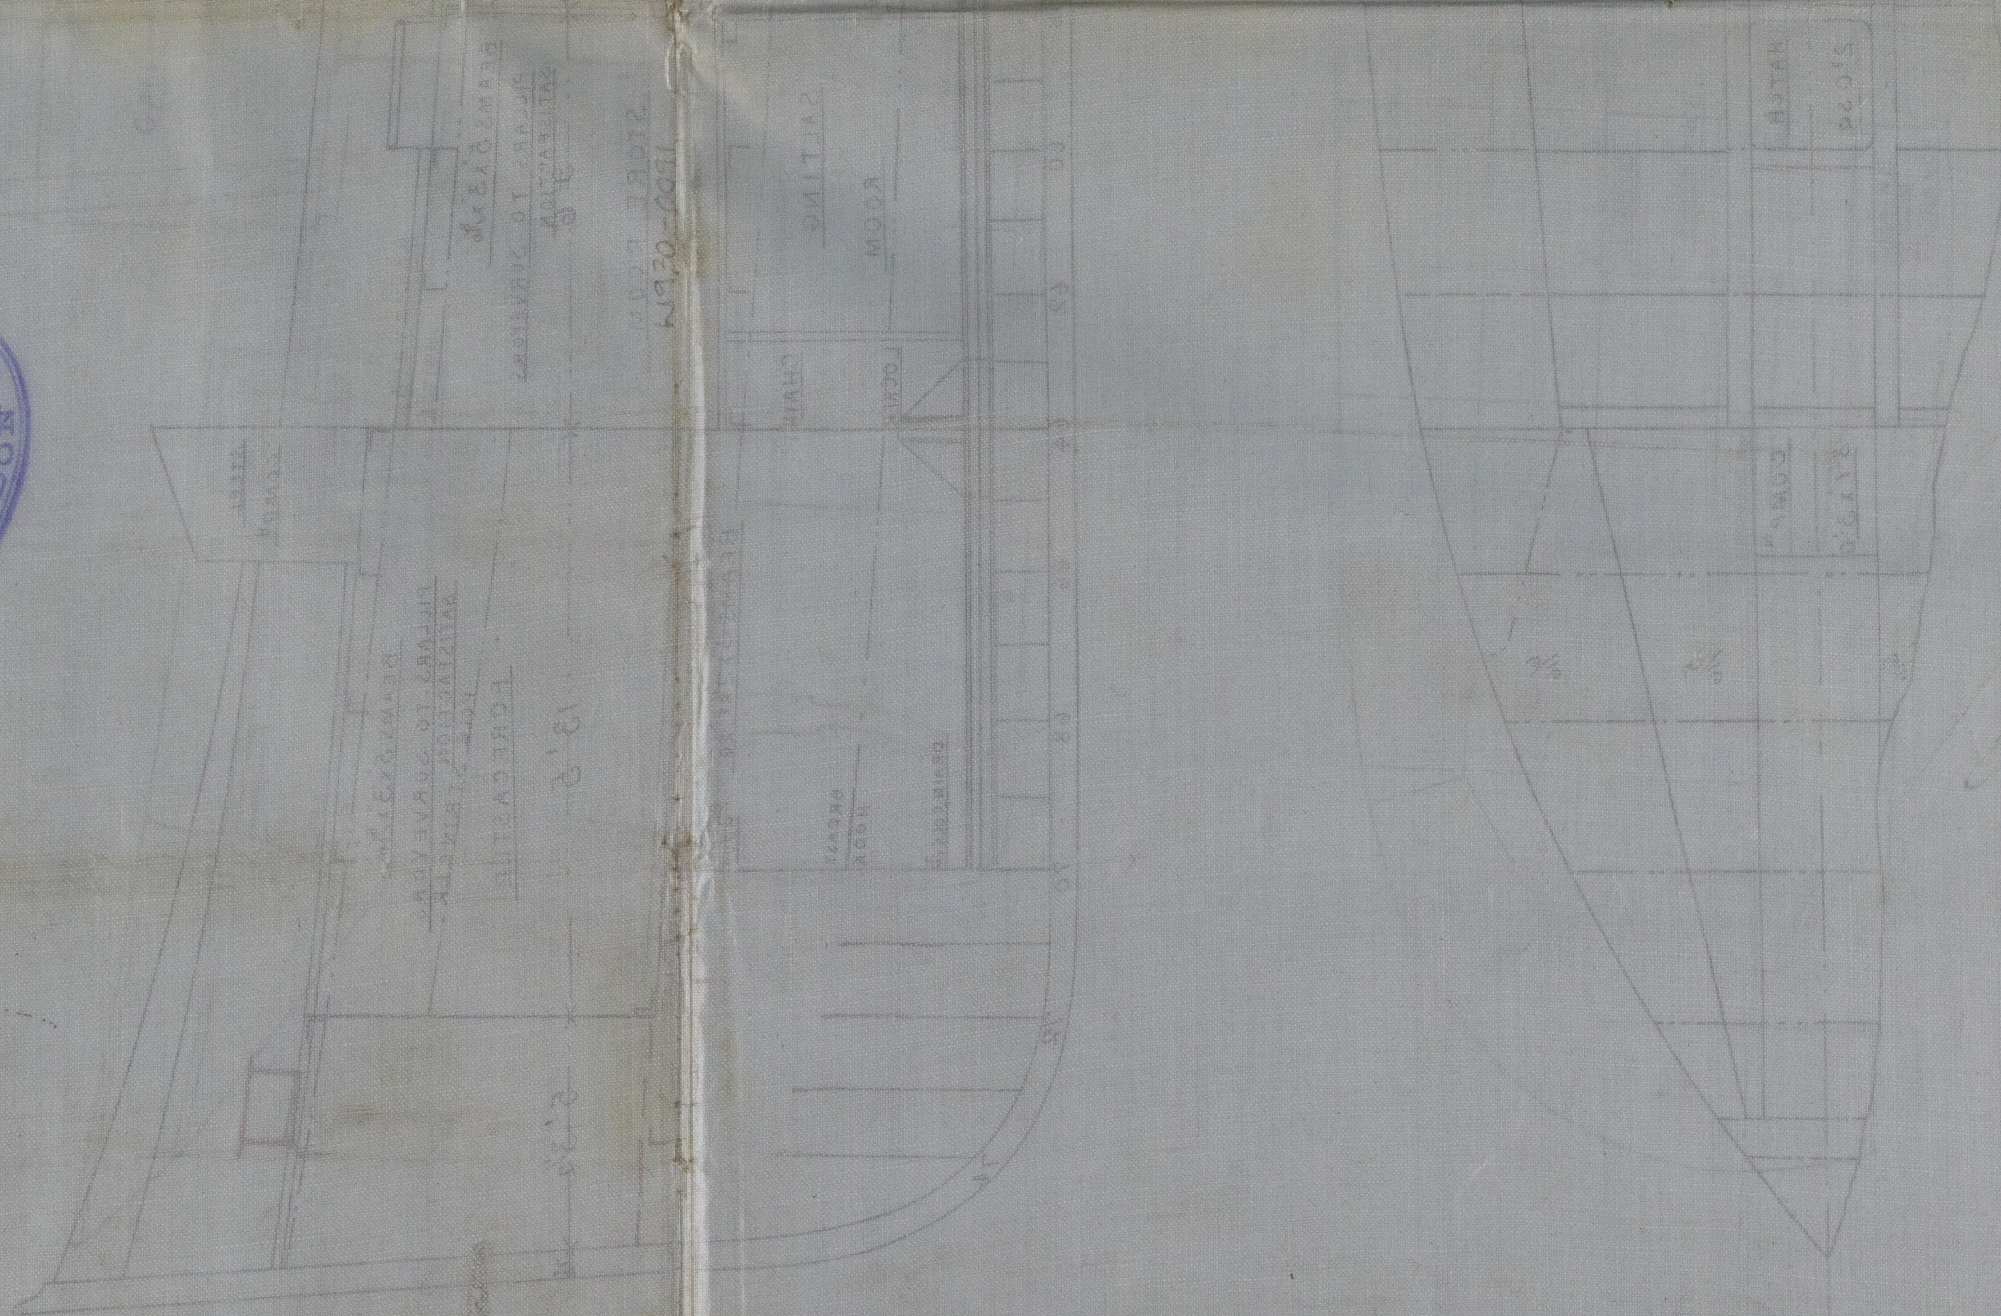

Profile & Deck 359



© 2021

Lloyd's Register Foundation



11930-0091



1/4 11:02

PROFILE & DECK

59



© 2021  
Lloyd's Register  
Foundation