

mod + manload
pccm
manload guidabill

14.11.05

MIDSHIP SECTION STEEL SCREW TRAWLER N° 359


DIM^{NS} 126'-2" x 22'-0" EX. 12'-4" MOULDED. 11'-6" HOLD
SCALE 1/2" = 1 FOOT

TO CLASS 100A.1 AT LLOYD'S FOR FISHING PURPOSES
E & B CASING AS PREVIOUSLY APPROVED ✓
DECK PLATED AT SIDES OF E & B CASING ✓


LLOYD'S NUMERALS.
1/2 GIRTH 18.95
1/2 BREADTH 10.95
DEPTH 12.79
42.69 1ST N° ✓
125.04
5337.957 6.2ND N°
5337.

PROPORTIONS.
B to L 5.7 ✓
D to L 9.7 ✓
LENGTH OF RAISED QUARTER DECK 67' x 12'
FORECASTLE 19' x 10'

EQUIPMENT
1ST BOWER ANCHOR 5 1/2 CWTs EX STOCK ✓
2ND 5 ✓
3RD 2 1/2 ✓
105 FATHOMS 1 1/2 SHORT LINK CABLE ✓
60 6 HAWSER ✓
60 4 1/2 WARP ✓

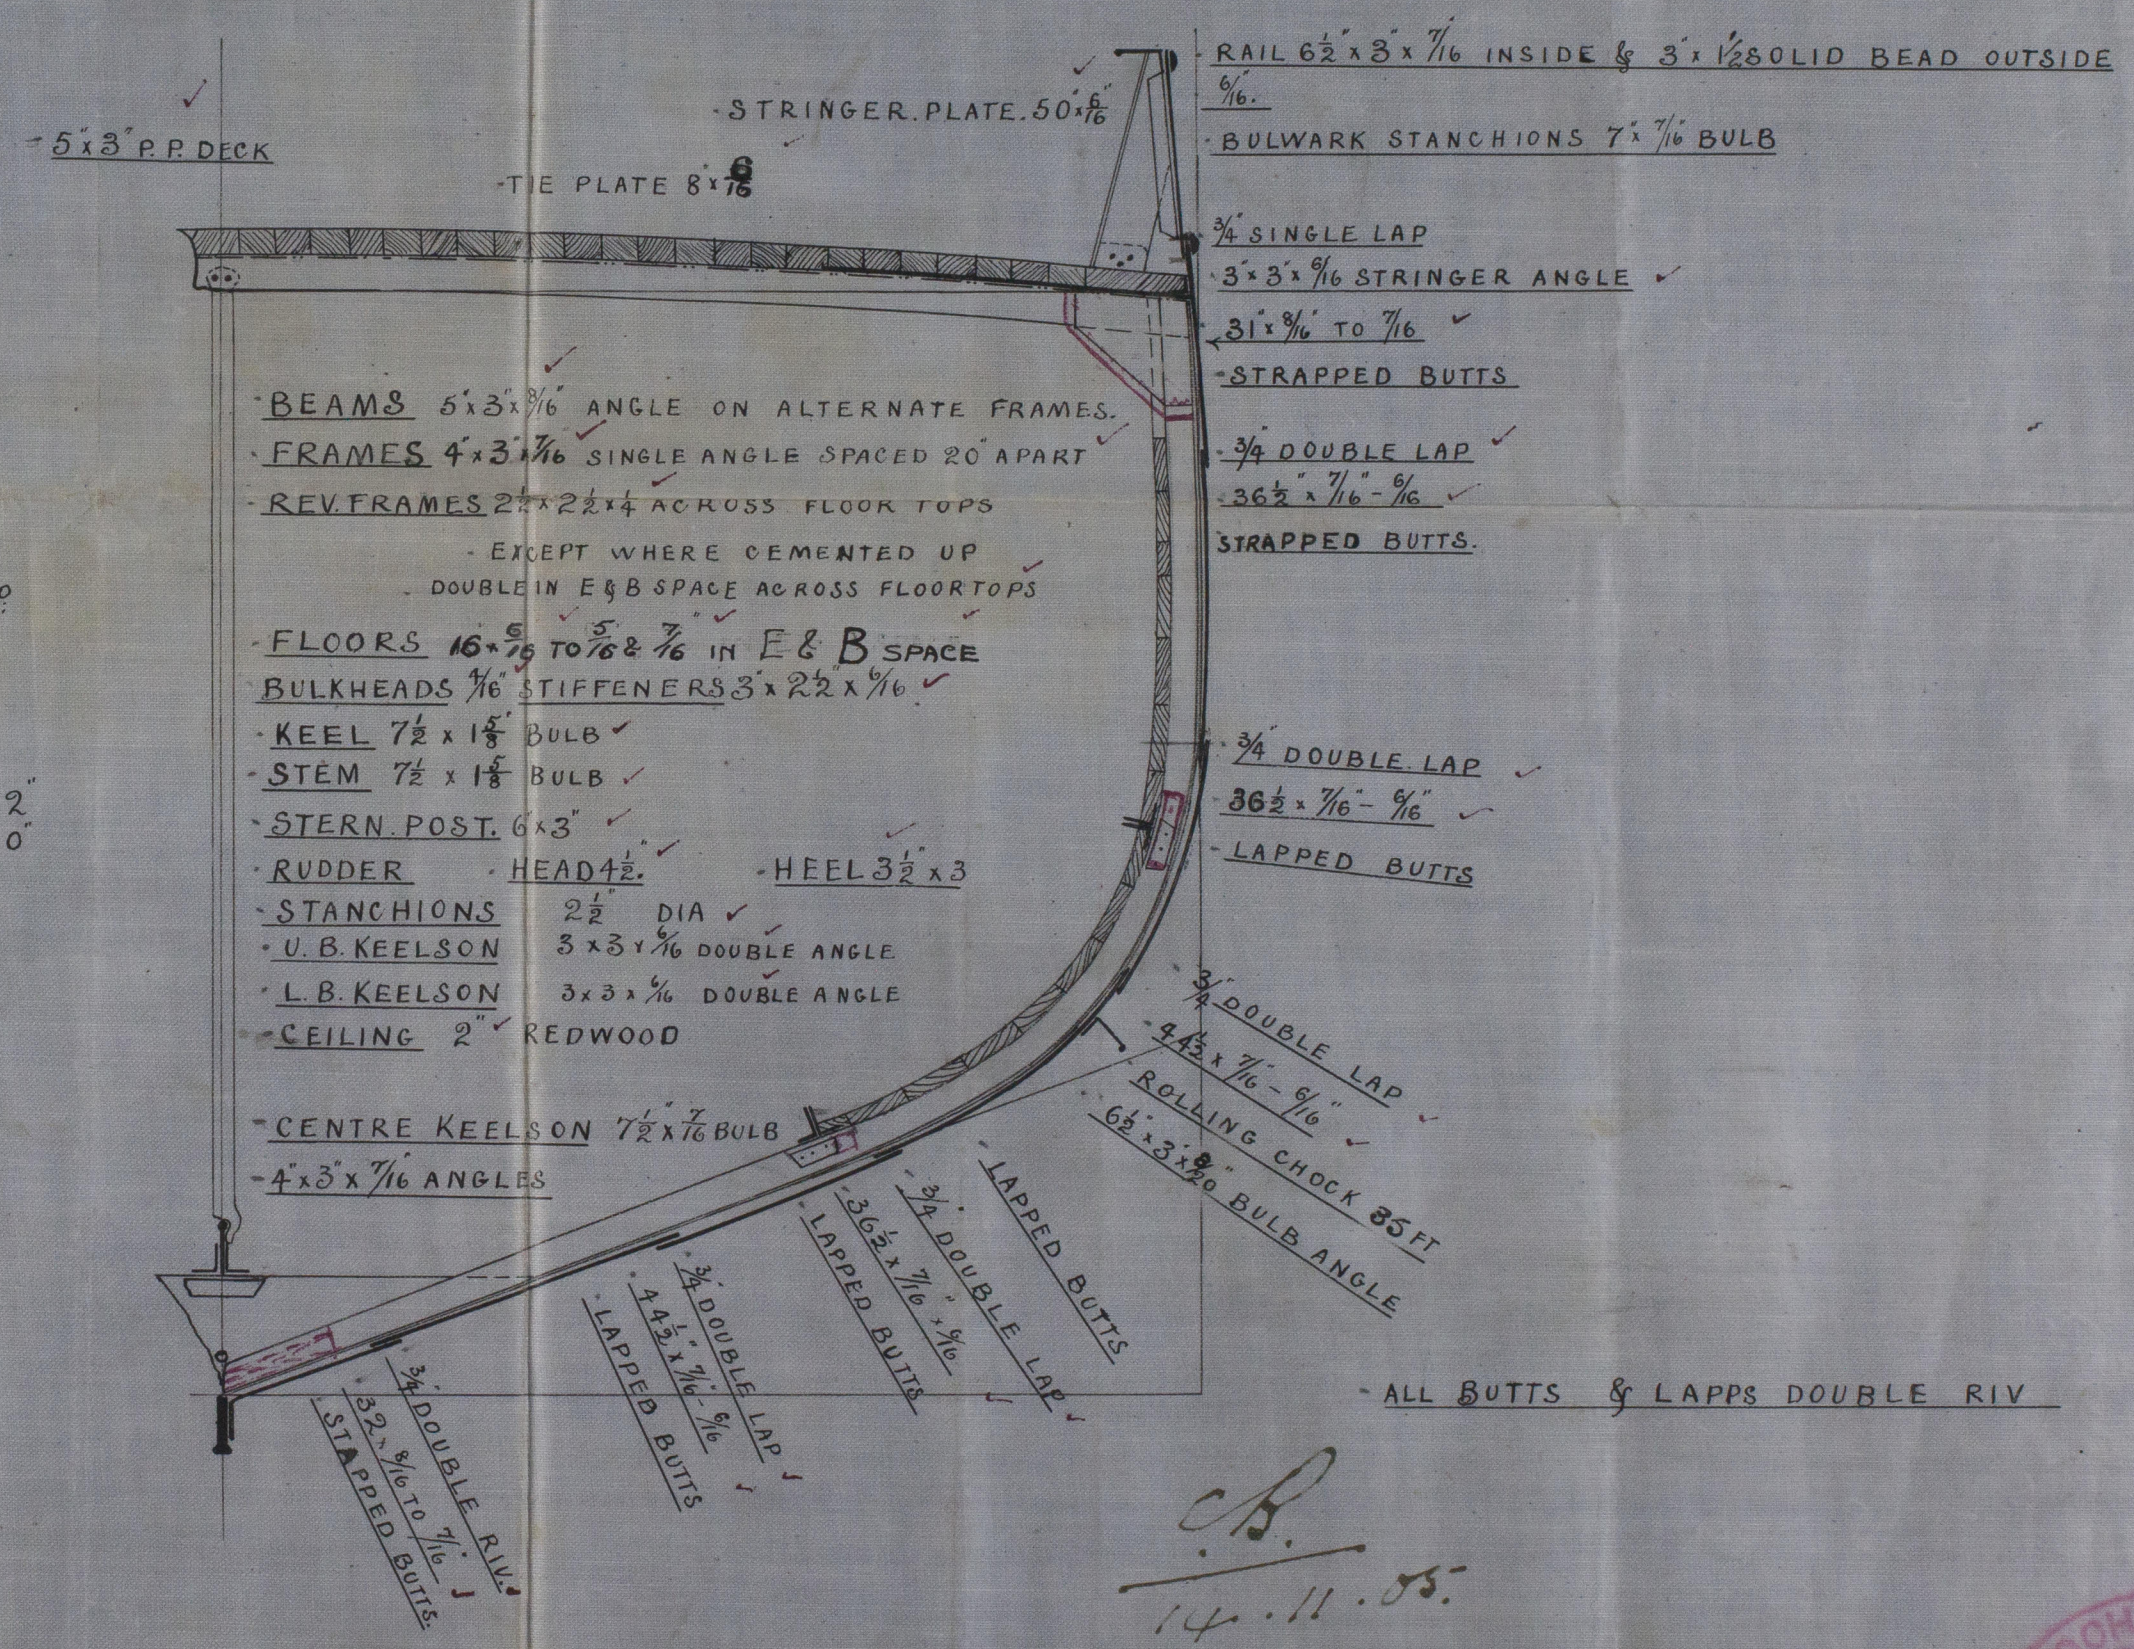

C.B.
14.11.05.

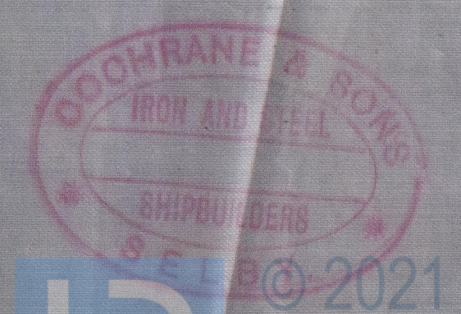

Cochrane & Son

Nº 359

Midship Section

MIDSHIP SECTION

STEEL SCREW TRAWL

Nº 359

DIMS: 18'-2" x 22'-0" x 12'-4" MOD

SCALE 1" = 1 FOOT

TO CLASS 100A1 AT LLOYD'S FOR FISH

E & B CASING AS PREVIOUSLY APPROVED

DECK PLATED AT SIDES OF E & B















LLOYD'S NUMERALS

18.98

10.95

12.75

12.75

PROPORTIONS

B.T.O.L.

D.T.O.L.

LENGTH OF RAISED QUARTER DECK 87' x 12'

FORECASTLE 19' x 10'

EQUIPMENT



Sp. Clifton

Hull Report No. 17705

MIDSHIP SECTION 359



© 2021

Lloyd's Register Foundation