



2-1-86

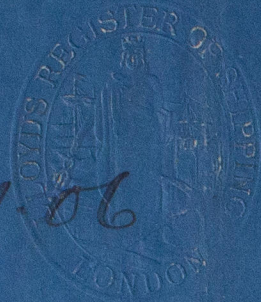

Midship Section of Steel Coasting
Steamer to class 100 A.1. at Lloyd's Yard No 15

Length 110'-0" O.P. x 21'-3" M.D. x
10'-0" M.D.

Scale 1/2 inch = 1 Foot

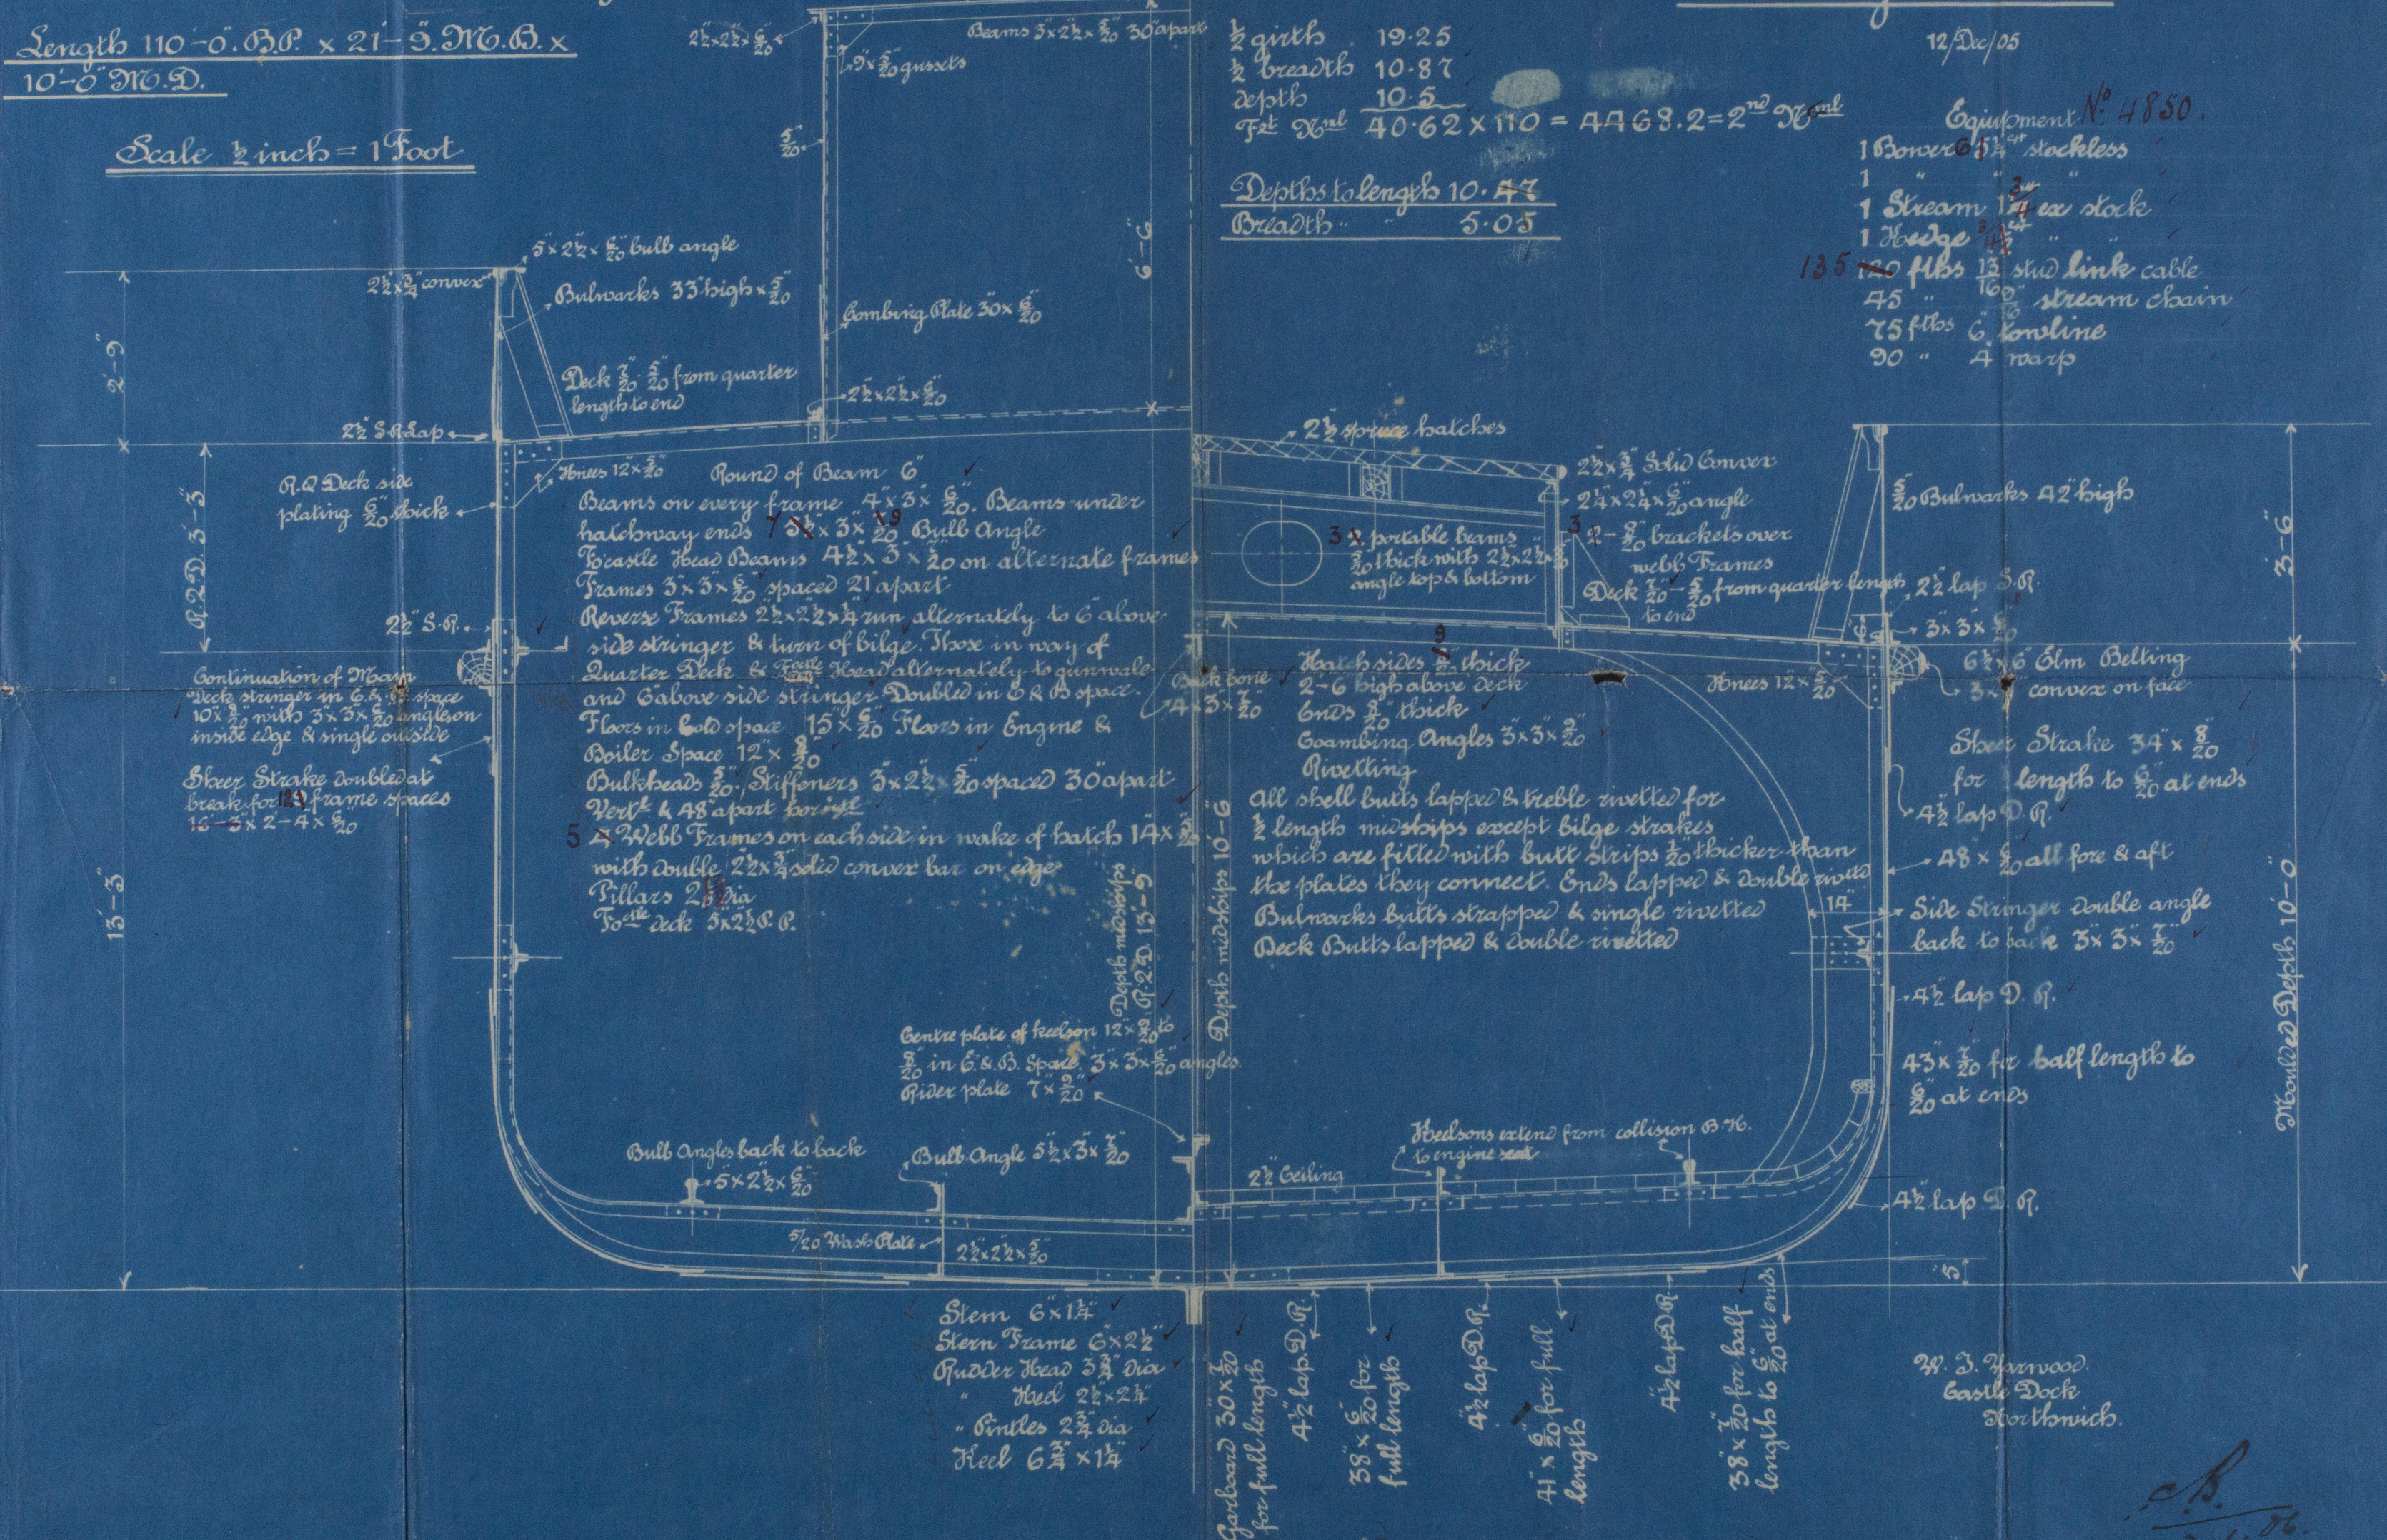

Drawing No 122

12 Dec 05

1/2 girth 19.25
 1/2 breadth 10.87
 depth 10.5
 Wet Vol 40.62 x 110 = 4468.2 = 2nd Vol

Depths to lengths 10.47
 Breadth 5.05

Equipment No 4850.


- 1 Converter 1 1/2" stockless
- 1 " " "
- 1 " " "
- 1 " " "
- 135 lbs 12" stud link cable
- 45 " " " "
- 75 lbs 6" kowline
- 90 " 4 warp

W. D. Greenwood.
 Castle Dock
 Northwich.



Lloyd's Register
 1905-1906

W433-0100

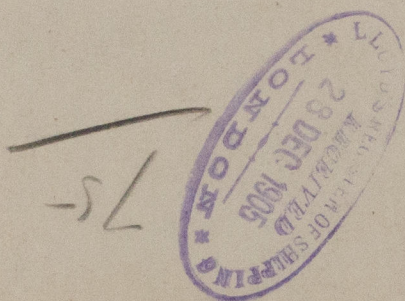

RETAIN

Messrs. W. J. Yarrow & Co.

Nº 45

Midship Section

W433-0100



© 2020

Lloyd's Register
Foundation