


Most Proper Hans 2 d
W 5-01.

Profile as built.

S. Bilswood

Indb report No 8982

W 934-0033

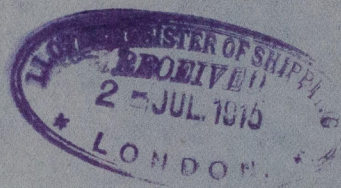

© 2020

Lloyd's Register
Foundation