

SCALE  $\frac{1}{4}" = 1 \text{ FOOT}$

COOK, WELTON & GEMMELL LTD  
SHIPBUILDERS  
BEVERLEY.


SUBMITTED SEPT 23-11  
APPROVED SEPT 30-11



N<sup>o</sup> 236


PROFILE & DECK

COOK WELTON & GEMMELL

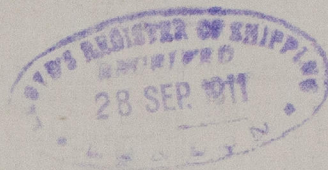

*J. Birch*

*Hull Lgt No: 24908*

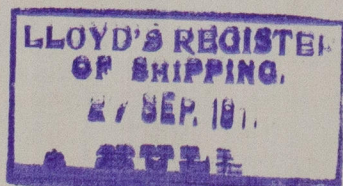

RETAIN



© 2020

Lloyd's Register  
Foundation

W35-0032