

# BEAM ARRANGEMENT

NO 2012

SCALE 1/4" = 1 FOOT


COOK WELTON & GEMMELL LTD

SHIPBUILDERS


BEVERLEY

DATE SUBMITTED MARCH 12 1910

APPROVED

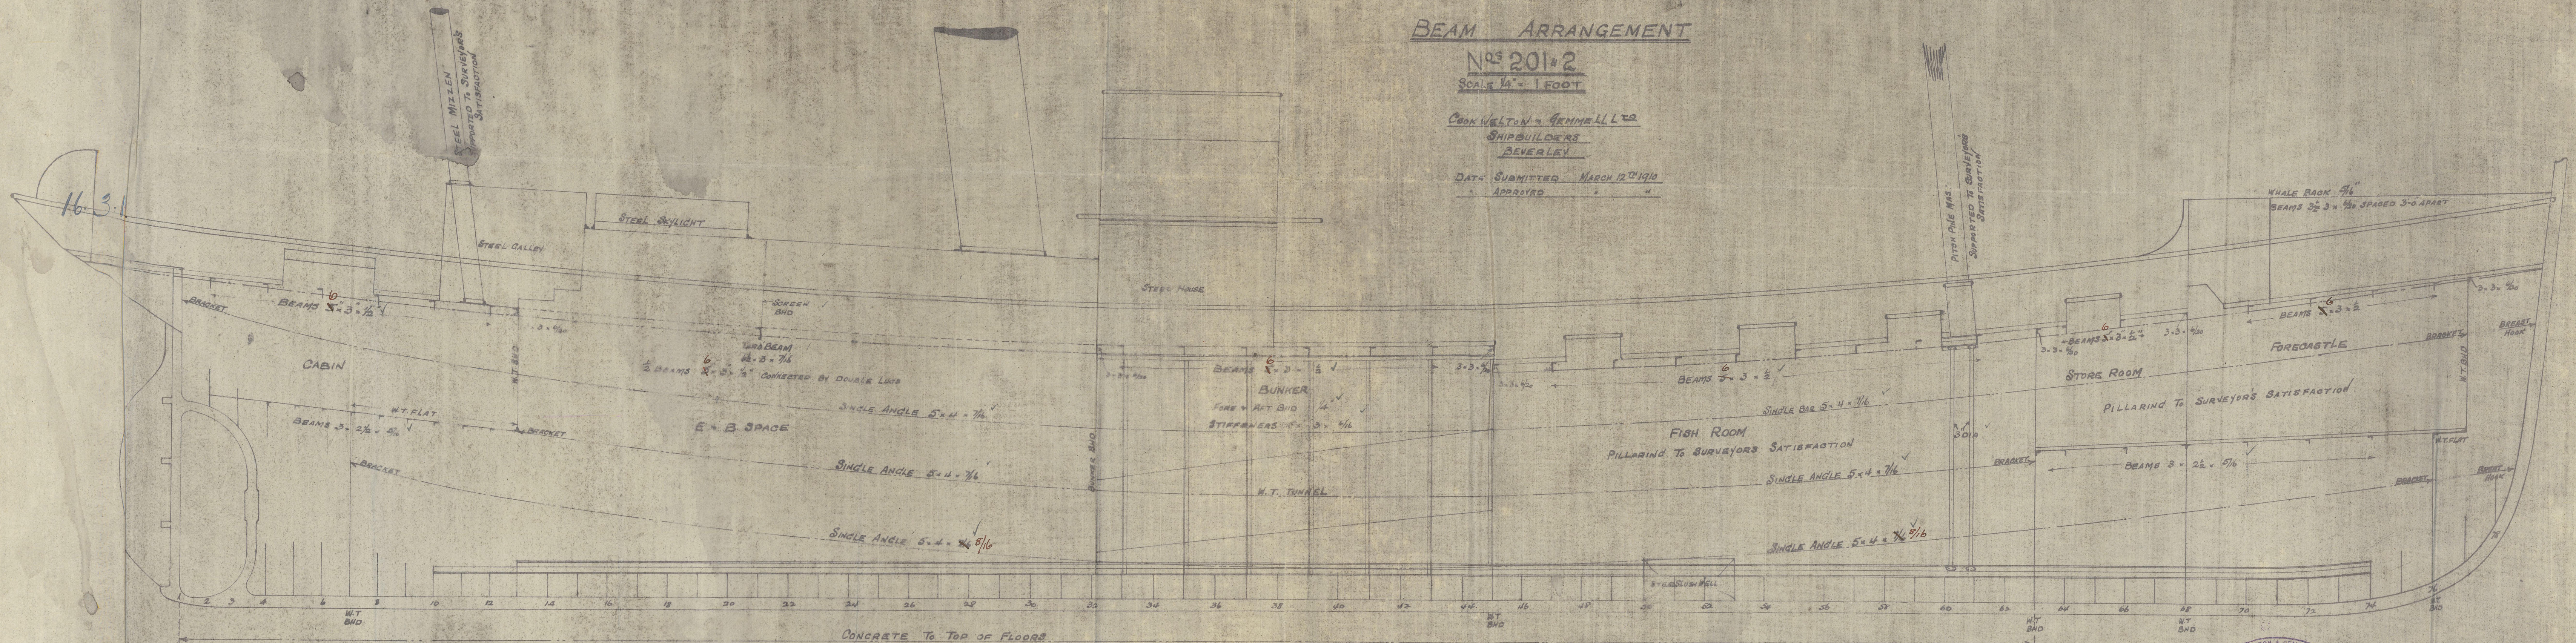

12 MAR 1910

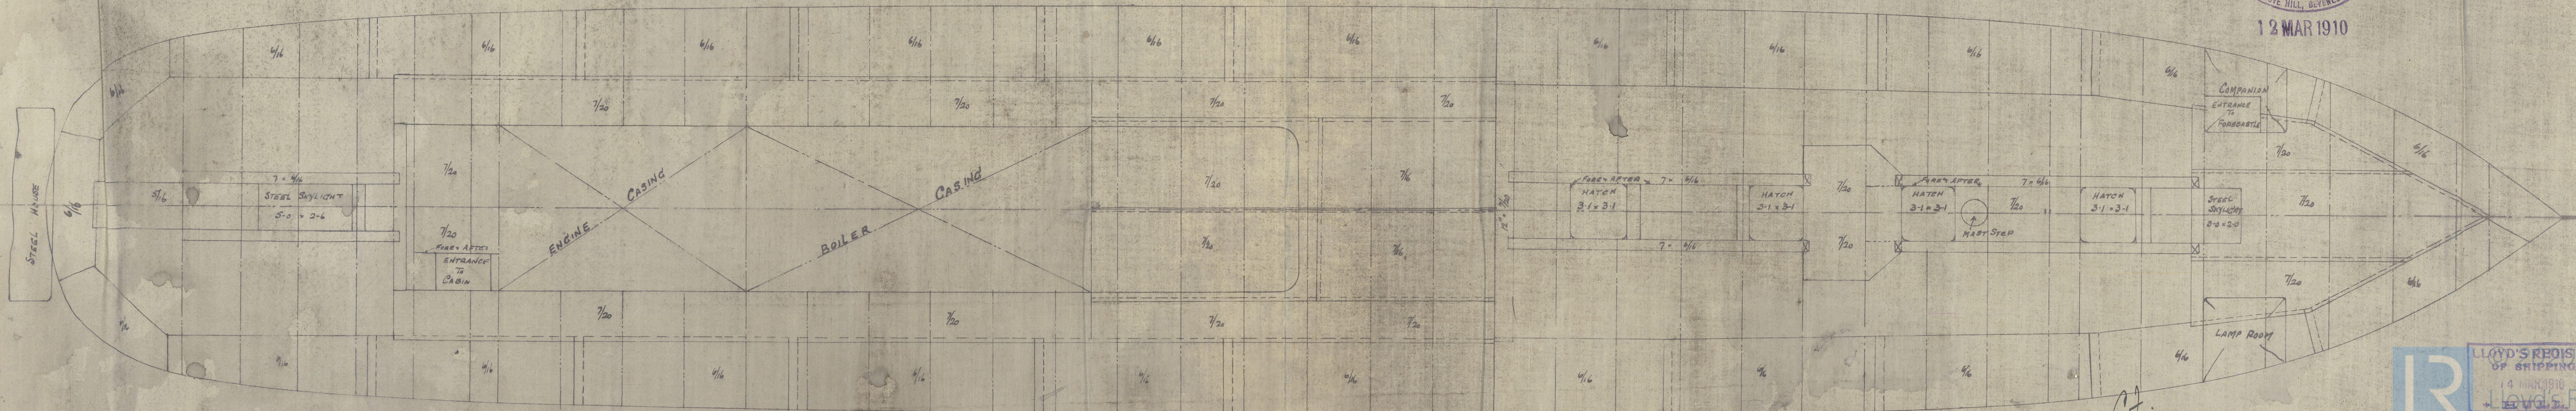

C.T.  
16/3/10




RECEIVED


N<sup>os</sup> 201 & 202

PROFILE

COOK WELTON & GEMMELL

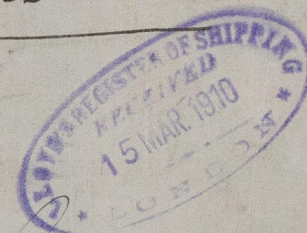

s/s *Corrientes*  
*Hull Report*  
*No: 22999*

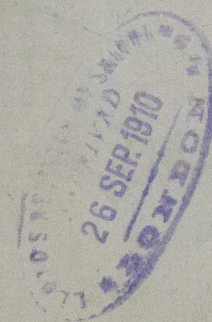

© 2020

Lloyd's Register  
Foundation

W935-0128