


N^{os} 498 TO 502

STEEL.

4548.9 A. PLATING N°

60 5 1/2 HAWSER

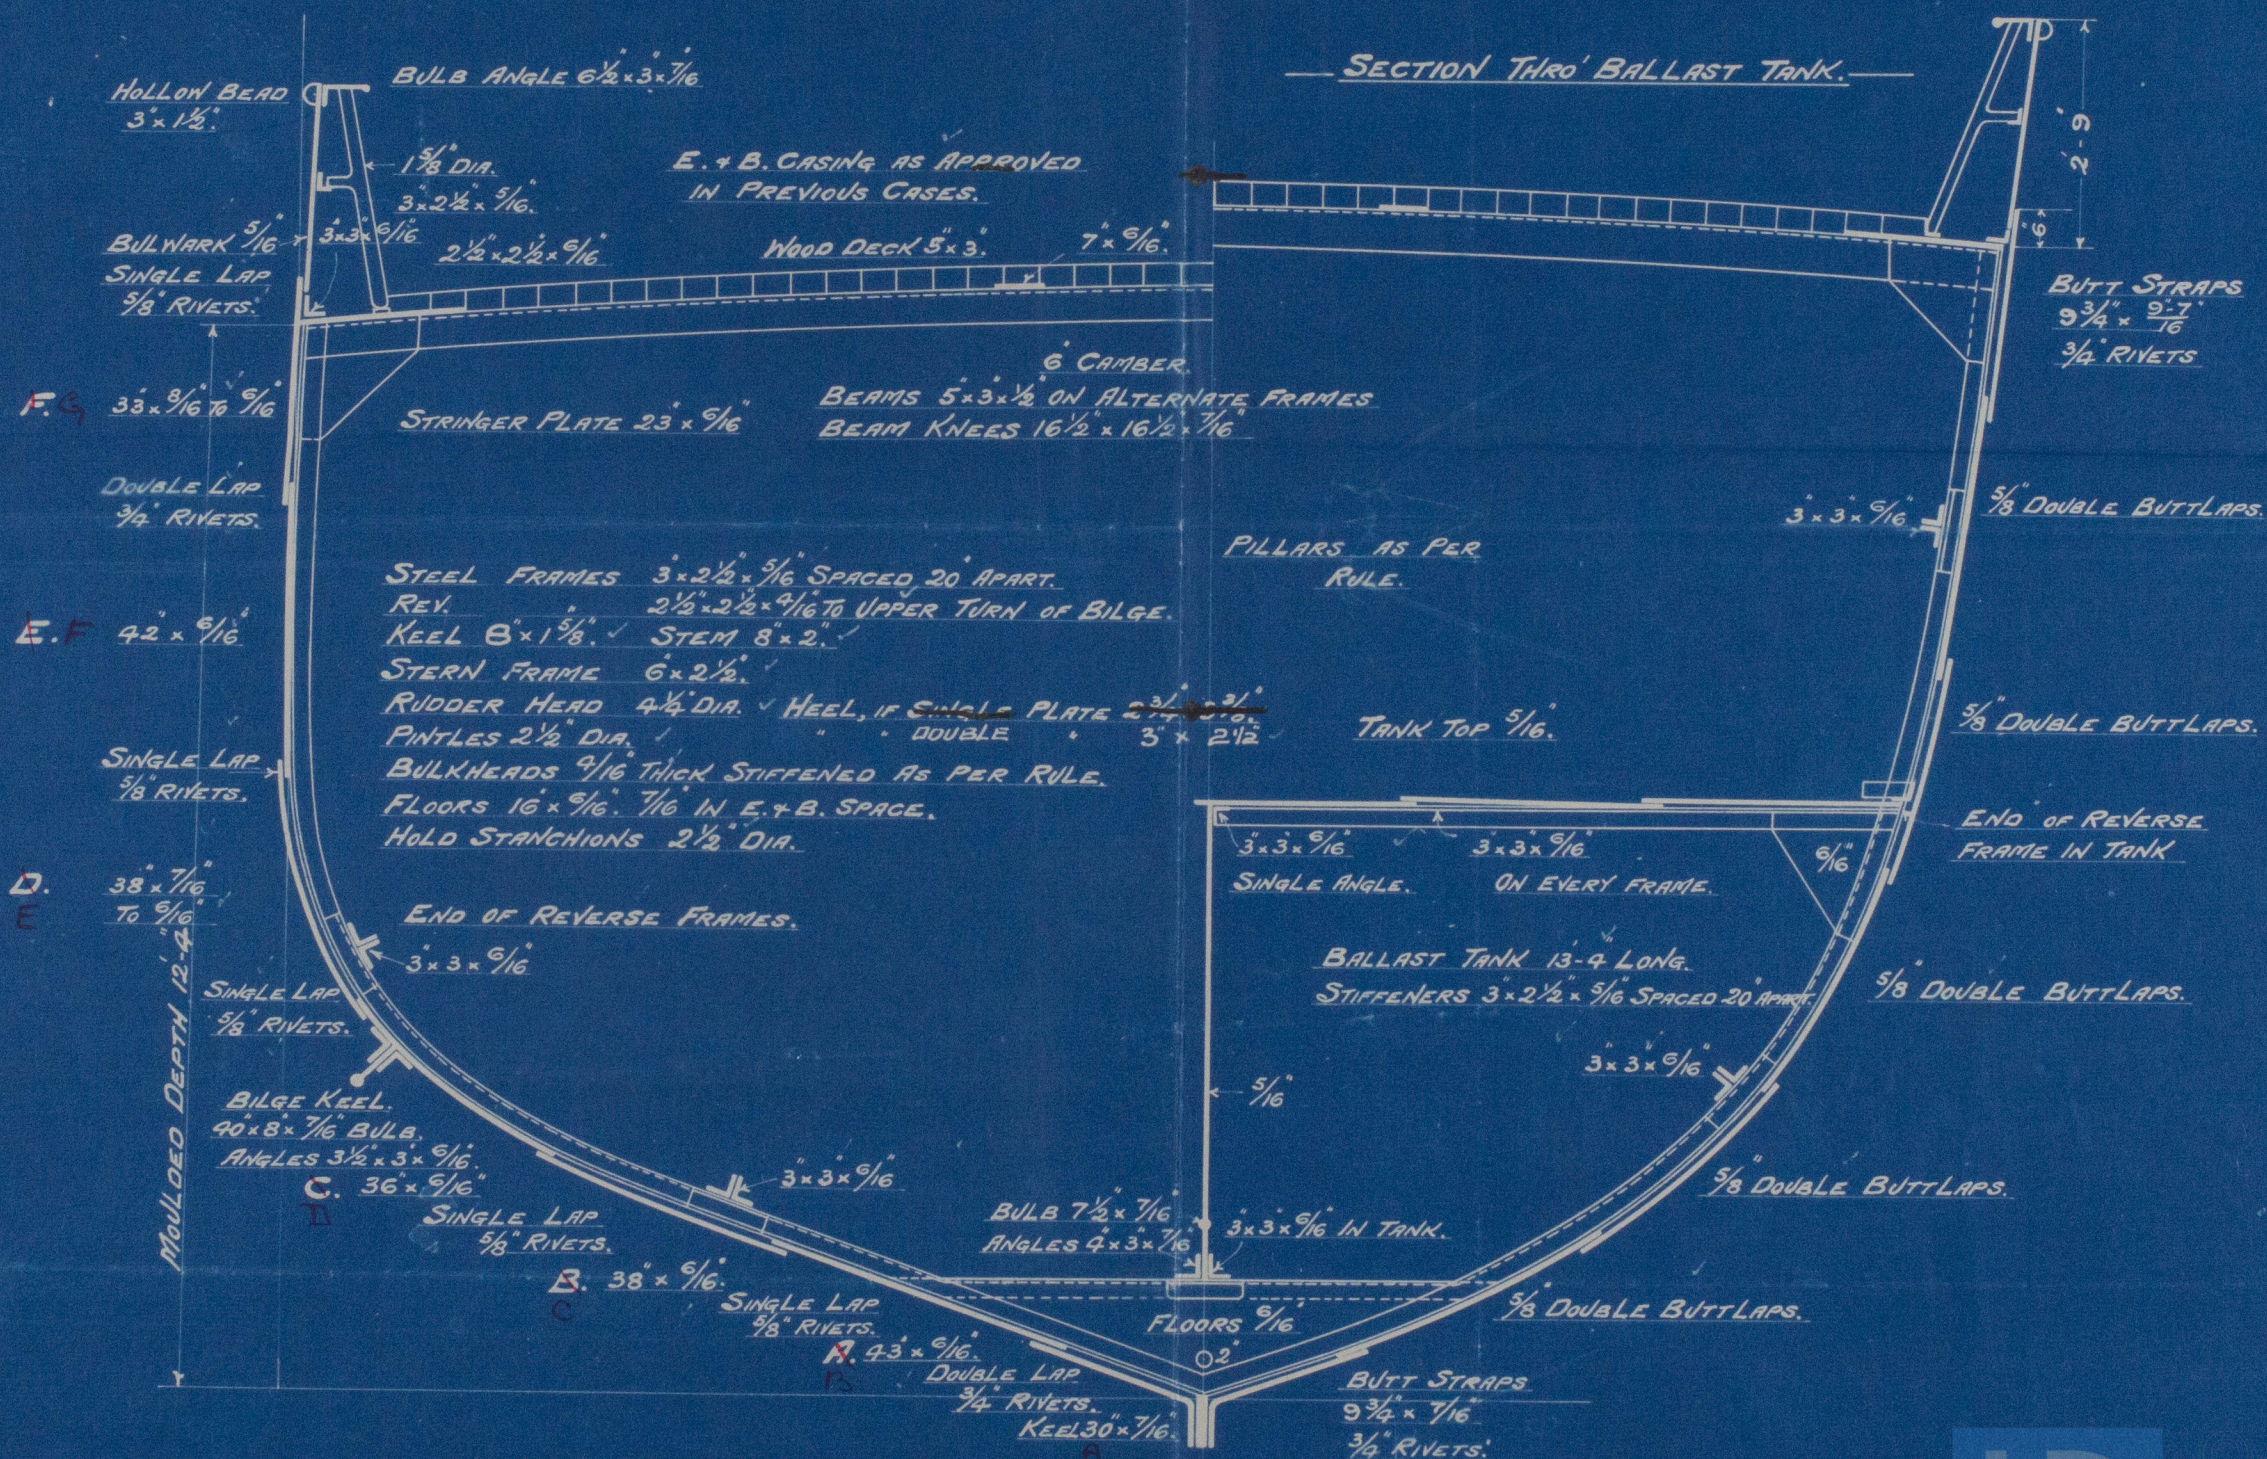

Nov 10 1881

Charles S. & R. Co.

N^o 498 to 502

Duplicate -

Midship Section.

S/S "Coquet" N^o 500

Hull Report No. 17216

RETAIN



© 2020

Lloyd's Register
Foundation

W936-0187