
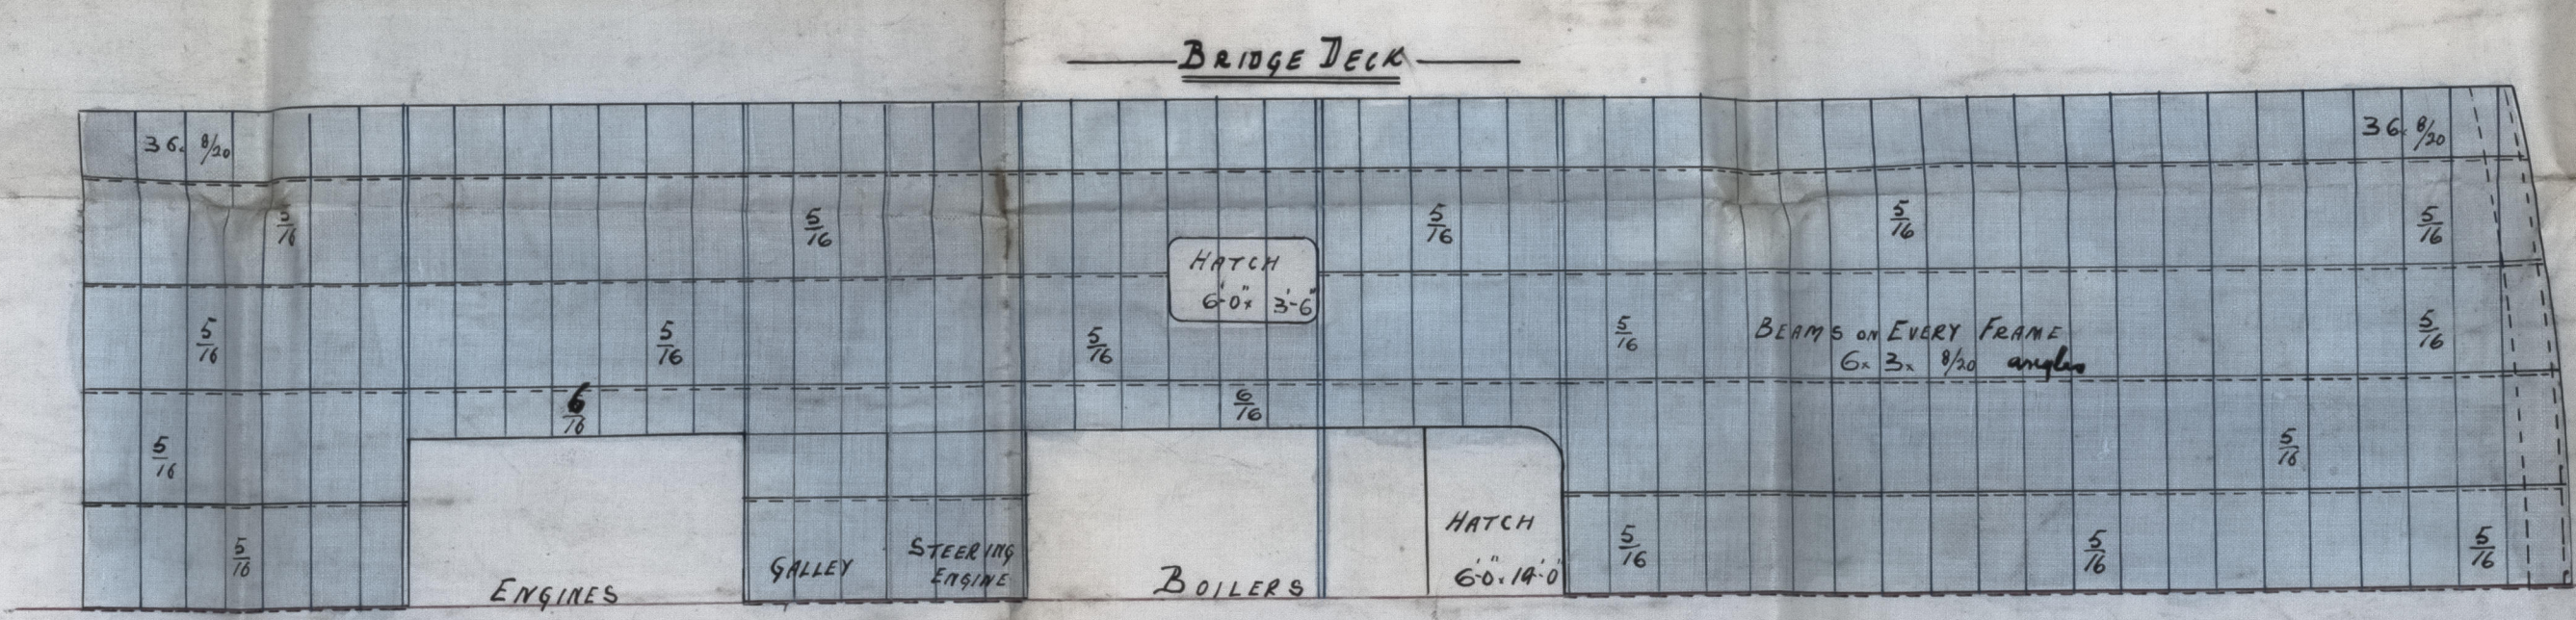
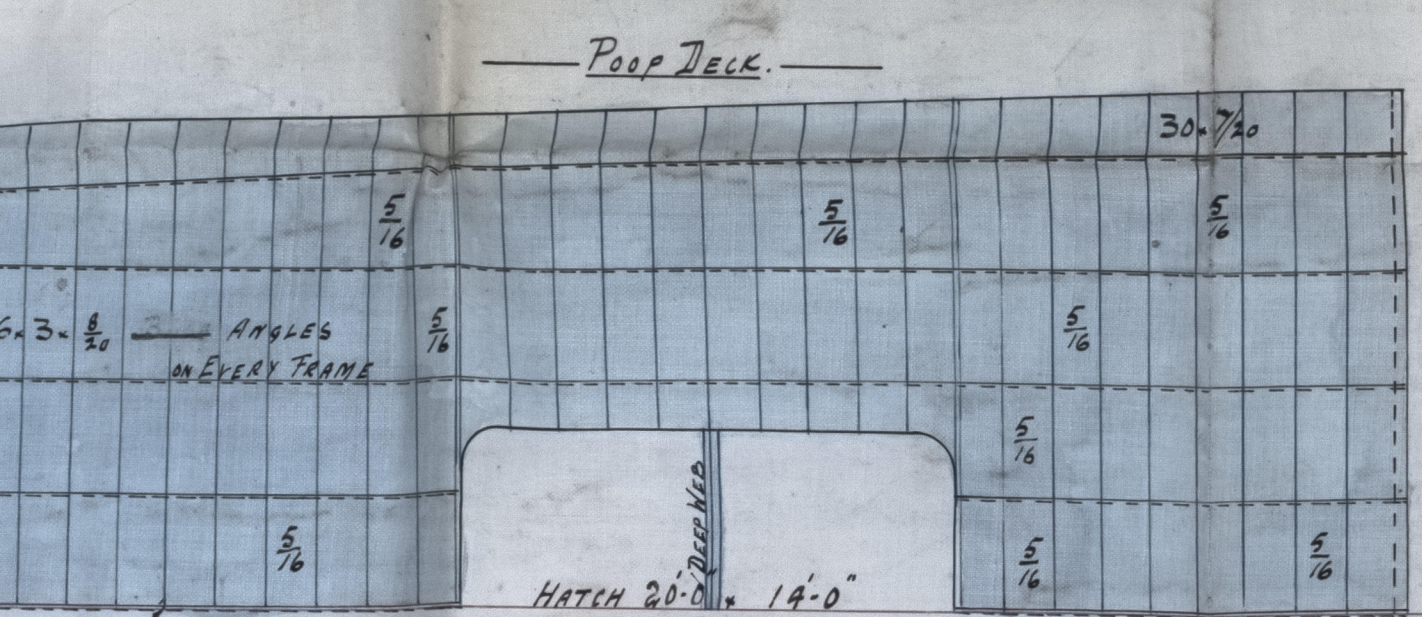


Profile & Deck Plans $\frac{1}{2}$ N^o 355.


DIMENSIONS:
AS PER RULE.
LENGTH
344.12
BREADTH
44.82
DEPTH TO MAIN DECK
20.58
" " SPAR " 28.91.

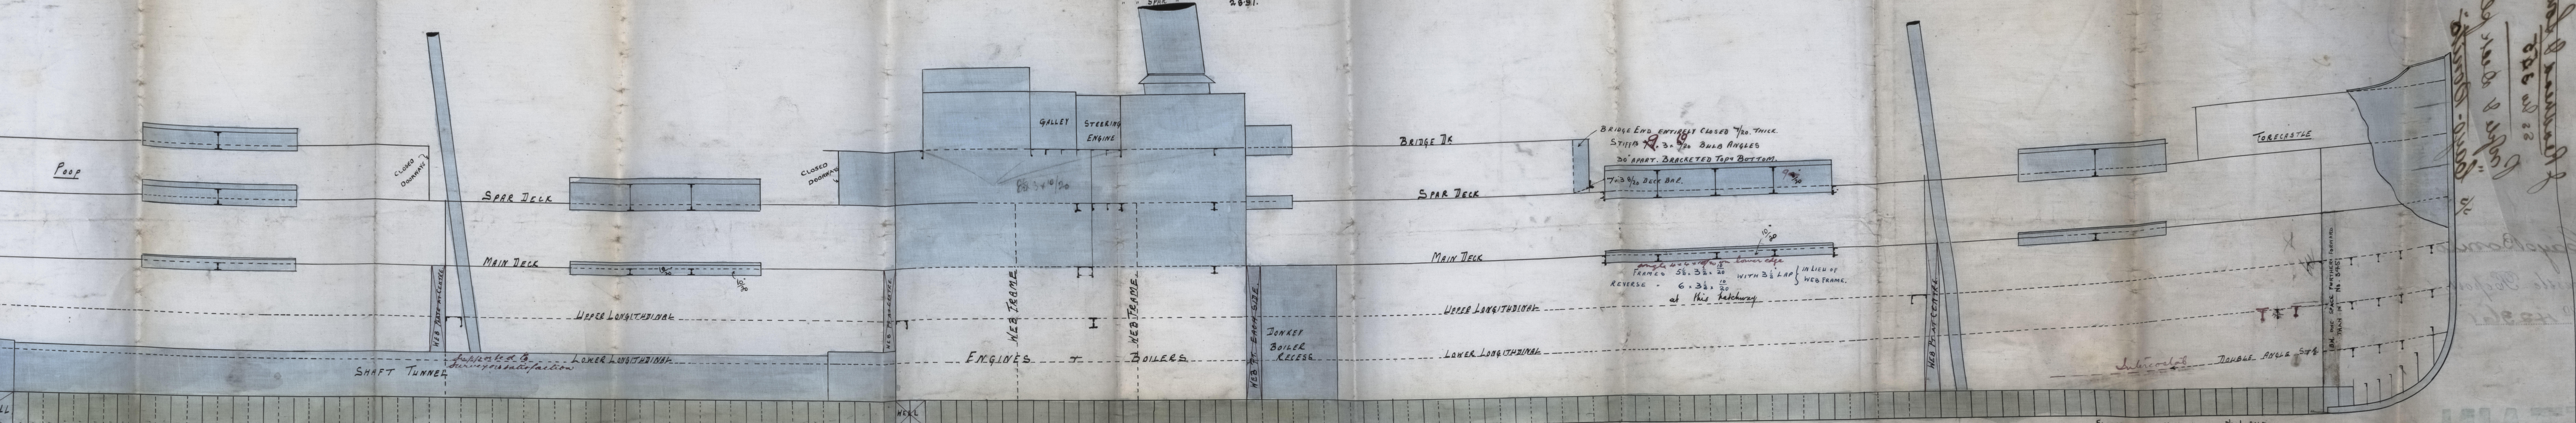

PARTICULARS FOR FREEBOARD.

LENGTH BETWEEN PERPS	346-0
BREADTH EXTREME	45-0
DEPTH MOULDED TO SPAR DECK (AT MIDDLE OF LENGTH)	28-0
" " " MAIN " "	19-8
TONNAGE UNDER SPAR DECK (CELLULAR BOTTOM TO SPAR DECK)	25-4 1/2
COEFFICIENT OF FINENESS	81
BRIDGE (ENCLOSURE WITH IRON B.H. AT FORE PART, B.H. & CLOSED DOOR AT AFTER PART)	98 FT LONG 7'-0 HIGH
POOP (B.H. & CLOSED DOORS)	77 FT " " "
TOPGALLANT FORECASTLE (B.H. & CLOSED DOORS)	35 " " "
SCANTLINGS CLASS 100 A1. SPAR DECK. SPECIAL SURVEY.	
SPAR DECK OF IRON & STEEL NOT COVERED WITH WOOD.	
MAIN OF STEEL	
ROUND OF BEAM 11"	
SHEER AFT 3-3	
TORD. 4'-9	
1/2 LEN FROM AFT 1'-8 1/2	
1/2 LEN FROM FORE 3'-7	

FLOORS ON EVERY FRAME IN NO. 1 HOLD
GIRDERS AS PER NOTICE 101R.

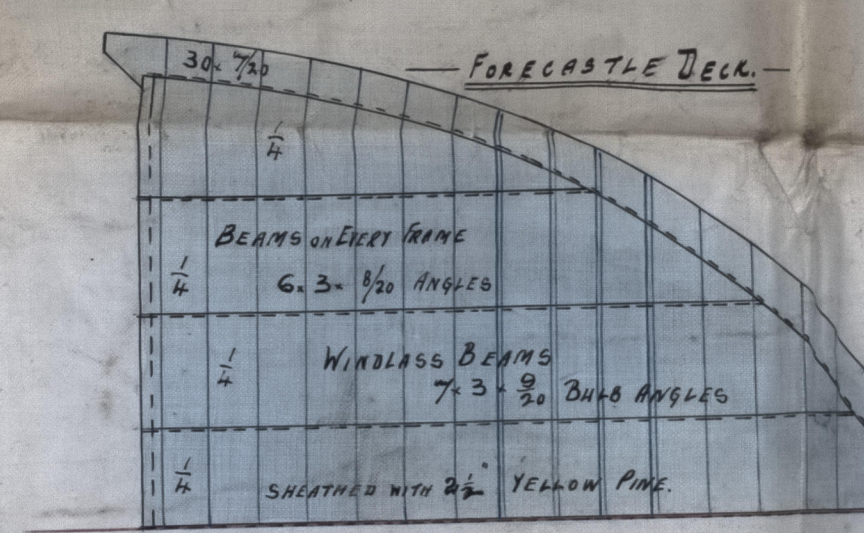

Handwritten notes:
could not be made
as per rule
20' 58"


J. Readhead & Sons
SS No 345

"Cayo-Bonito"
SS

Cayo Bonito

Newcastle Report

No 42361

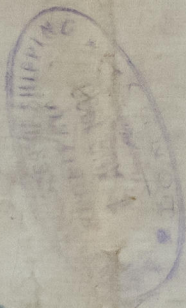

W937-0079

RETAIN



© 2021

Lloyd's Register
Foundation