


Surface.
 439 sq. feet
 60 " "
 59 " "
 21 " "
 609 " "


Surface 22 sq. feet.

1/8" screwed stays. 8 threads per inch

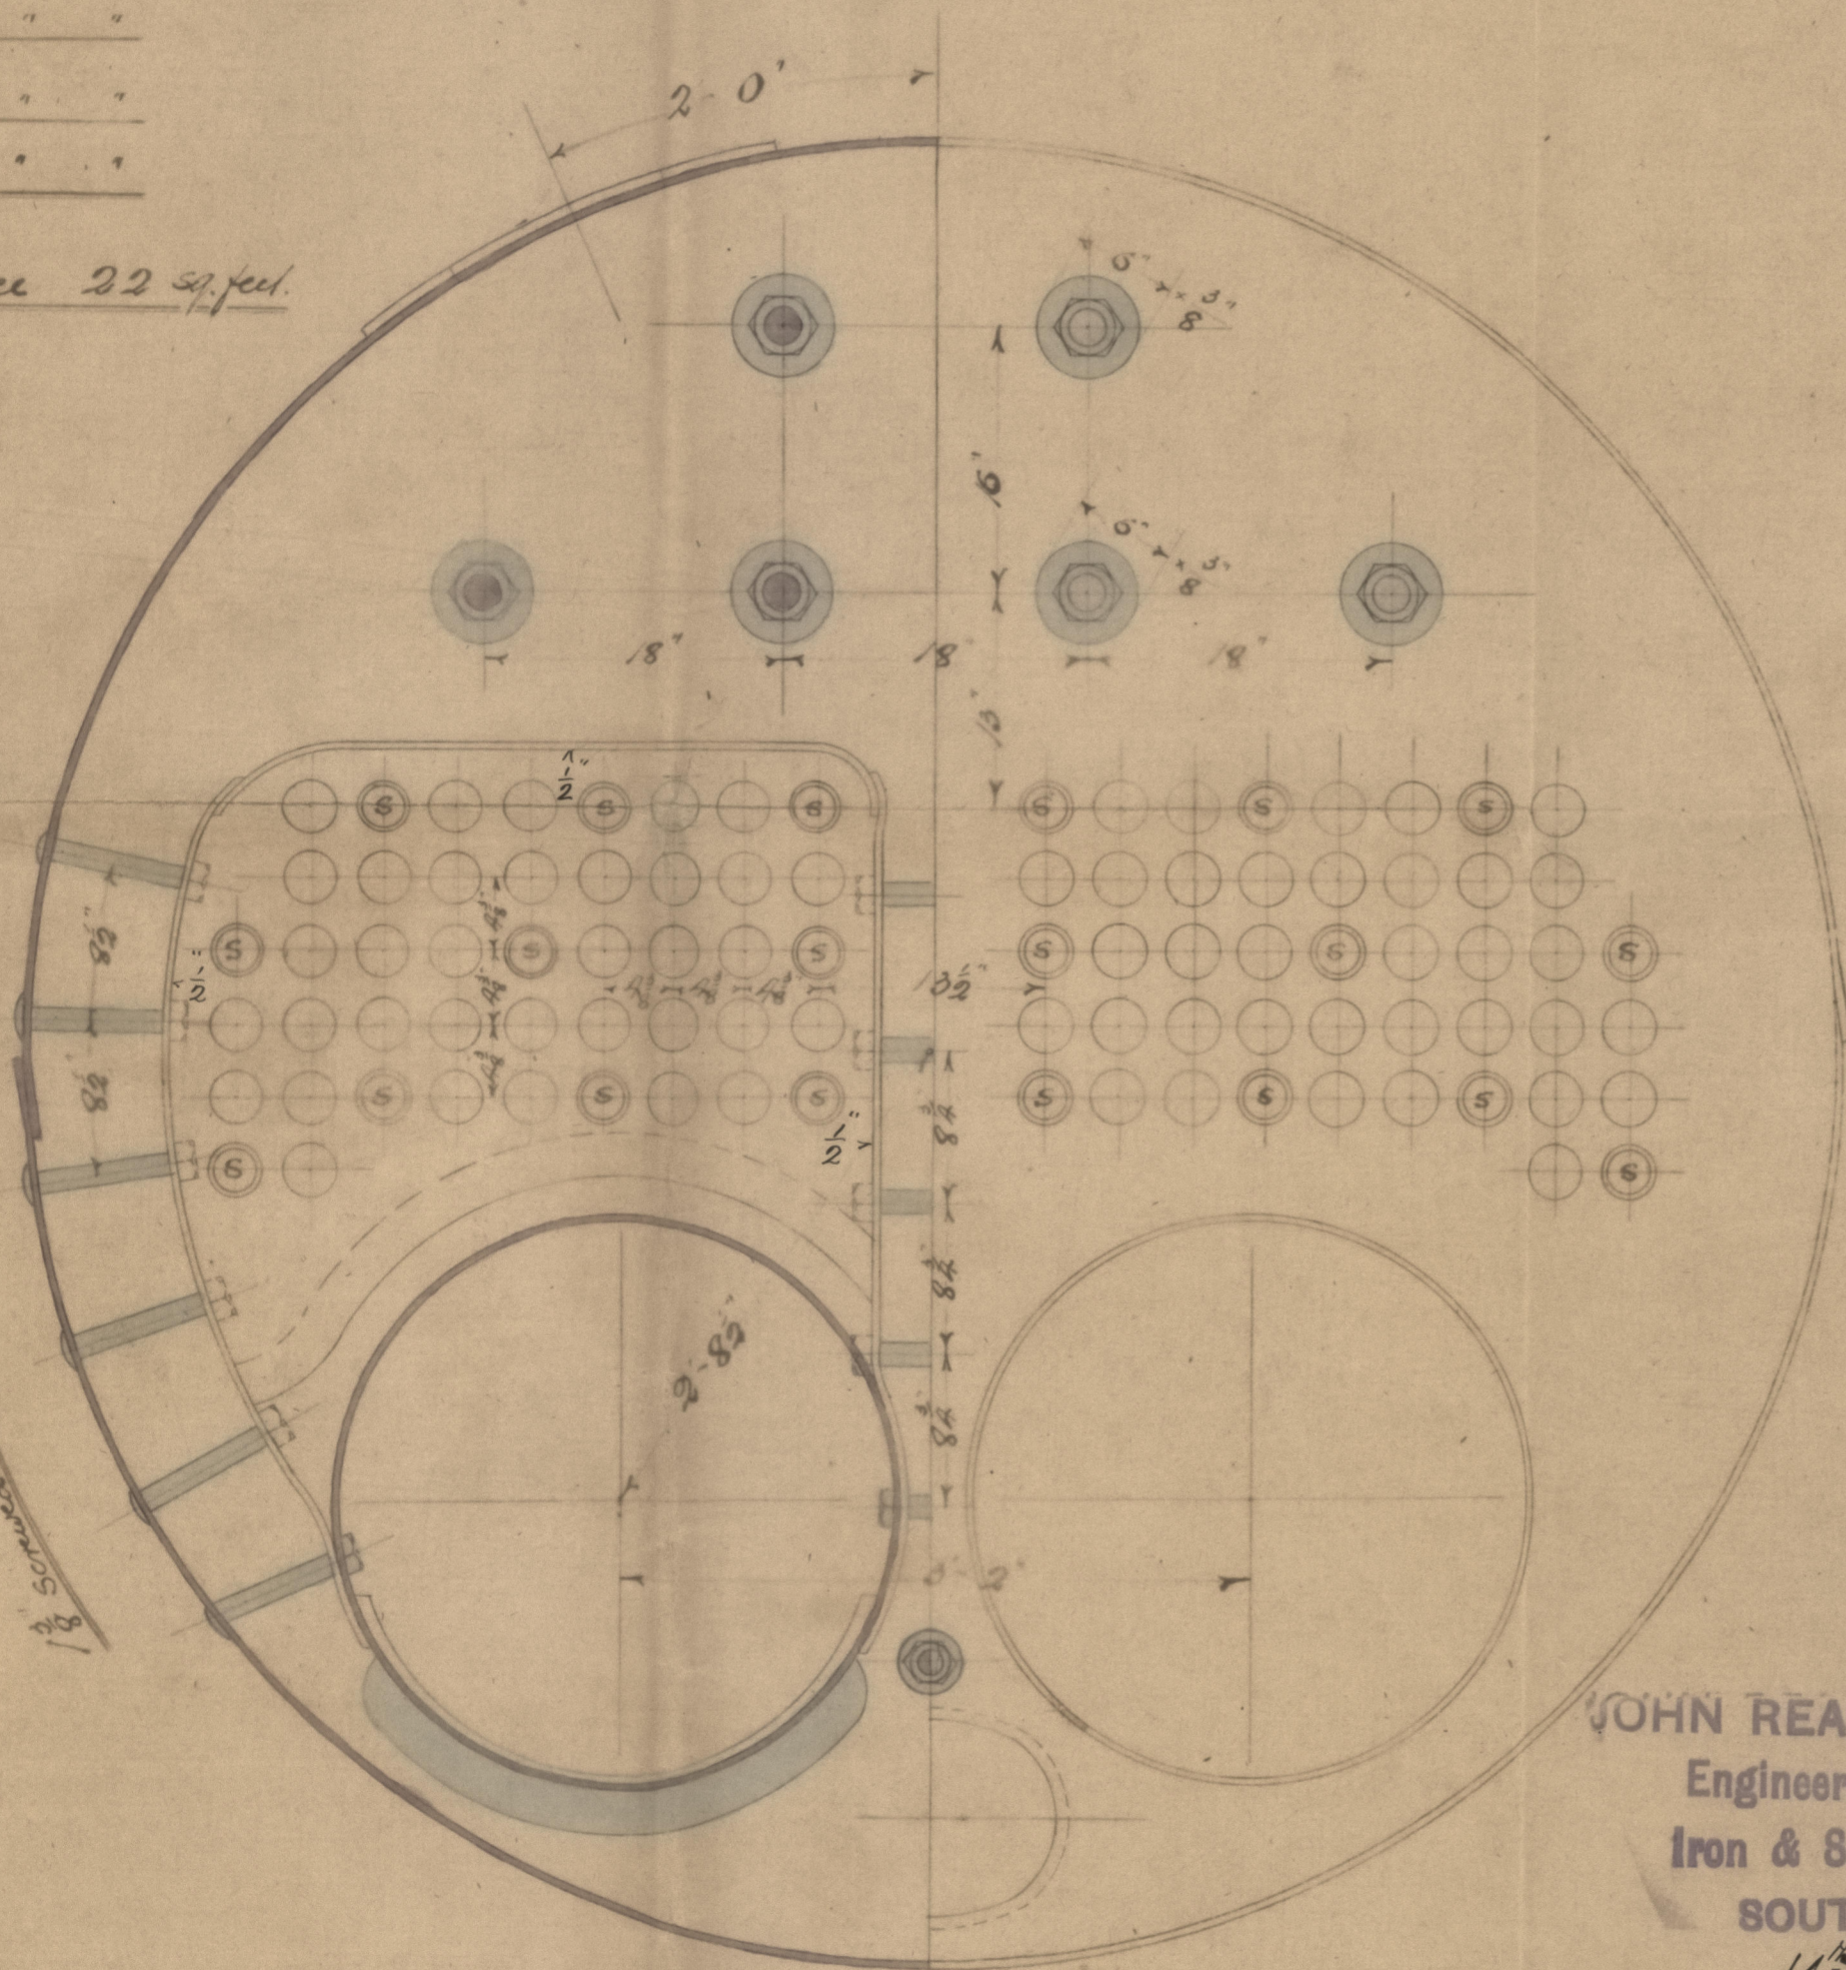

JOHN READHEAD & SONS,
 Engineers, Boiler Makers,
 Iron & Steel Shipbuilders,
 SOUTH SHIELDS.
 14th Sep 1900.

9'-0" diam.

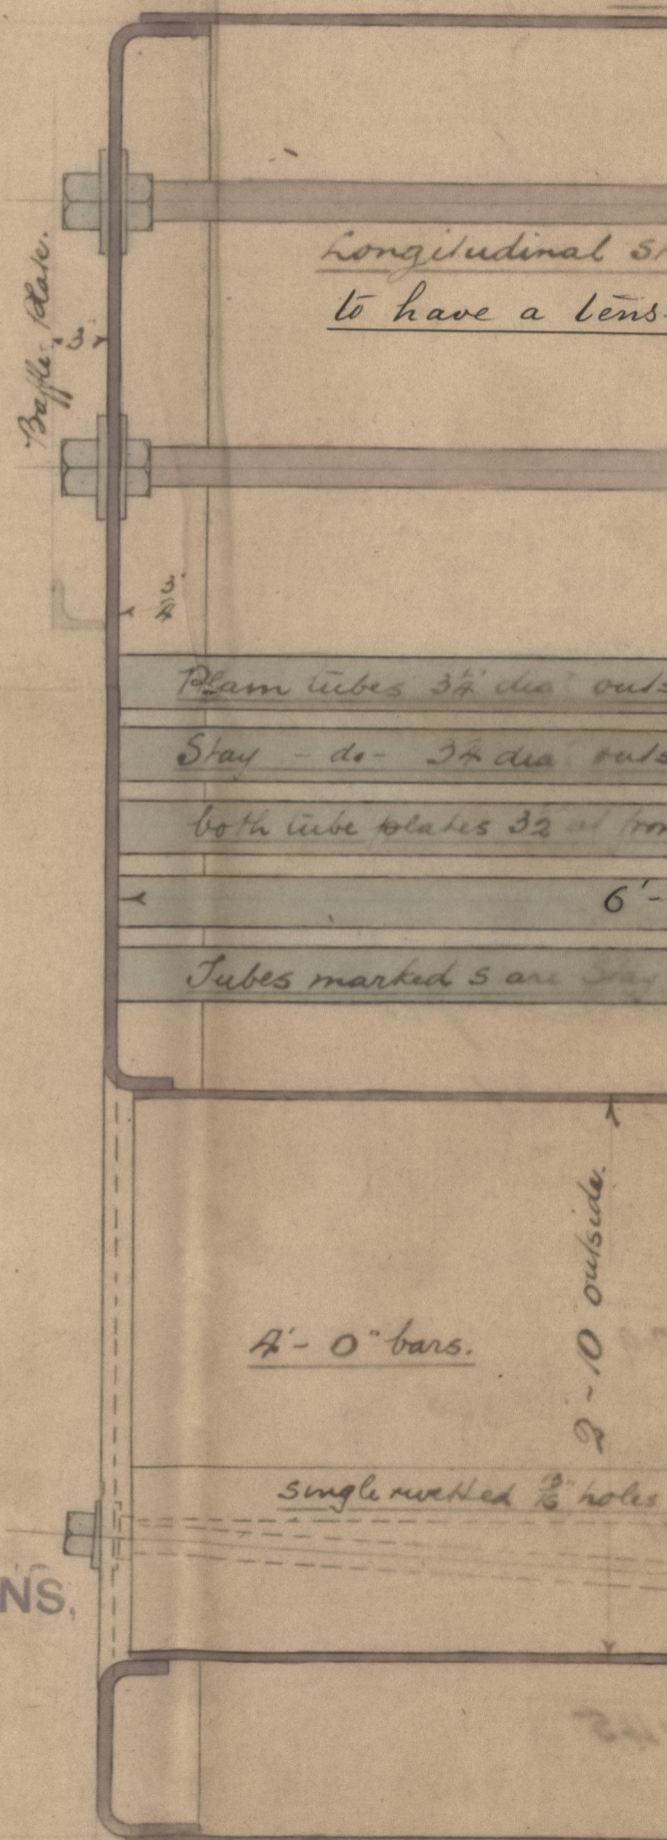

— DONKEY BOILER —



© 2021
 Lloyd's Register
 Foundation

S/S 355 + 356

No 6029
Lloyd's List
160 lbs
G.A.H.
73.01

355
S/S Cayo Bonito
Nov. 42361

No 6145
Lloyd's List
160 lbs
G.A.H.
19.8.01

356

J.P. Leopoldina

Newcastle Report

No 42536

REMAIN



© 2021

Lloyd's Register
Foundation

W937-0081