

548 15-2-08
19-3-08

N^{os} 545-6-7-548

MIDSHIP SECTION

Scale 1/2 in. = 1 ft.

Dimensions 111' 3" B.P. x 22' 6" ex. x 12' 10" mld.
Class 100 A1 Steel for Fishing Purposes.

Equipment


- 1 Anchor 5 cwt. ex. Stock
- 1 " 1 1/2 " " "
- 1 " 2 1/2 " " "
- 90 fathoms 1" Chain
- 60 " 5/8" Hawser
- 60 " 1/2" Warp

Lloyd's Numerals

1/2 Breadth - 11.19
Depth - 13.31
1/2 Girth - 20.12
Lloyd's Length 44.62 = 1st N^o
4911.77 = 2nd N^o

Proportions

Depth in Length = 2.27
Breadth " " = 4.92

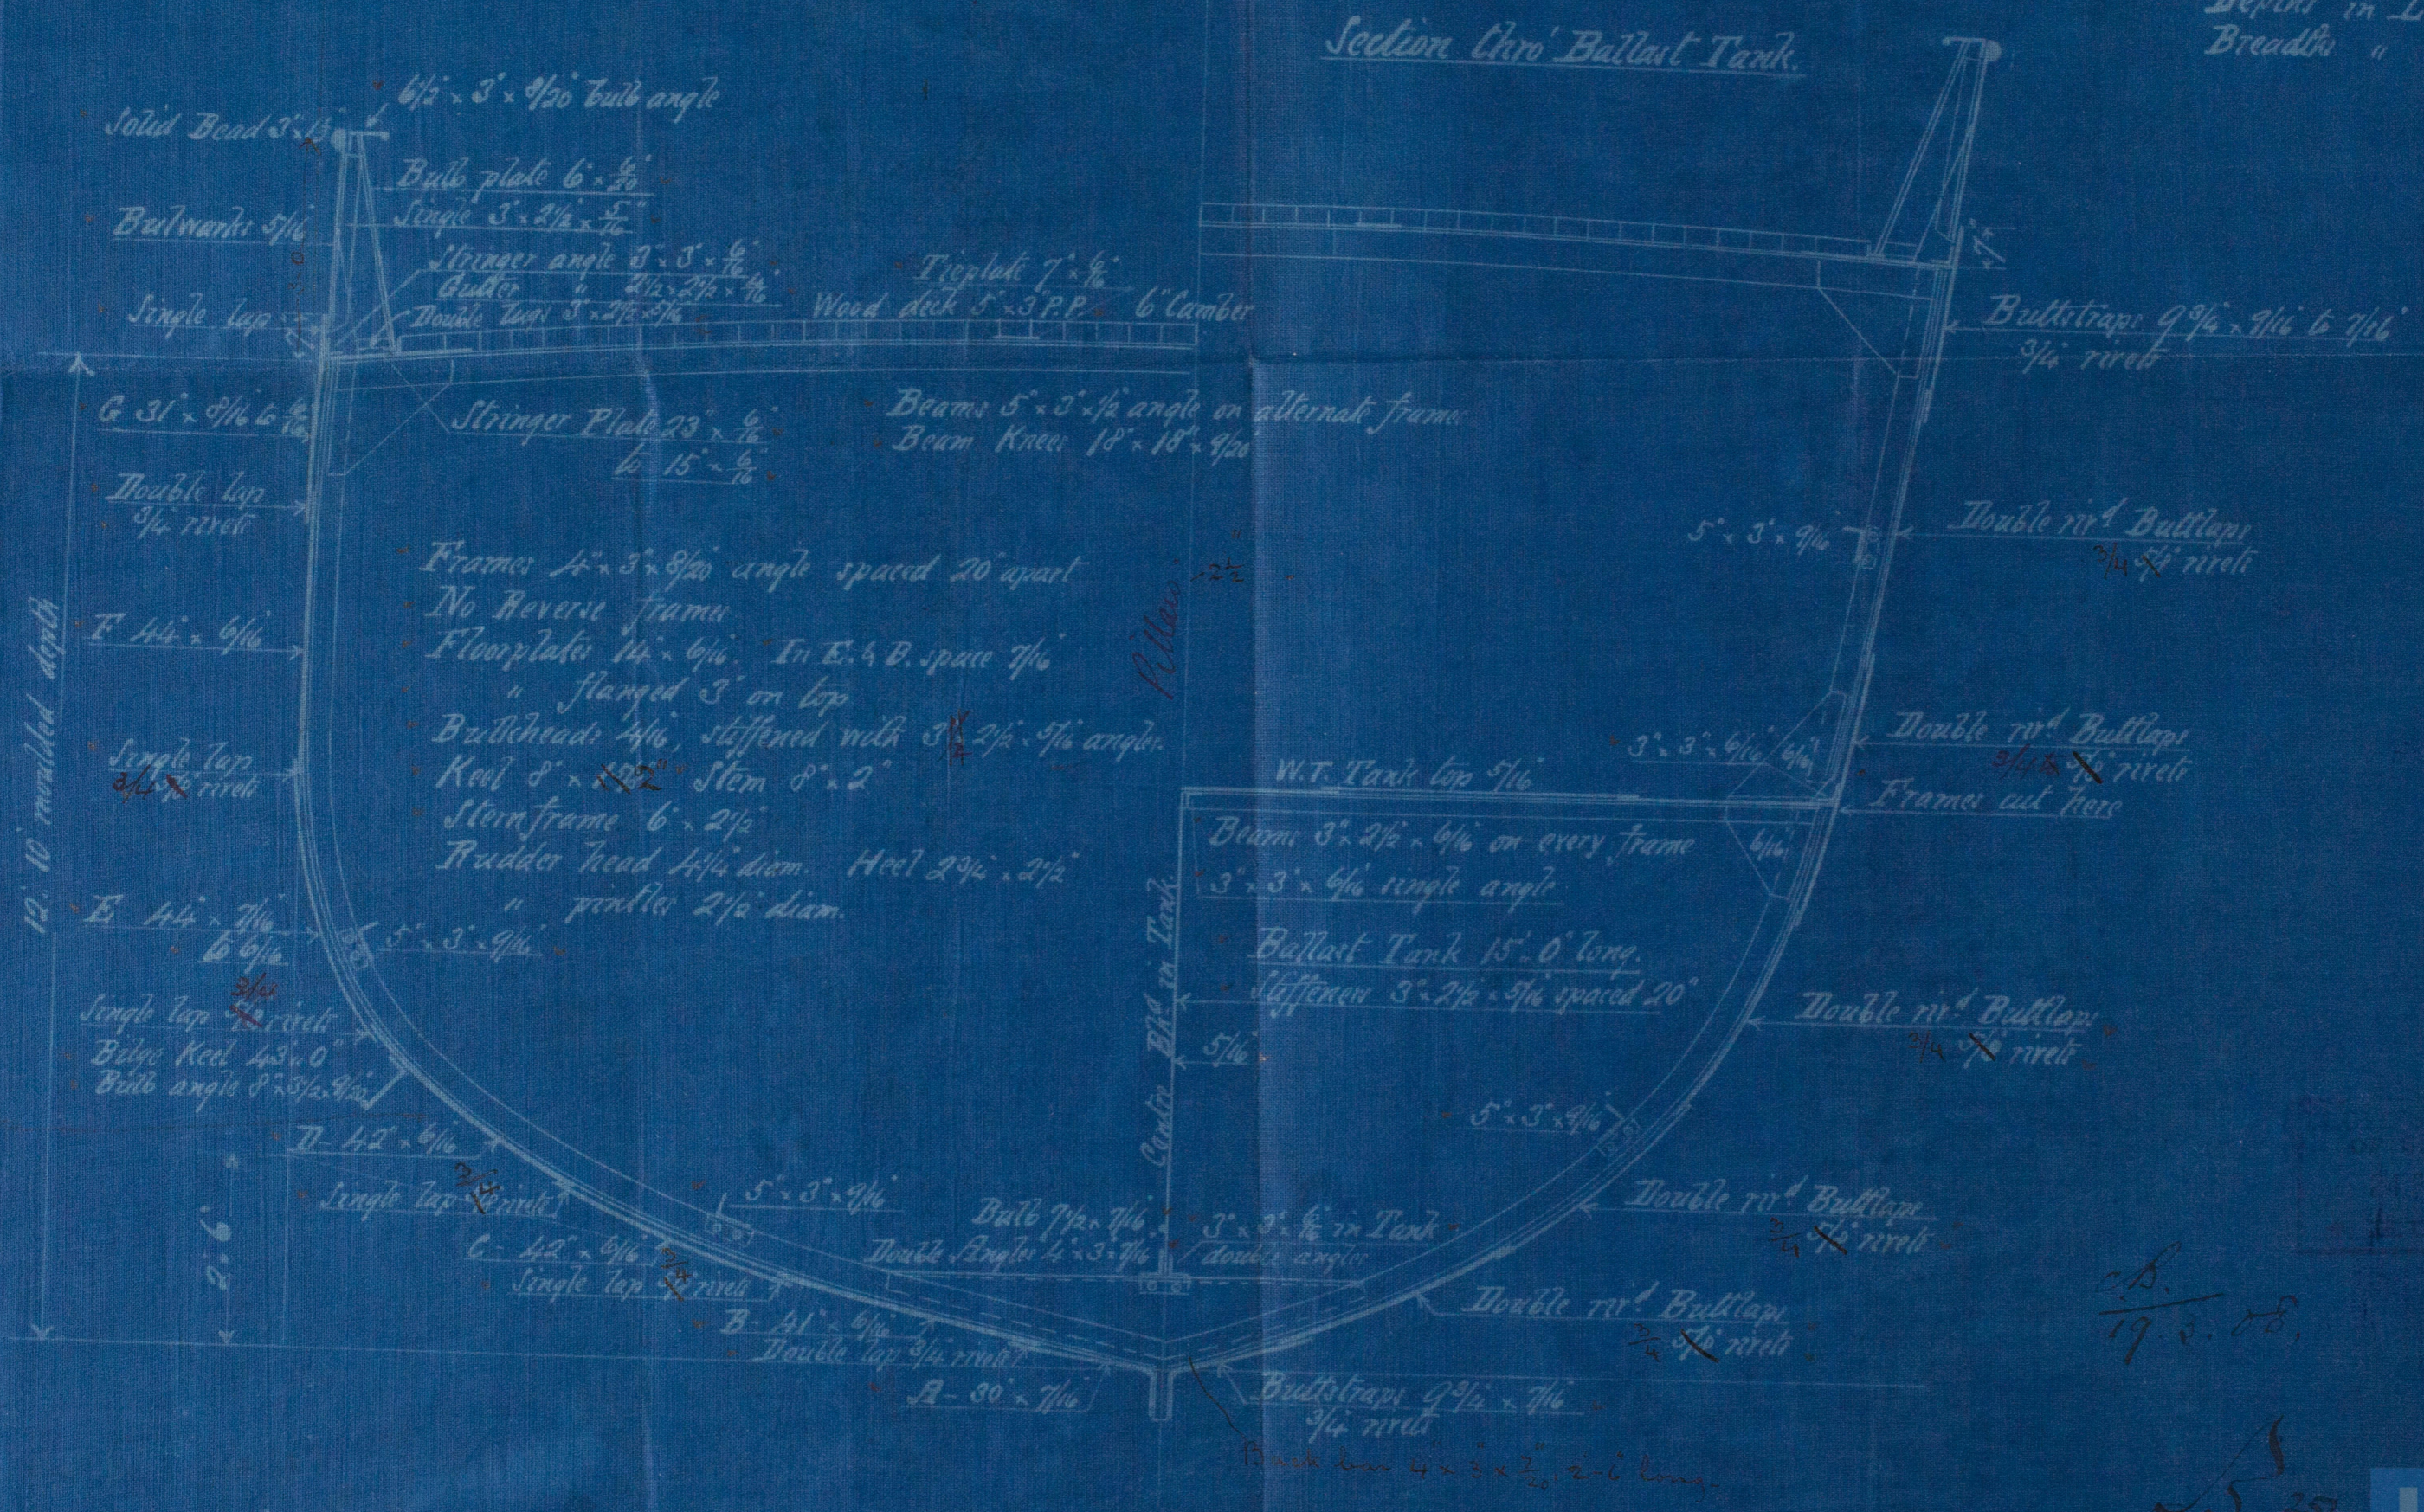

c.B.
17-3-08

27/100



Charles S. & E. Co.

No. 545, 546 and 547
548

Midship Section.

w938-0082
s/s Celia
Hull Report No. 20.331
s/s Antonio
Hull Rpt. No. 20.422

s/s Hermoine 20.531
Hull Rpt.

s/s Shakespeare

Hull Report No. 20.567



Lloyd's Register
Foundation