

# N<sup>o</sup> 533. MIDSHIP SECTION

DIMENSIONS 128-4 B.P. x 22-1 M<sup>LD</sup> x 12-10 M<sup>LD</sup>

STEEL CLASS 100 A.1. FOR FISHING PURPOSES.

SCALE 1/2" = ONE FOOT.

23. 1. 07  
6. 2. 07  
18. 2. 07

1/2 BREADTH = 11.04  
DEPTH = 13.33  
1/2 GIRTH = 21.08  
45.45 1<sup>ST</sup> N<sup>o</sup>  
127.125 L<sup>TH</sup> AS PER RULE.  
227.25  
9090  
4545  
31815  
9090  
4545  
5777.83125. 2<sup>ND</sup> N<sup>o</sup>.


$\frac{L}{B} = 5.7$   
 $\frac{L}{D} = 9.5$

## EQUIPMENT.

- ONE ANCHOR 5 3/4 CWTs. EX. STOCK.
- " 5 1/4 "
- " 3 "
- 105 FTH<sup>s</sup> 1/16 CHAIN.
- 60 " 6 HAWSER.
- 60 " 5 WARP.

PILLARS 2 1/2 DIA. *as per Rule*

3/4 RIVETS THROUGHOUT FOR SHELL.

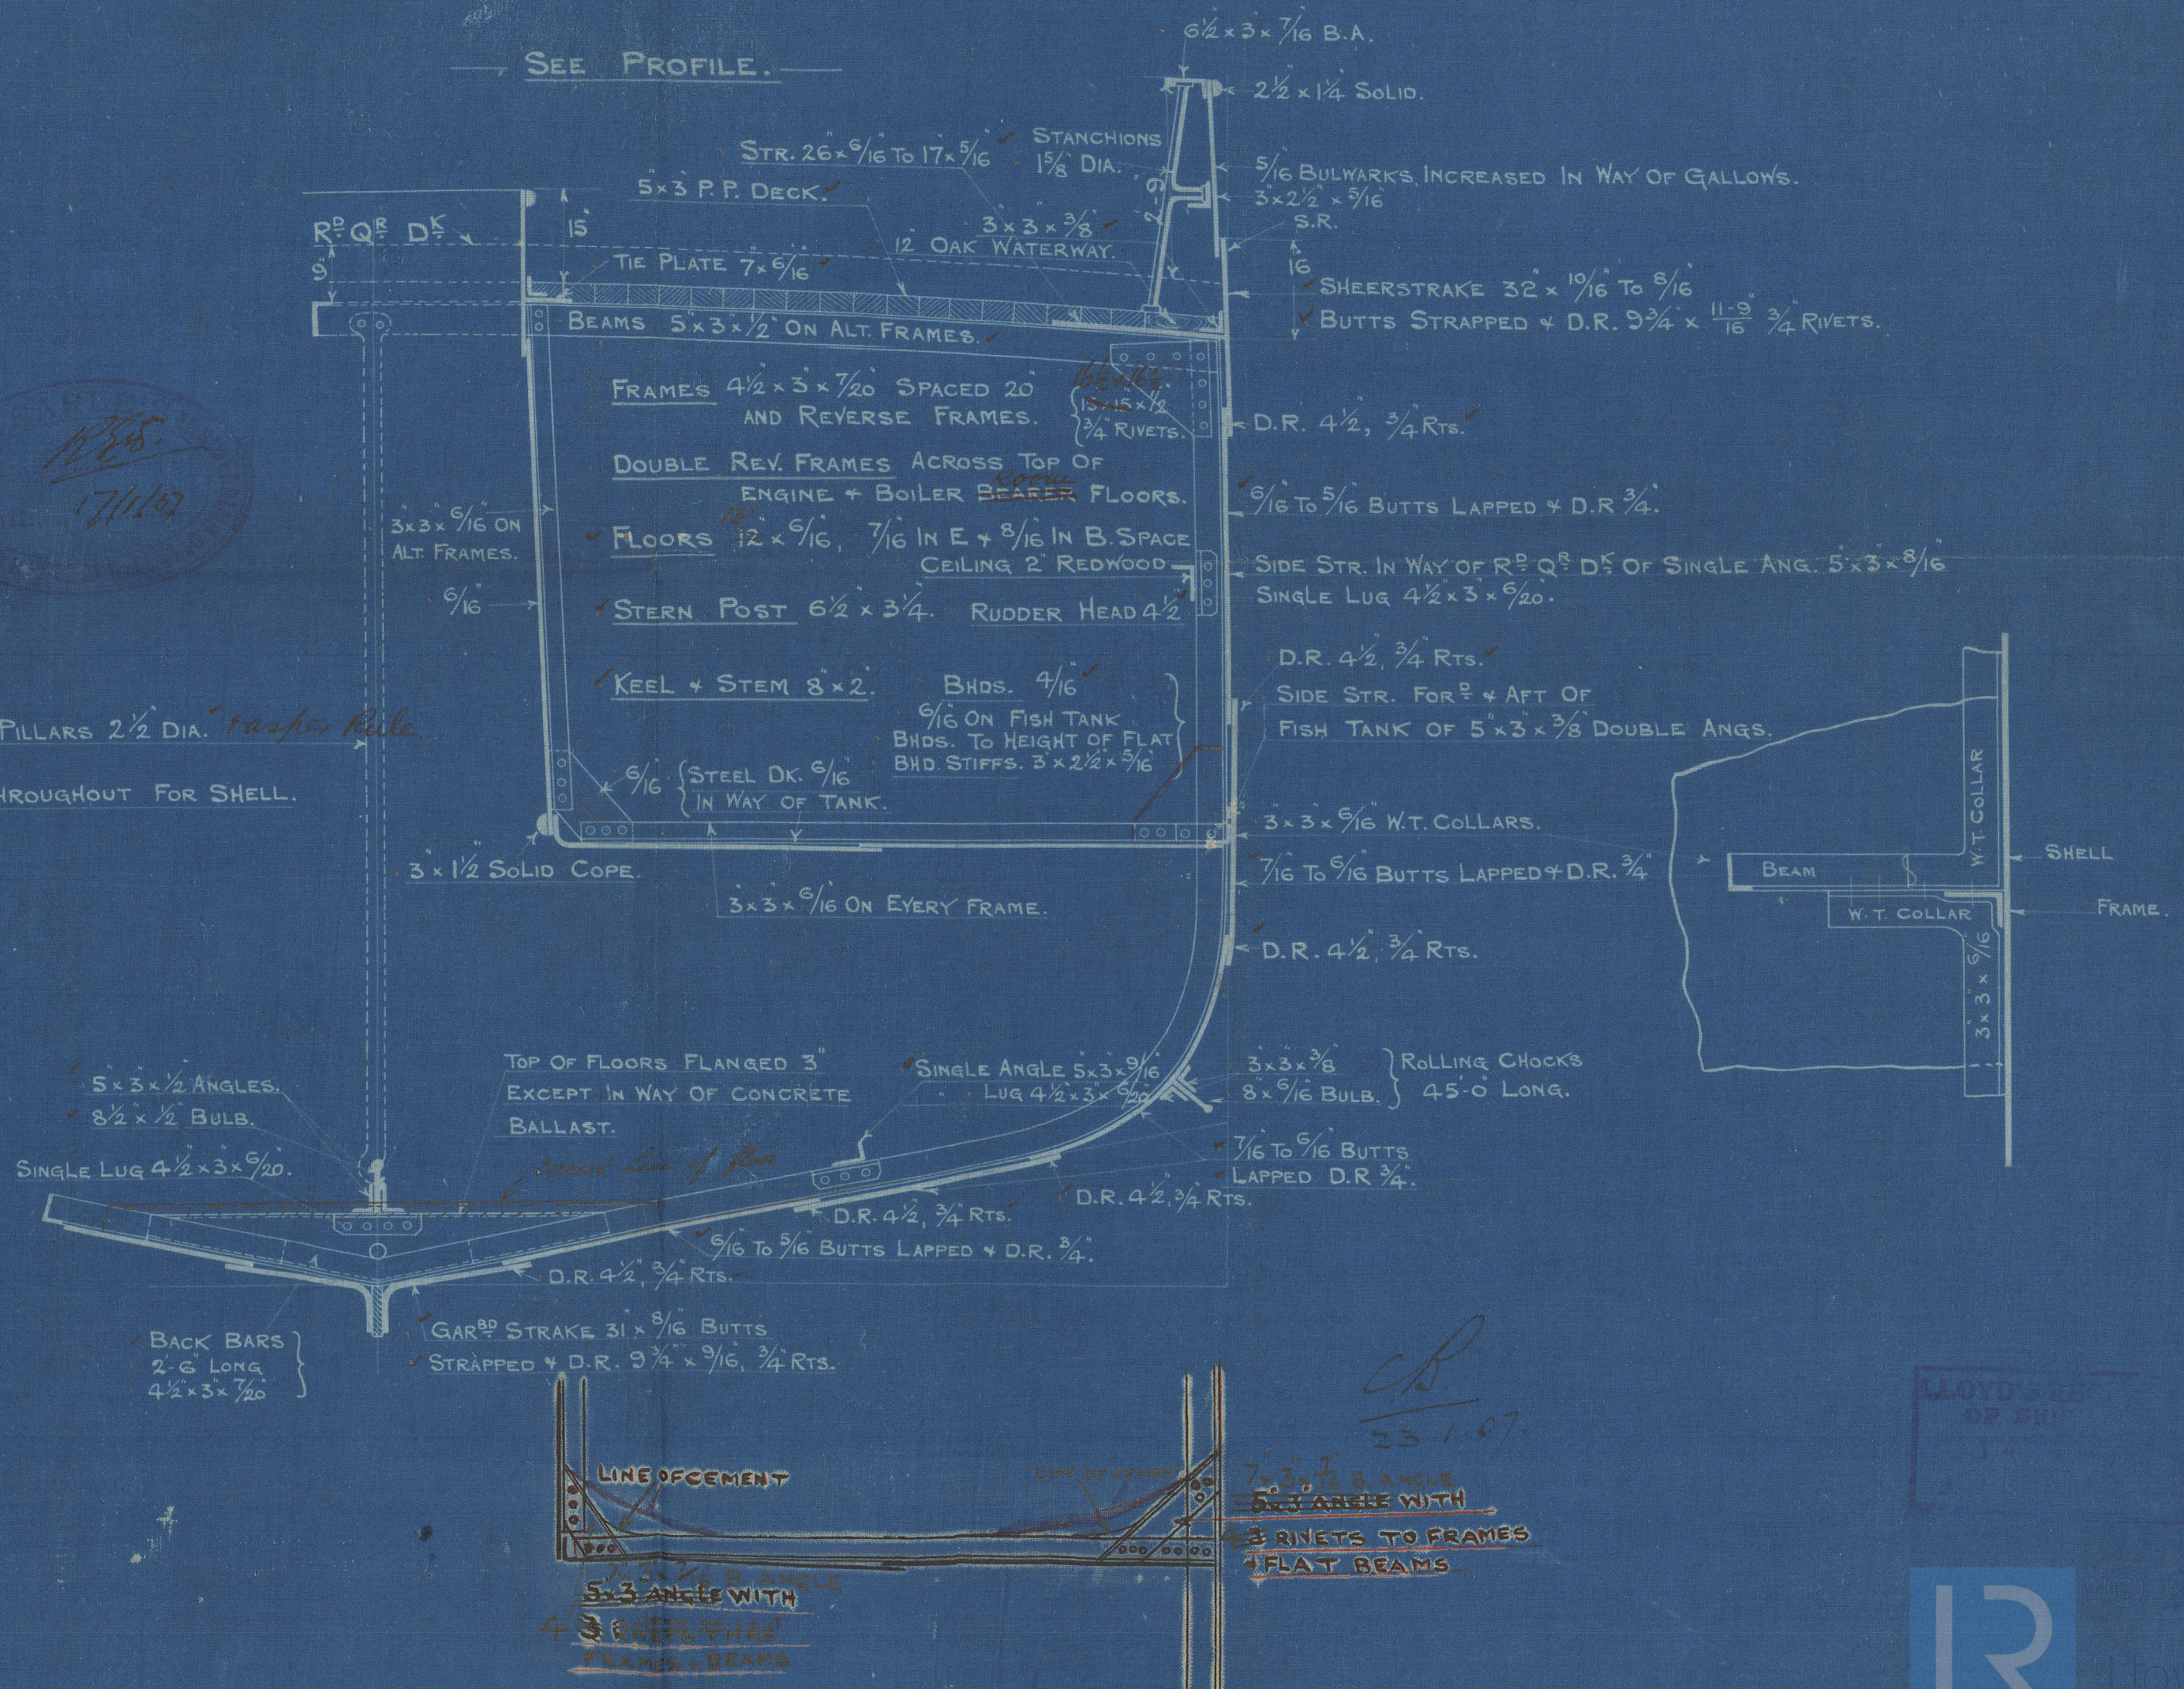



Charles S.B. & Co.

No 533.

Midship Section



W438-411



s/s Celtic  
Hull Report No. 19166



© 2020

Lloyd's Register  
Foundation