

23.1.07  
6.2.07  
18.2.07



N°533

# PROFILE & DECK PLAN

DIMENSIONS 28'4" B.P. x 22'1" MLD x 12'10" MLD

TO CLASS 100A STEEL FOR FISHING PURPOSES

SCALE  $\frac{1}{4}$ " = 1' = 12"

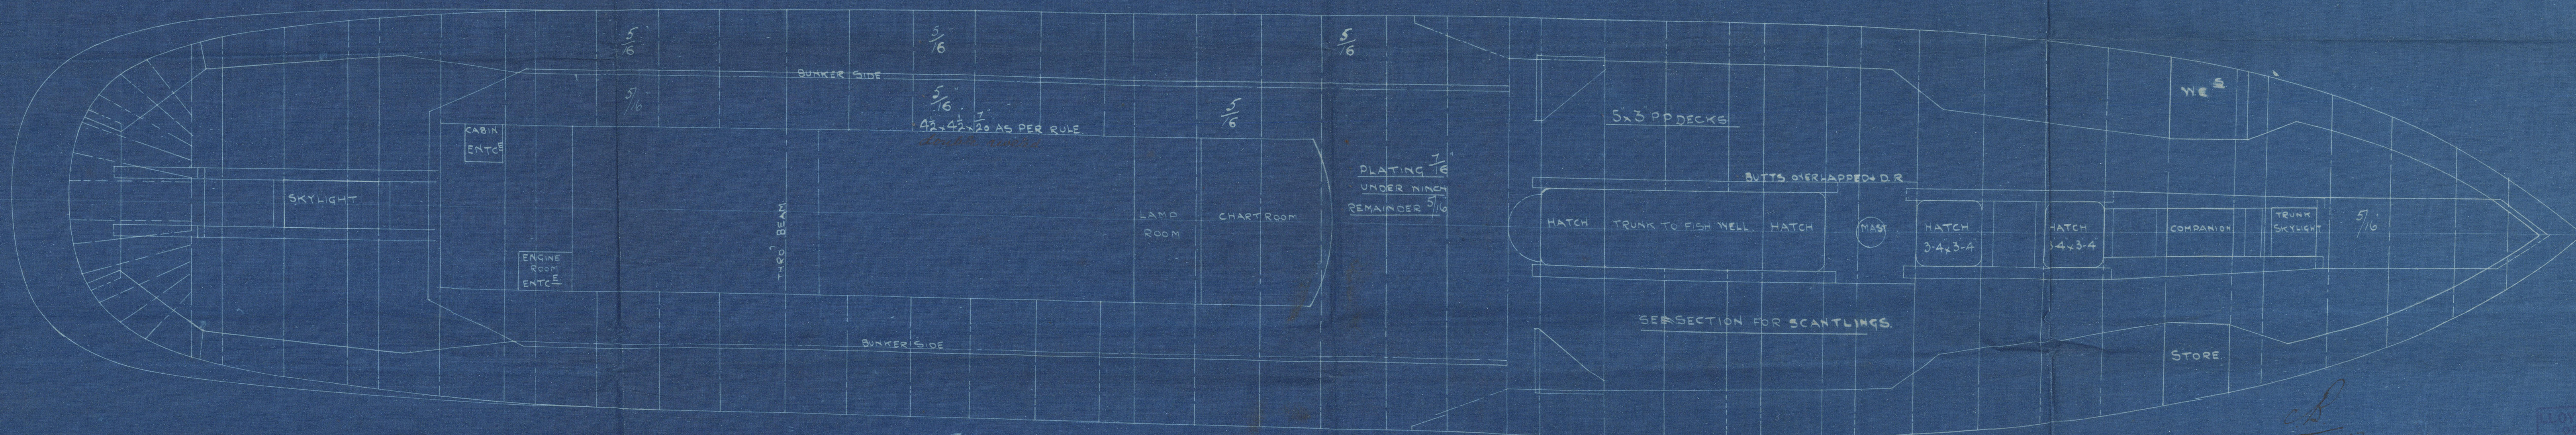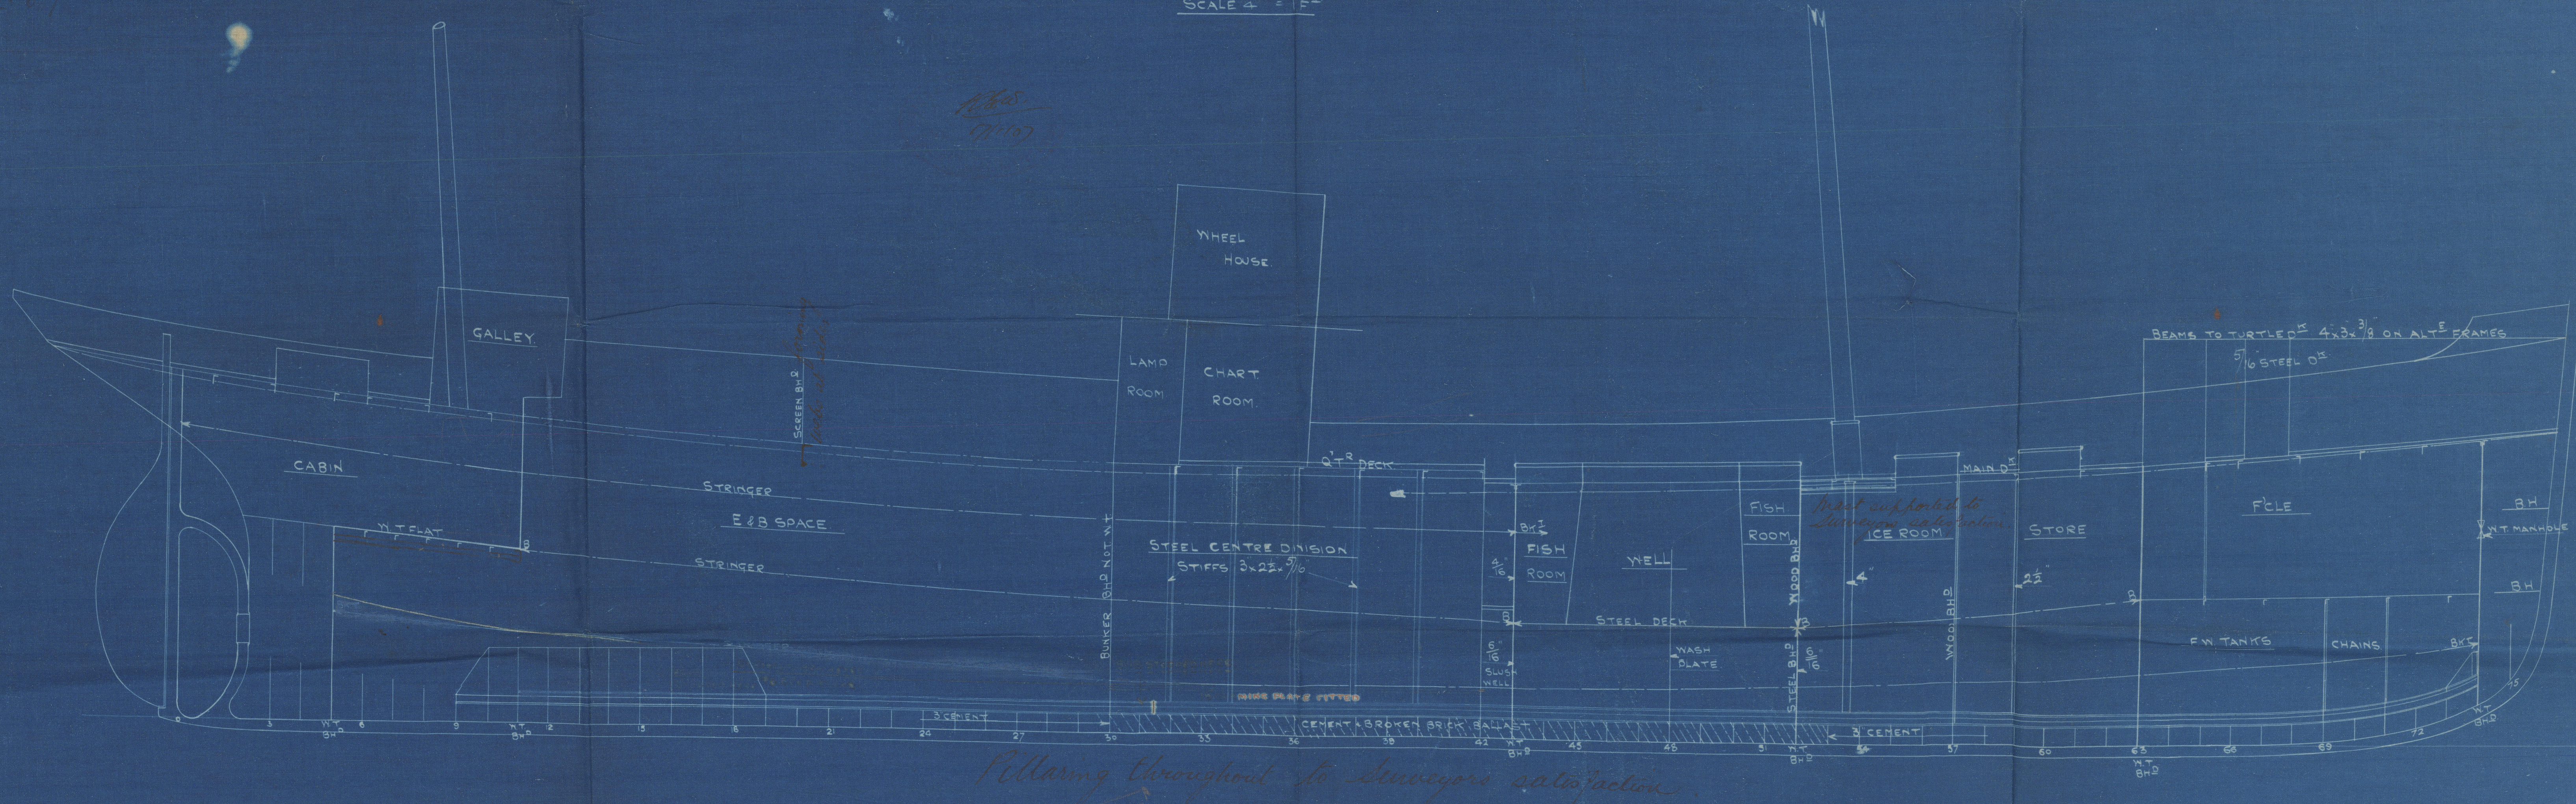

LLOYD'S REGISTER  
OF SHIPPING



Lloyd's Register  
Foundation



Earle's S.B. & E.C.

Nº 533.

Profile + Deck Plan.

W938-0112



S/s Celtic  
Hull Report No-19166

RETAIN



© 2020

Lloyd's Register  
Foundation