



Class Engl Lloyd 100 A  
Scale 1 u 48

Length	10	Lloyd's	108	"	8 "
Breadth		moulded	23	"	
Depth			11	"	8 "
Depth		moulded	11	"	2 "
$\frac{1}{2}$ B	=		11,50		
Depth	=		11,67		
$\frac{1}{2}$ Girc	=		20,67		
N <sup>o</sup> 1	Fannes	=	43,84		
43,84 x 108,50	=		4757	N <sup>o</sup> 1	Plating

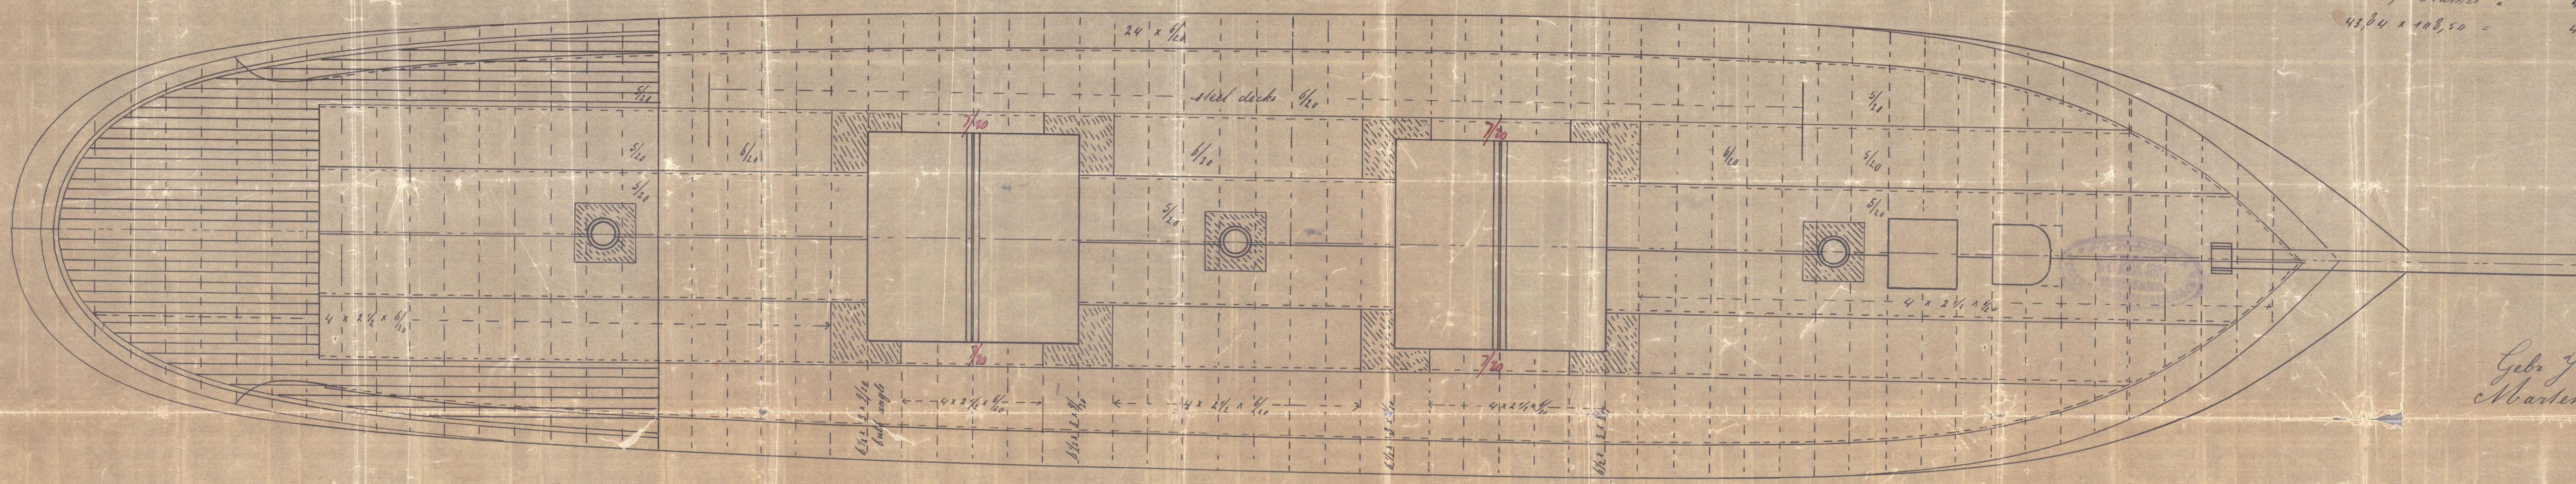


Gedr. v. G. Versteek  
Martenshoek

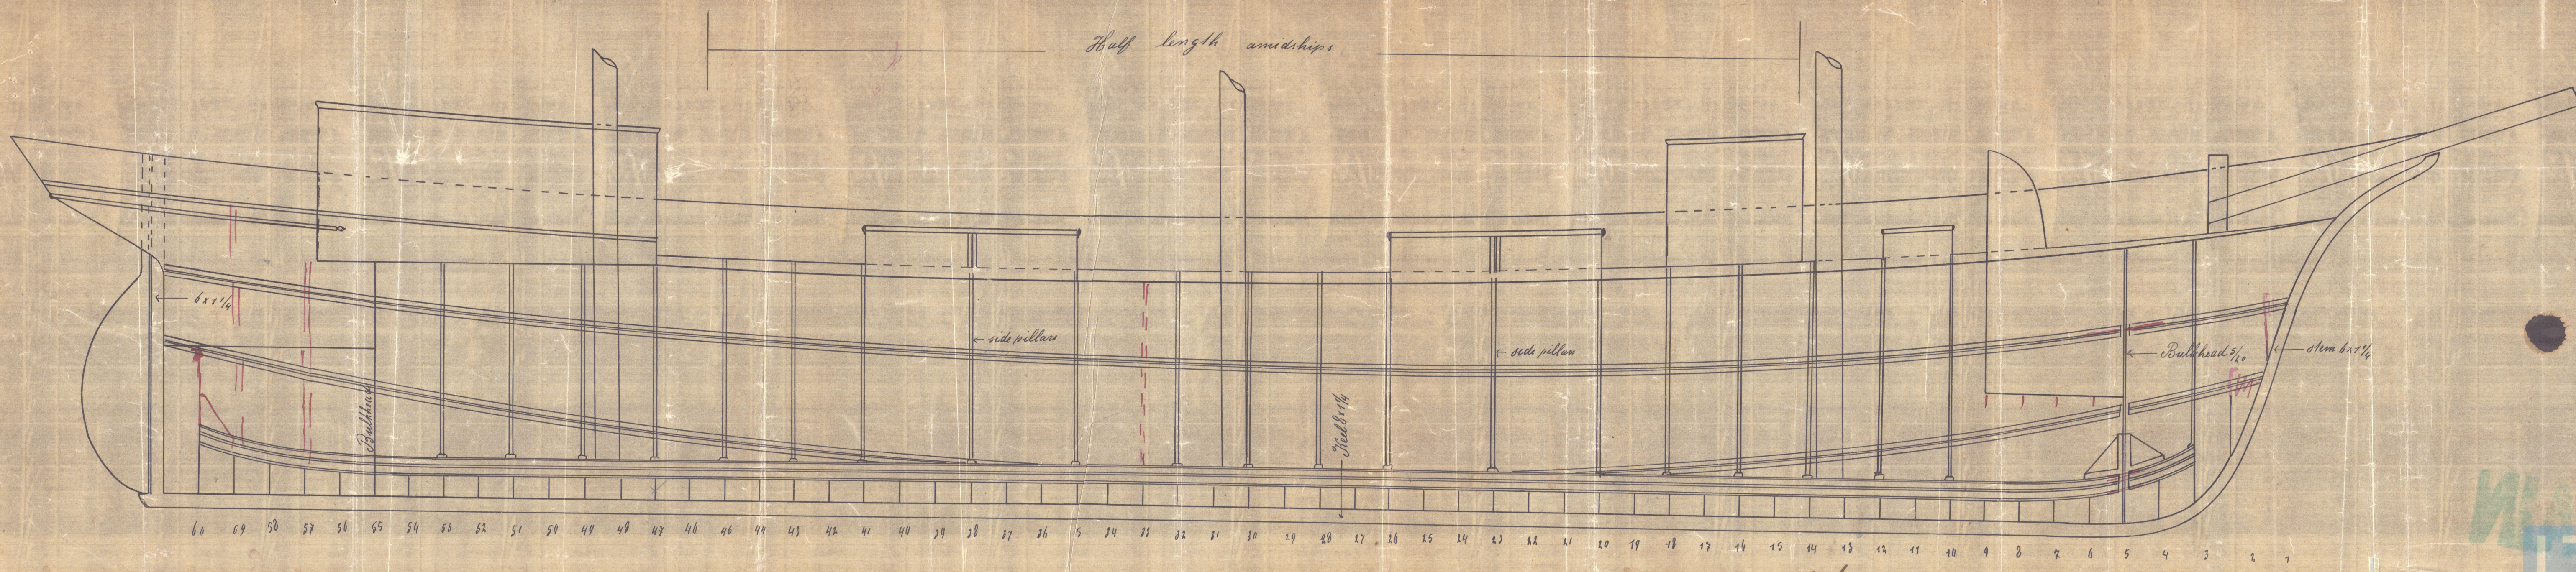

J.V. 7/3/05



Alida Katharina  
Ams 3/96

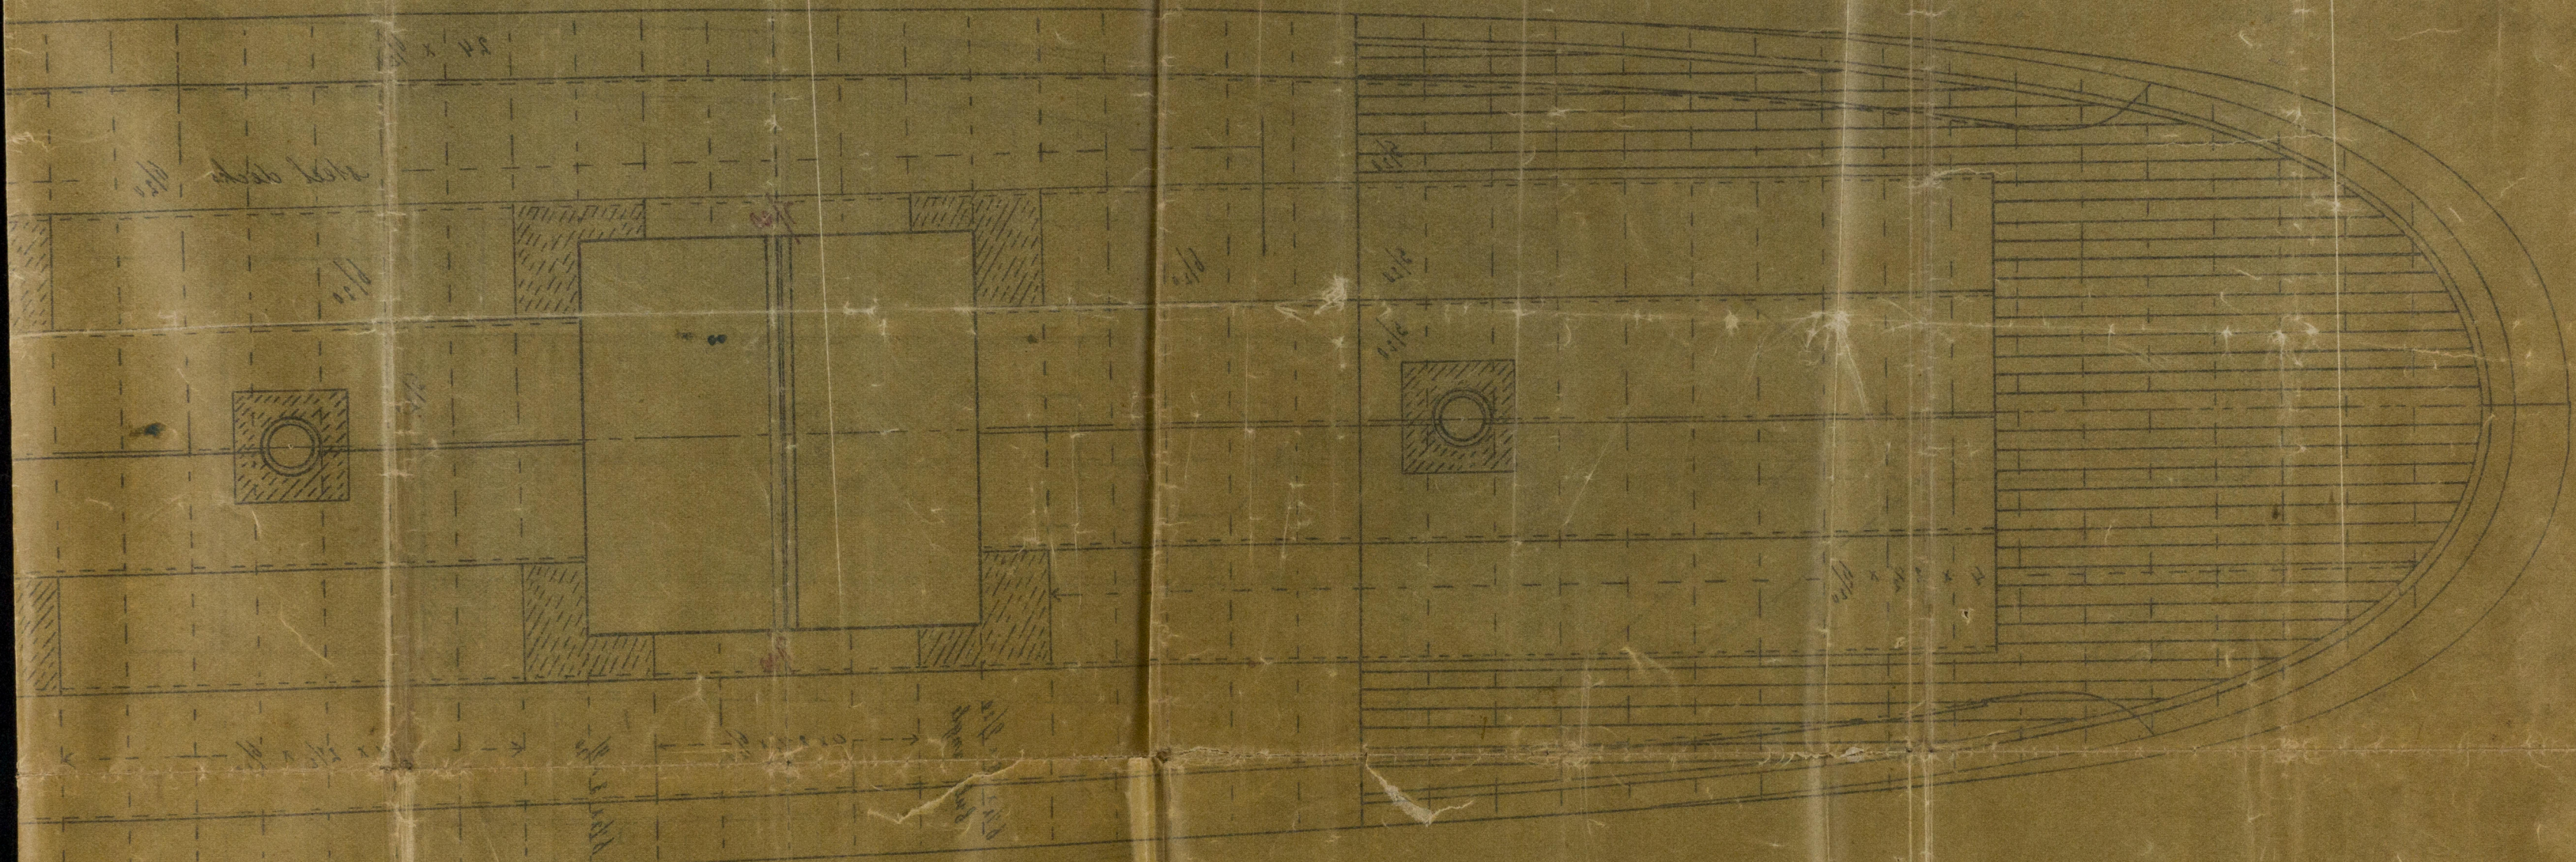



© 2020

Lloyd's Register  
Foundation




7109/1302

RETAIN

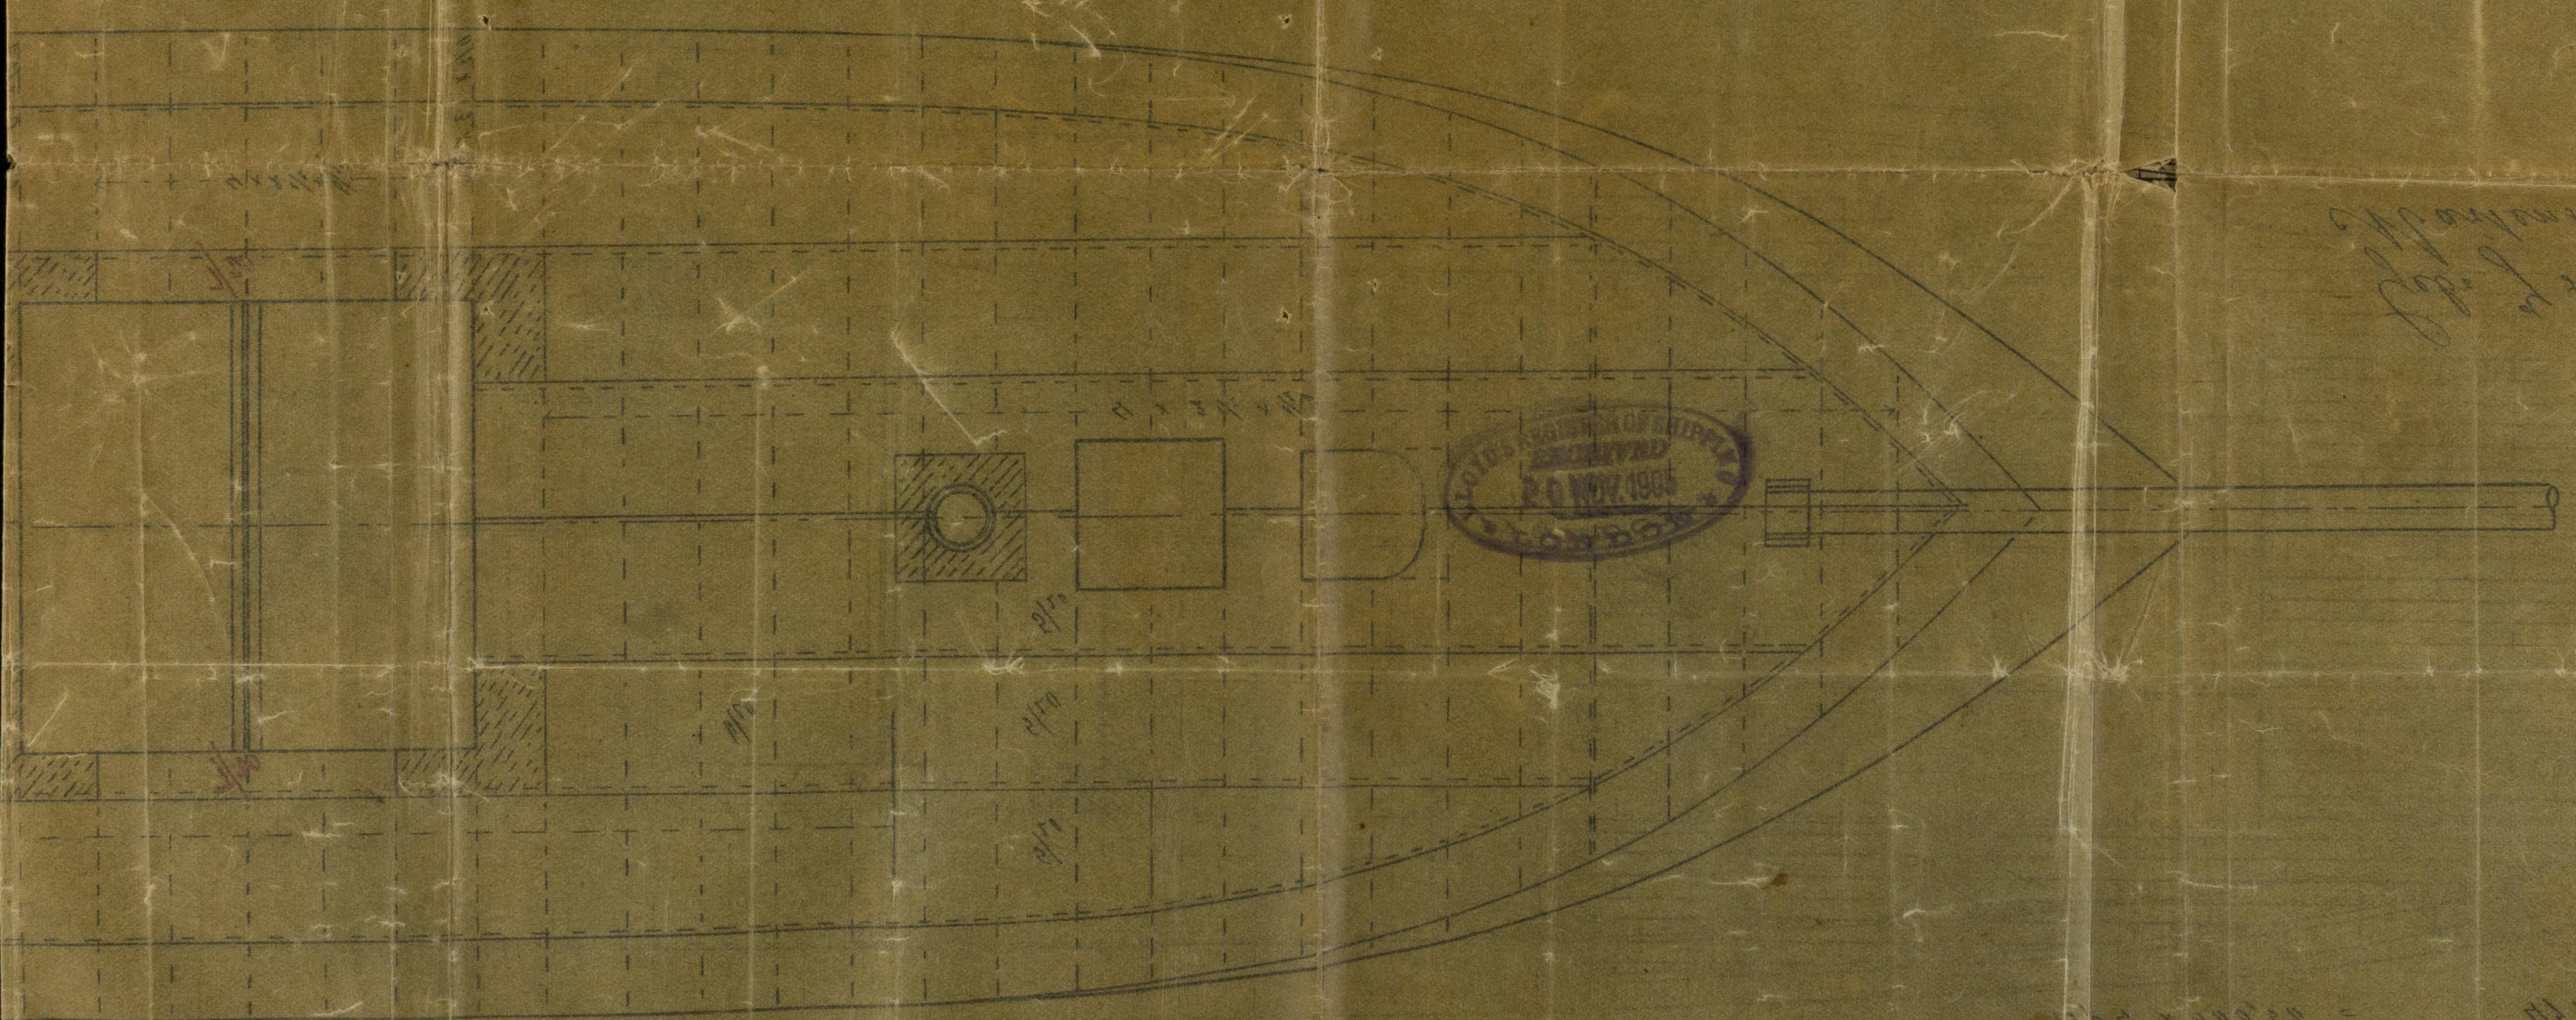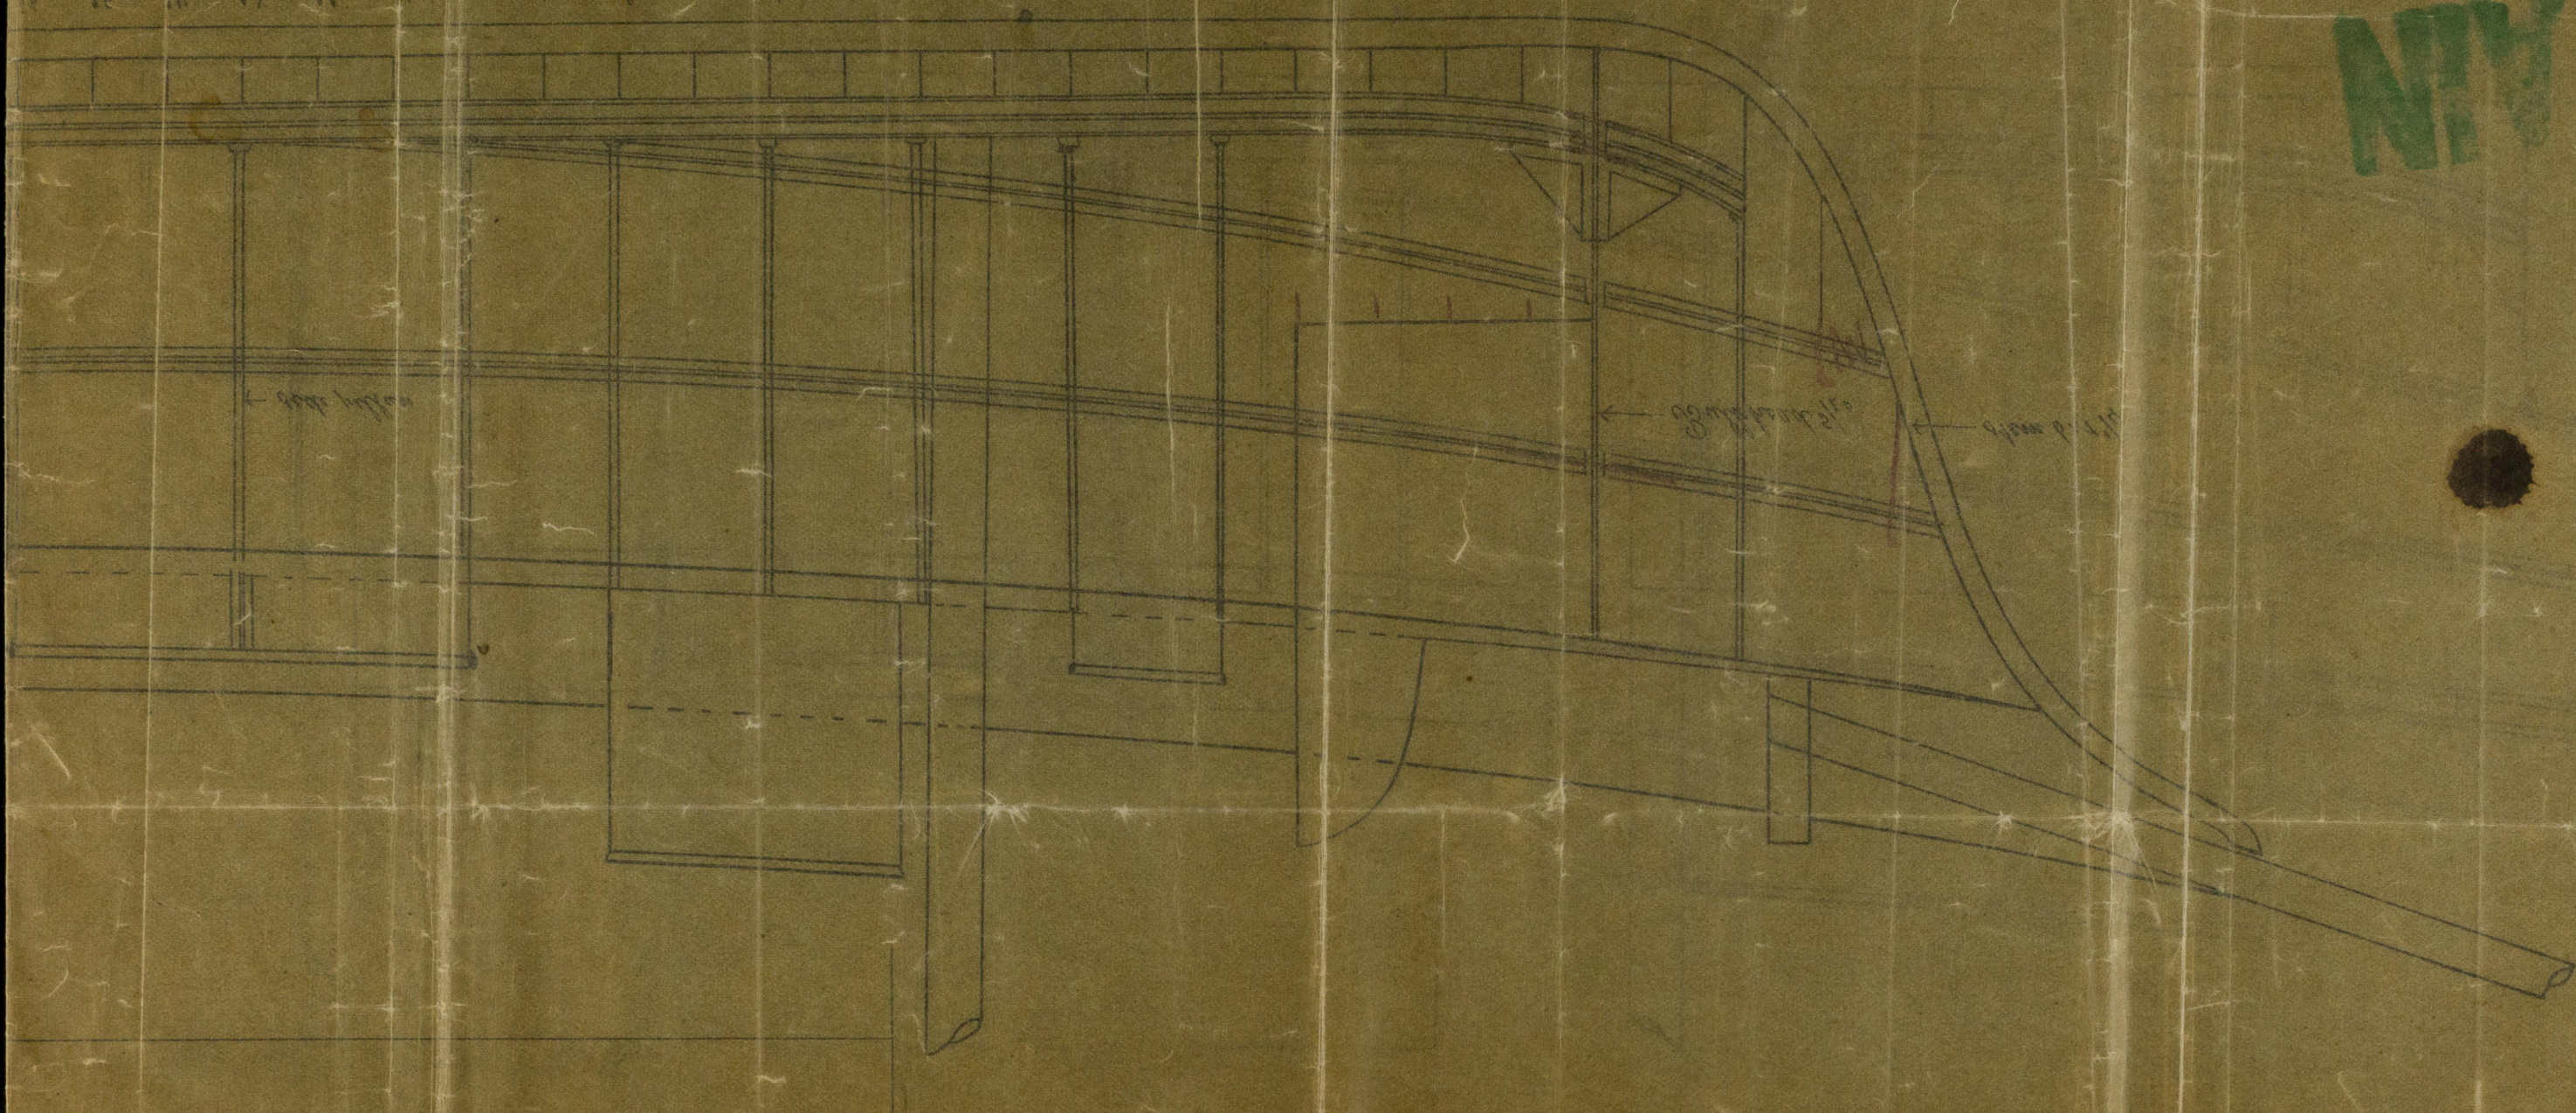


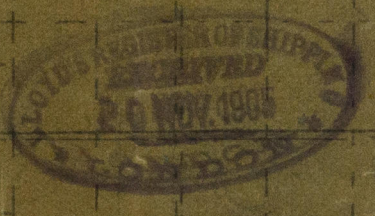



W939-0074