
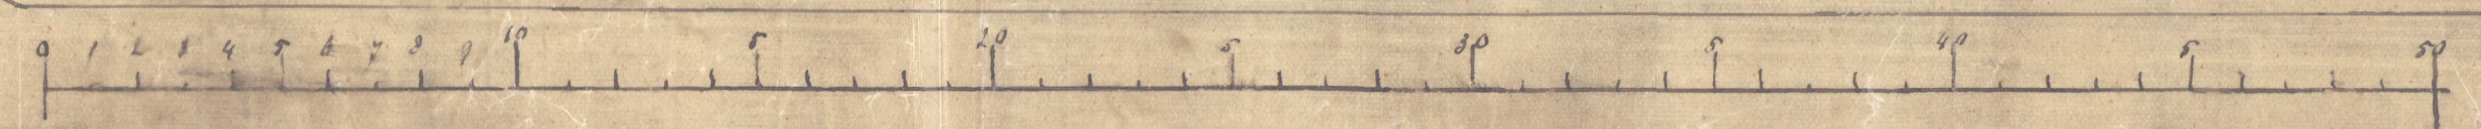


22.3.05 *Leitship "Alida Katharina"*
 Kapit. J. Lunt.
 schaal 1/48

foremast 14,5 m.
 main " 14,5 "
 mizzen " 12,5 "
 fore lower rigging 2 3/4 "
 main " " 2 1/2 "
 mizzen " " 2 1/2 "
 fore backstays 2 1/2 "
 main and mizzen " " 2 "


108,5 x 23 x 11,67
 43.50 4758
 Rhine 200 Tons

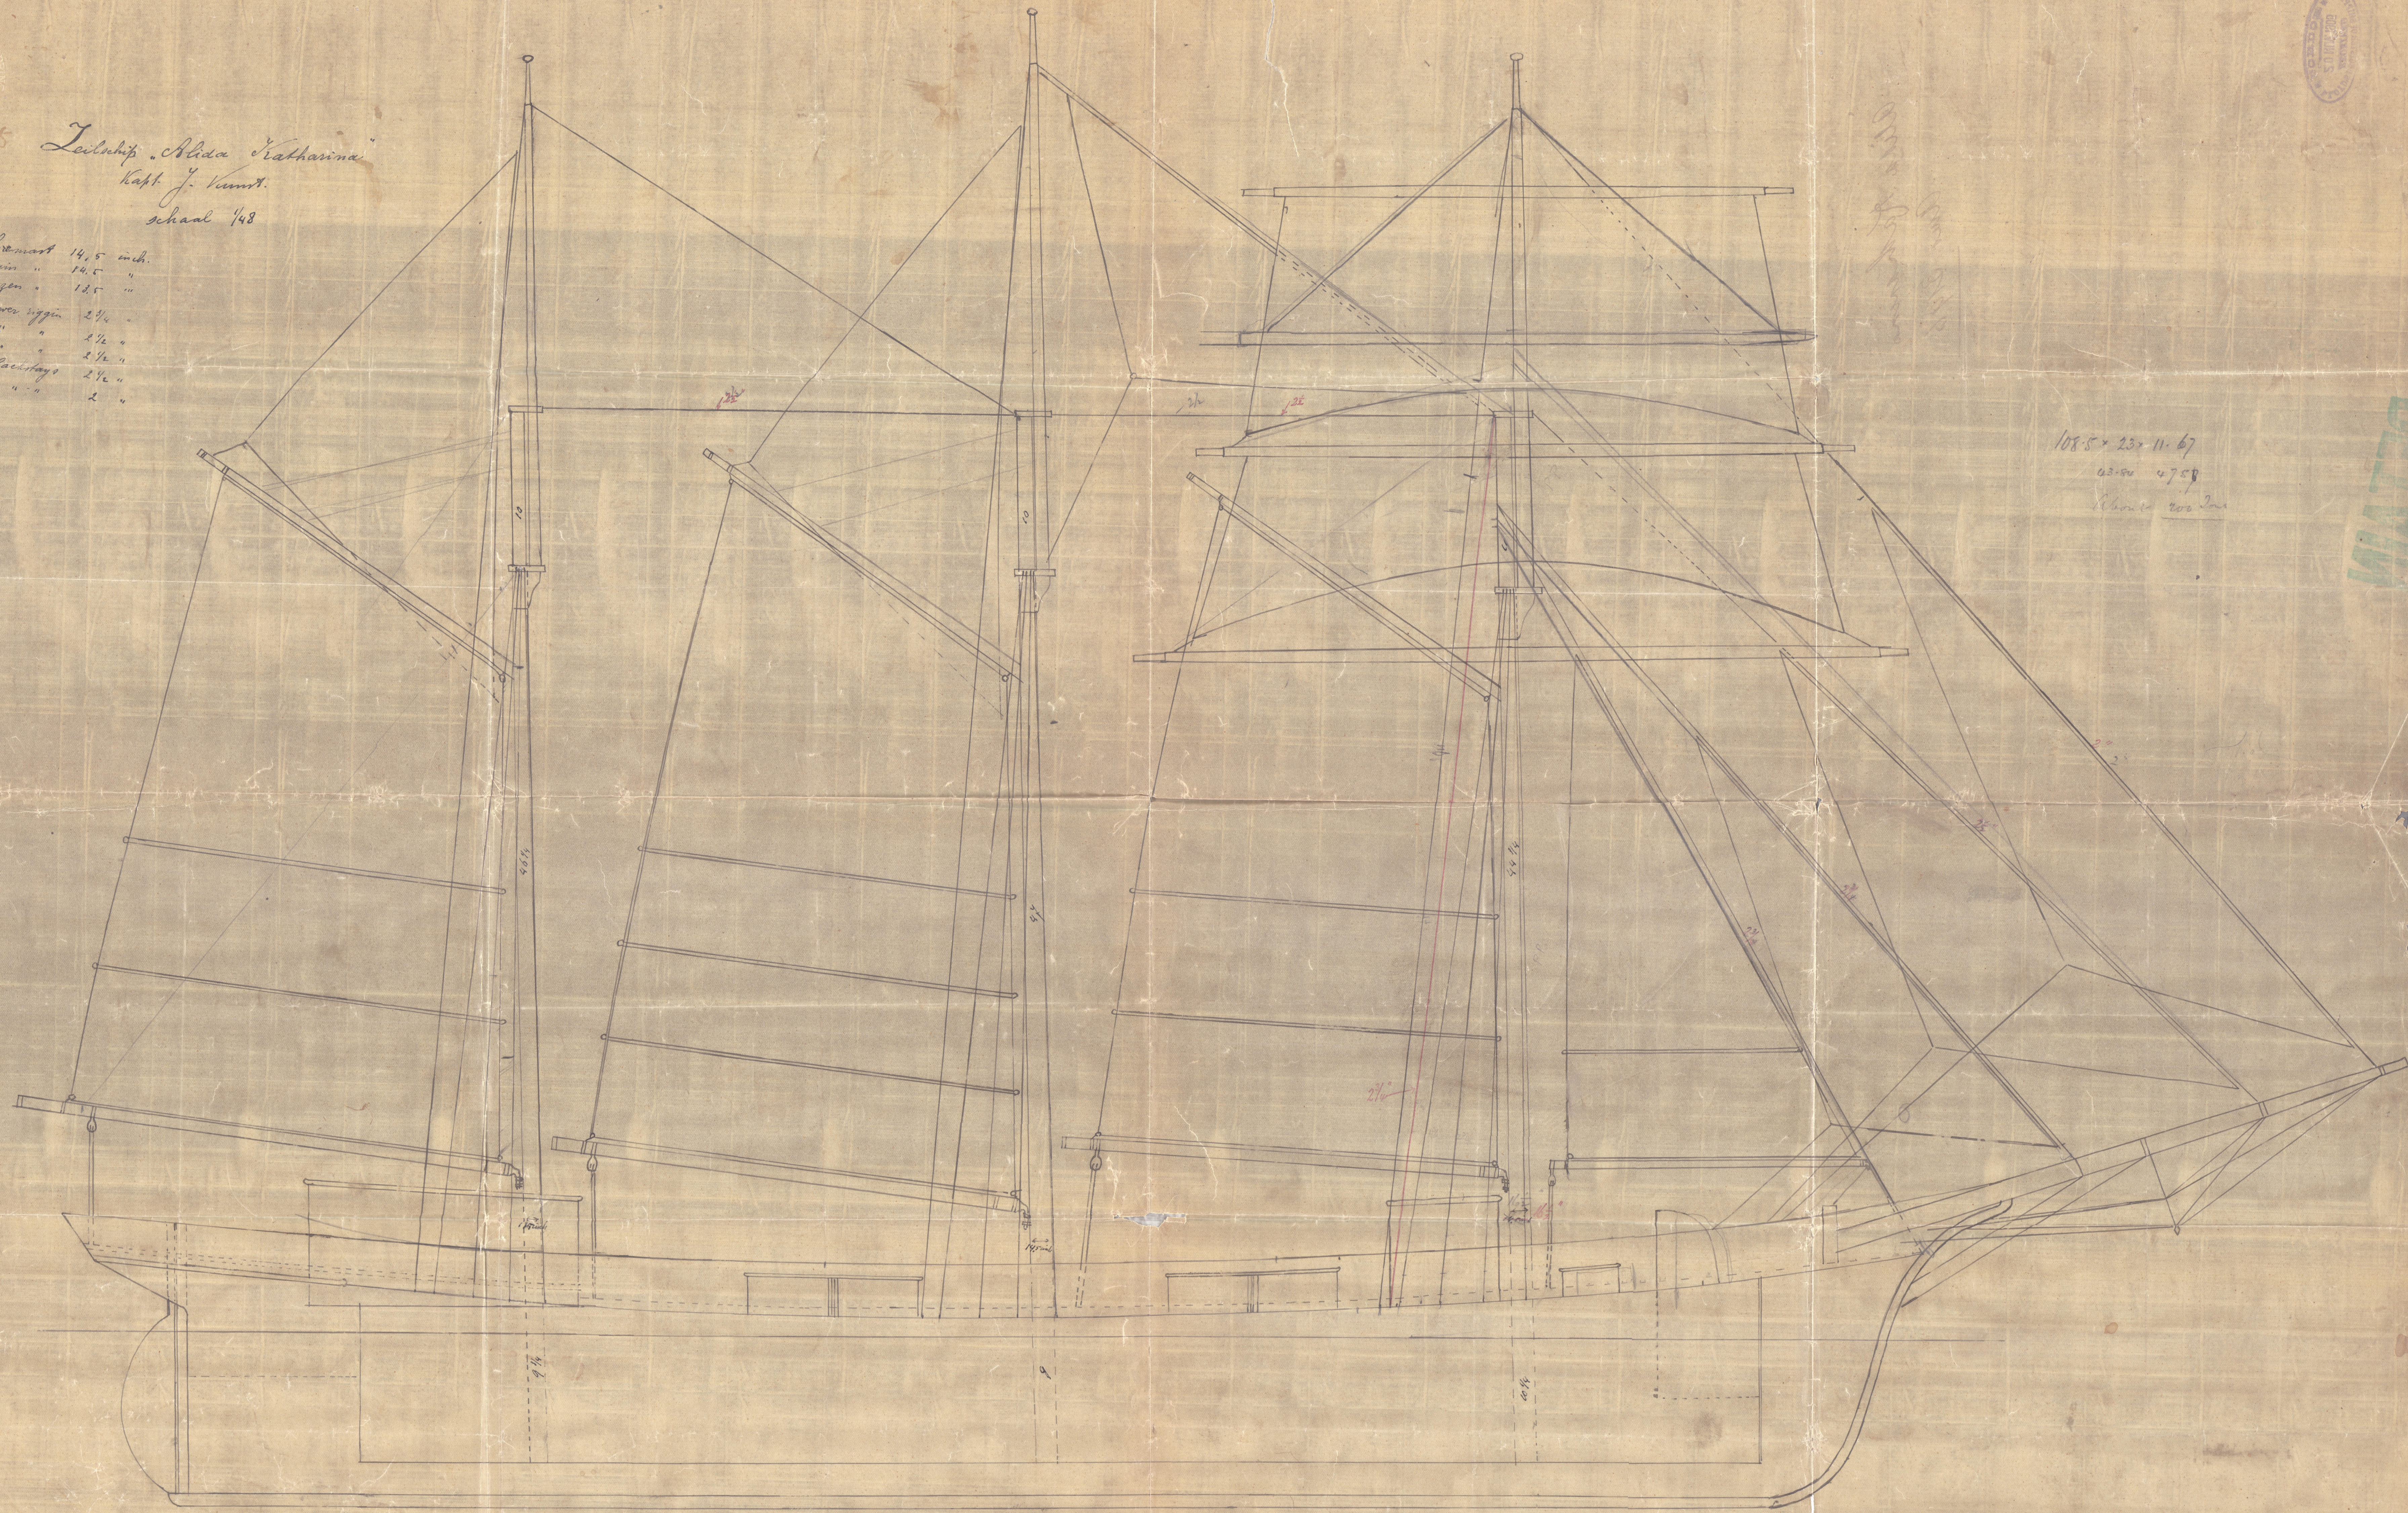

J. Lunt

22.3.05

Alisa Kahanina
Am 3/96

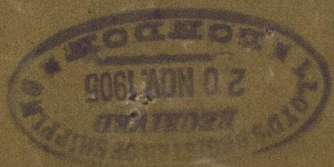

W439-0039

RETAIN



© 2020

Lloyd's Register
Foundation