




Length to Lloyd's 108 "
Breadth moulded 23 "
Depth 11 "
Depth moulded 11 "
 $\frac{1}{2}$ B = 11,50
D = 11,67
 $\frac{1}{2}$ Girc = 20,67
No of Frames = 43,84
 $43,84 \times 108,50 = 4757$ of Plating

Class Engl Lloyd's 100 A
Scale 1" = 3'

Gebr J & G Versteck
Martenshoek

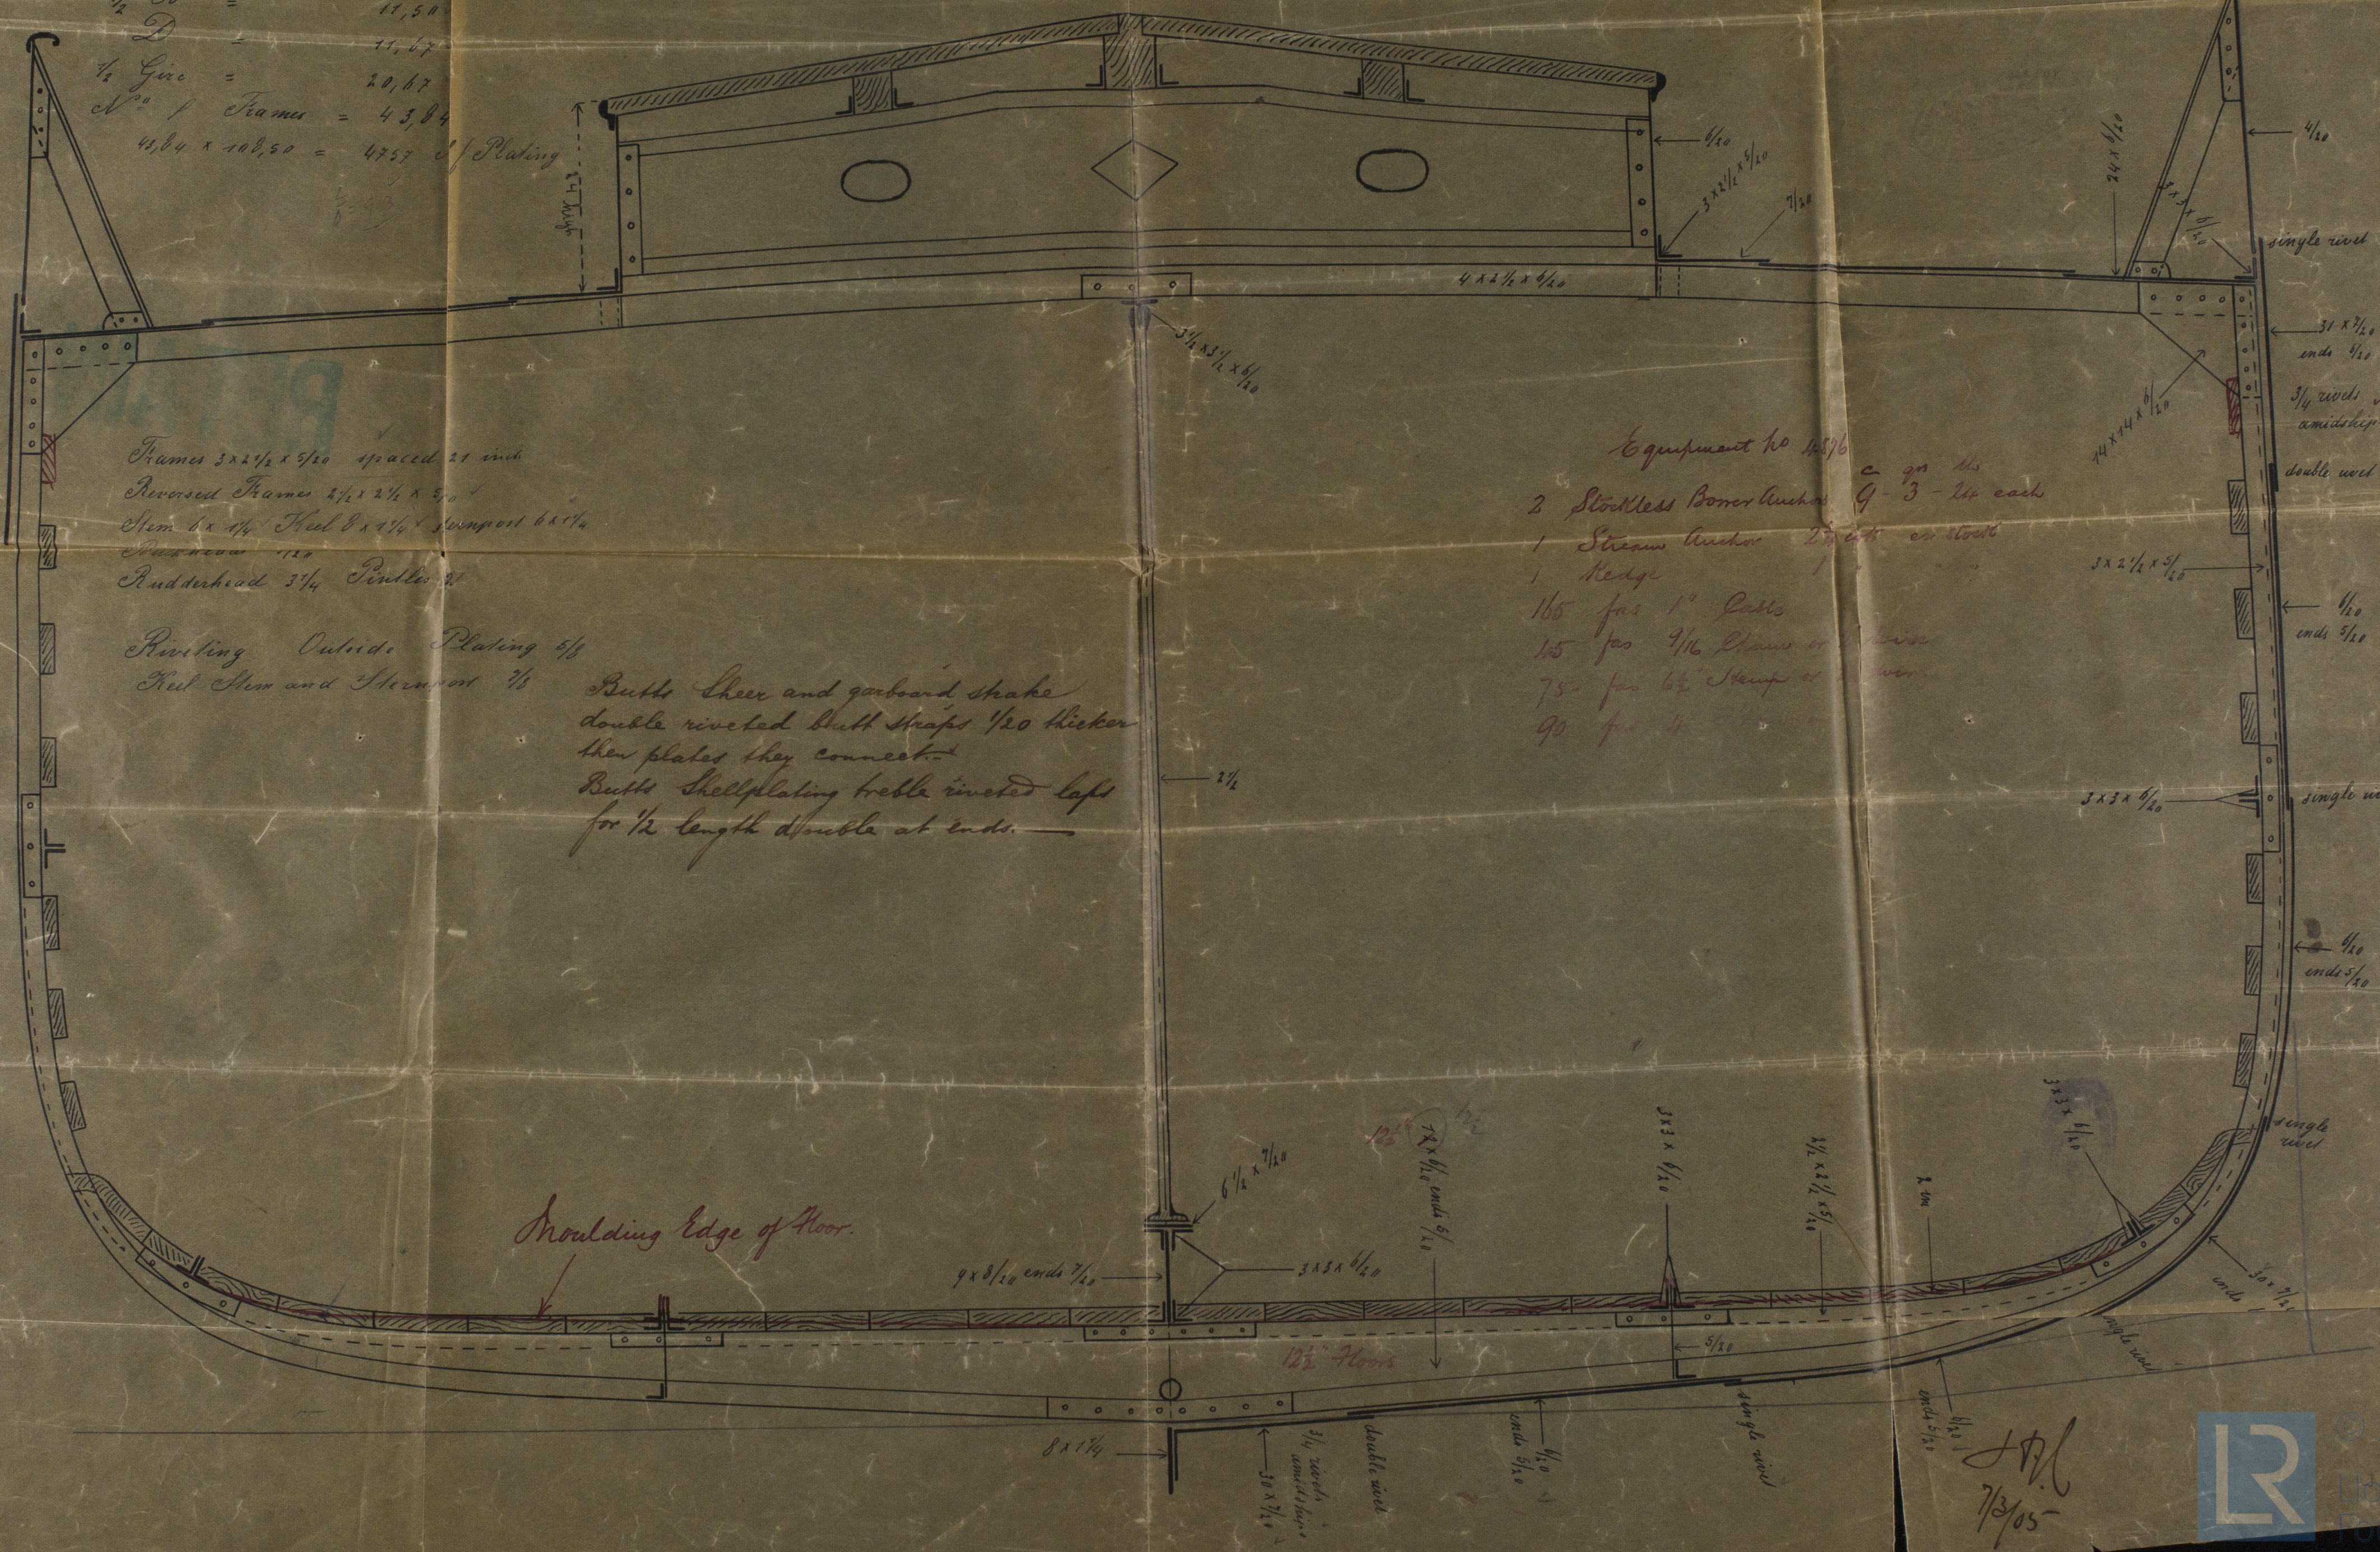


Equipment no 14576
2 Stockless Bower Anchors 9-3-14 each
1 Stream Anchor 2 1/2 tons in stock
1 Hedge
165 lbs for 1" cables
165 lbs for 7/16 chains or wires
75 lbs for 6 1/2" stump or wire
90 lbs for 4" chains

Alida Kaphana

939-6046

1/19/03
S. J.

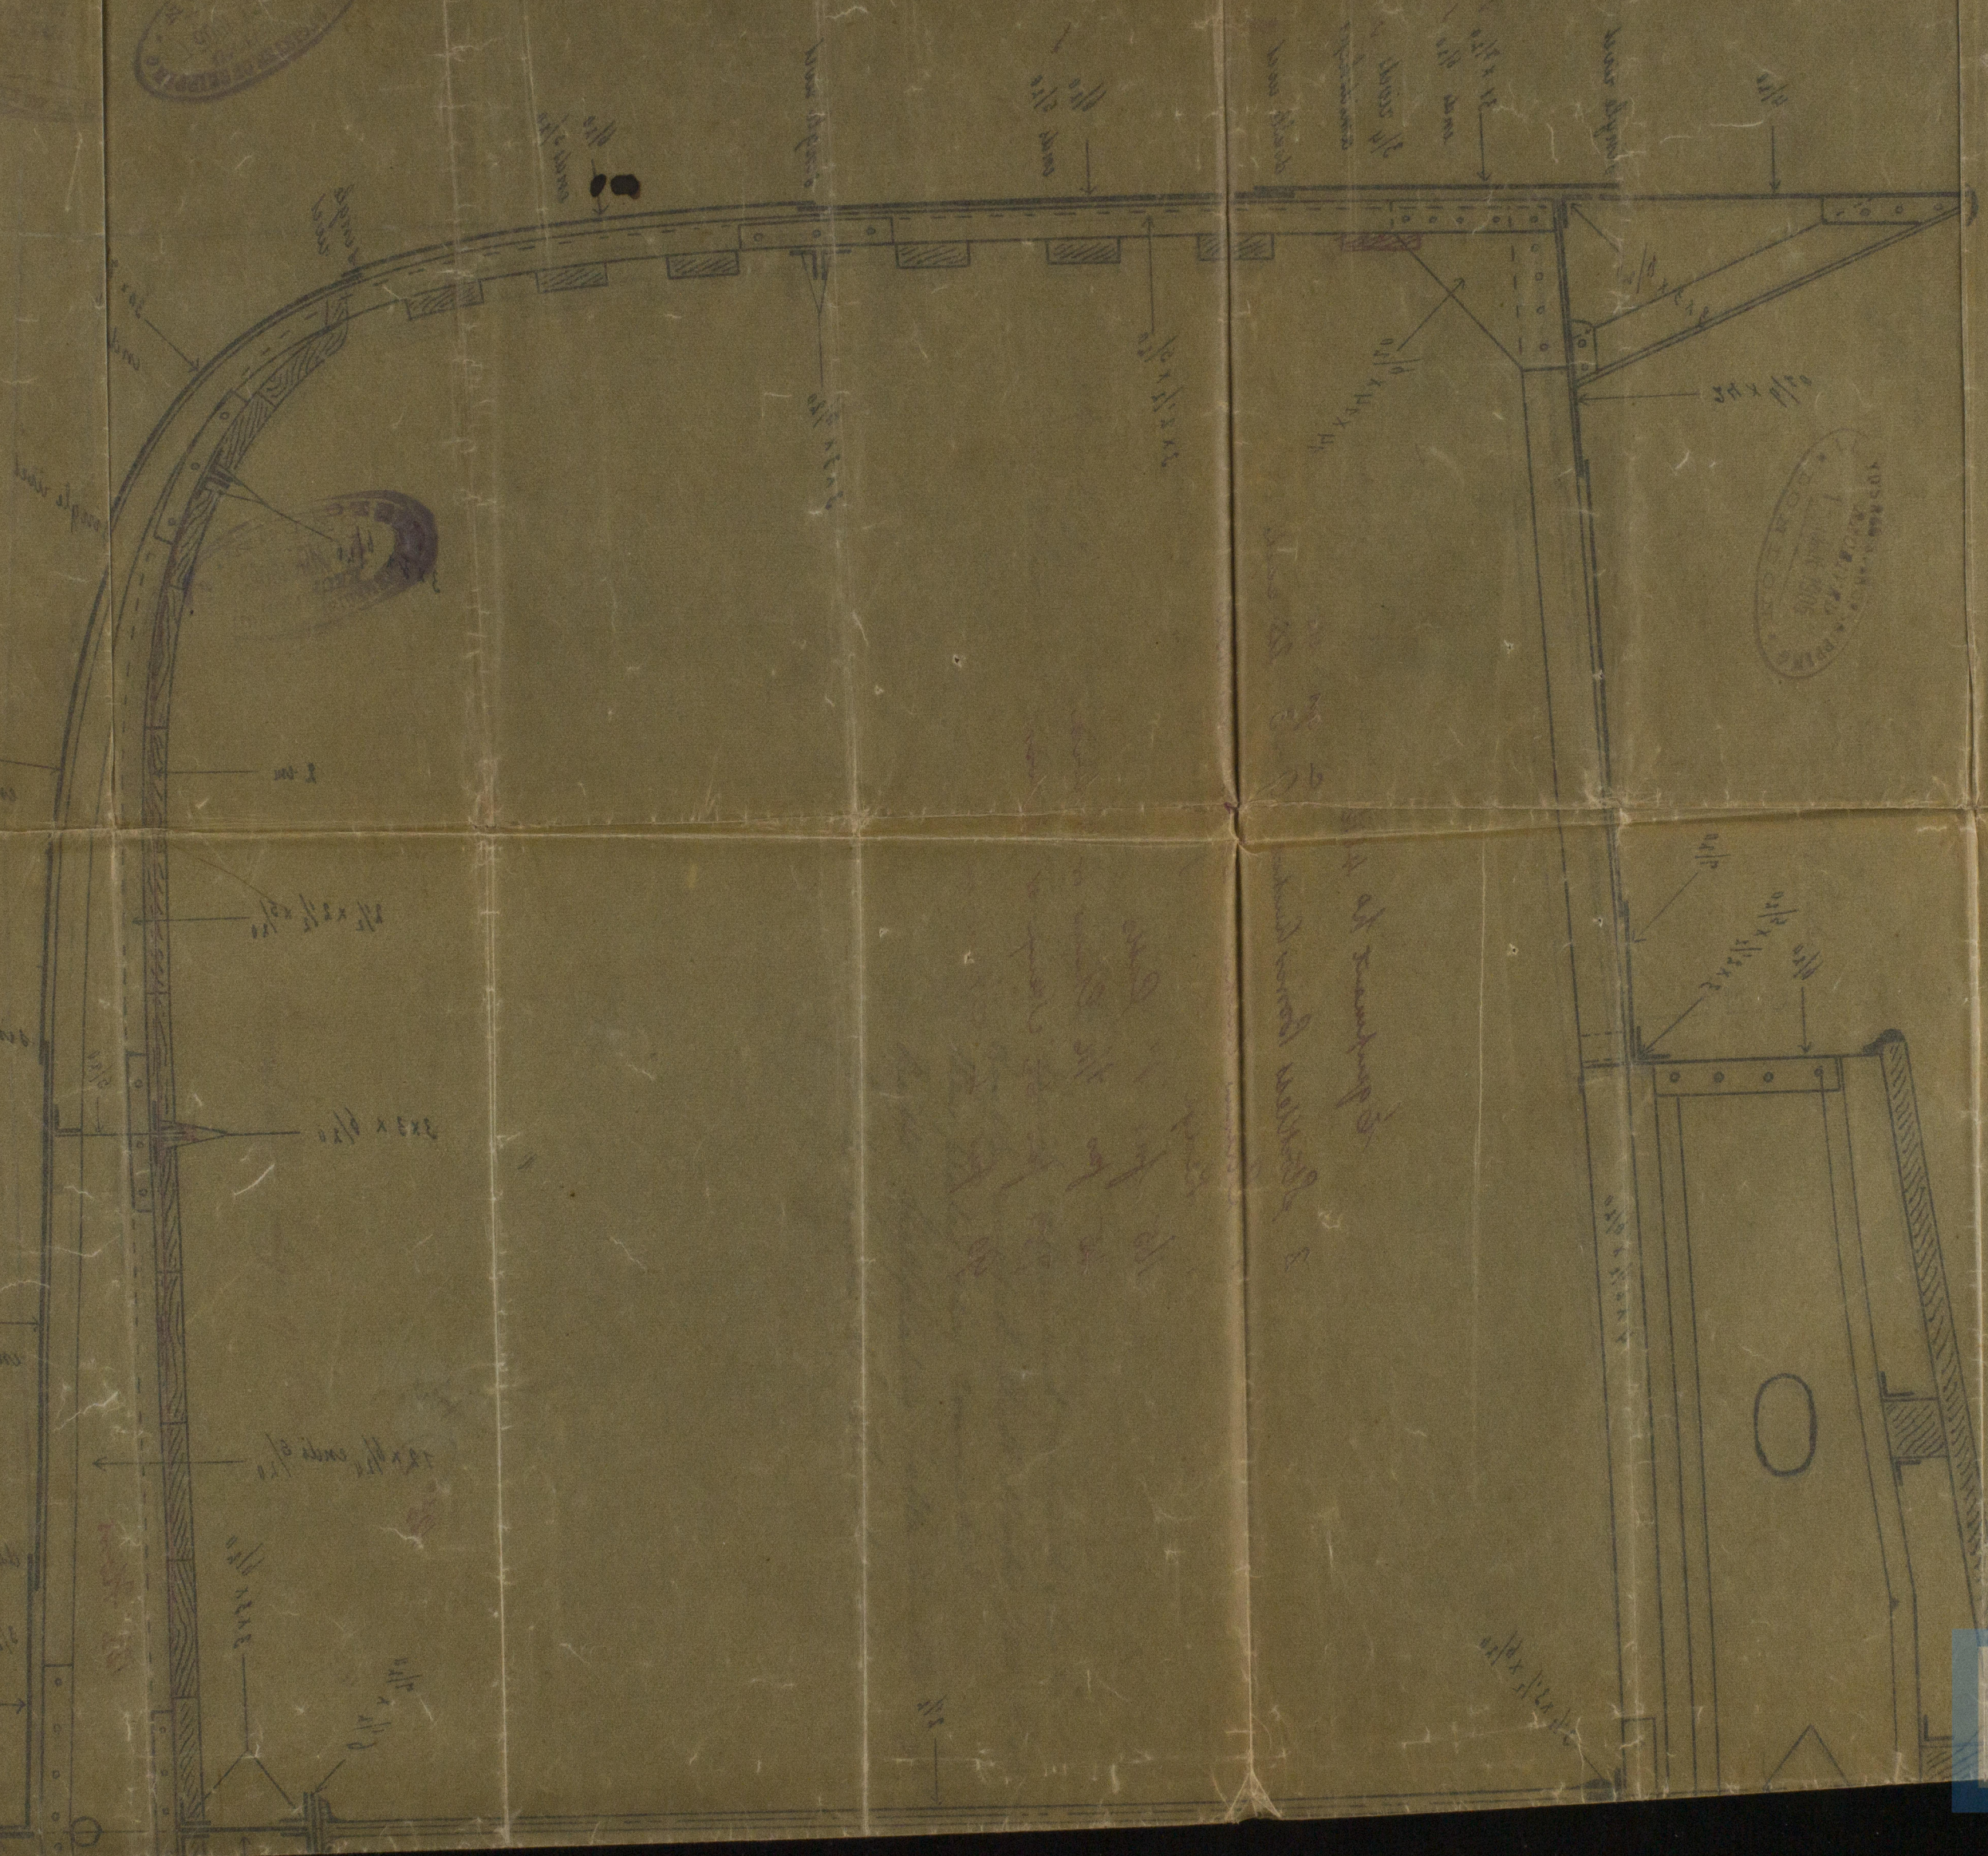

1/19/03
S. J.



© 2020
Lloyd's Register
Foundation