


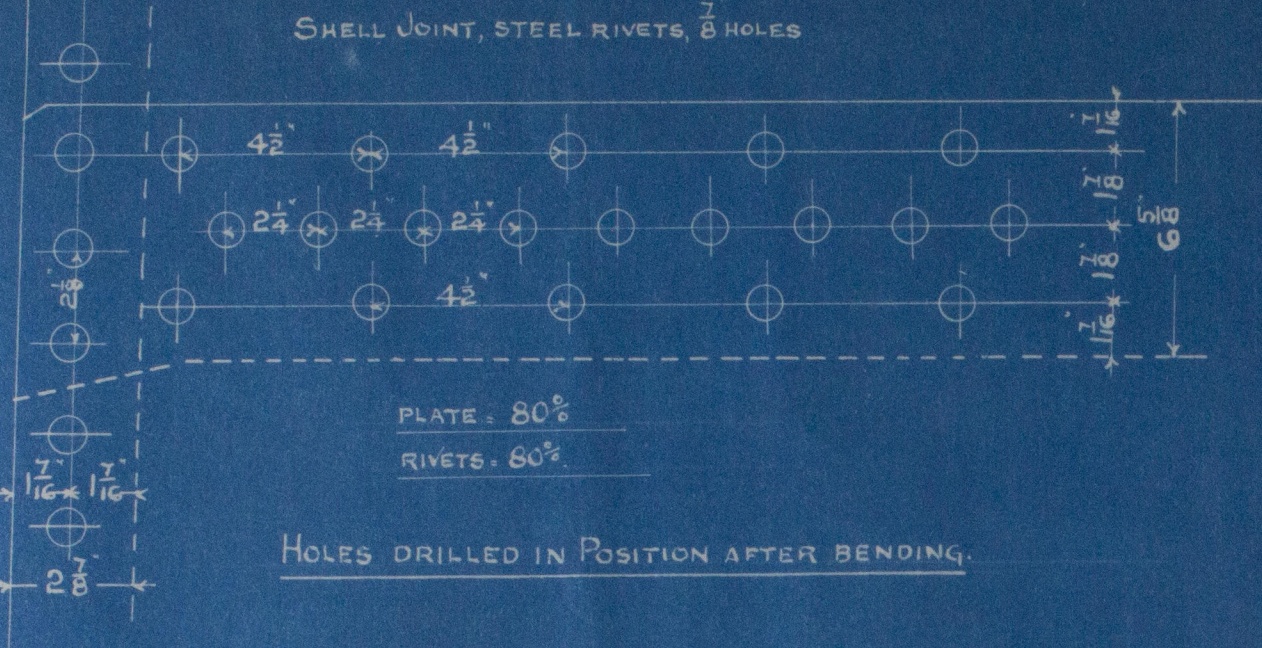

22:3:04

CIRC. SEAMS 16 HOLES, 28 PITCH, STEEL RIVETS



STEEL BOILER


SCALE 1" = 1 FOOT.

W.P. 90 LBS (LLOYDS)



FOR Messrs. Wapner & Son's No 409 4/8

ORDER NO 1891

HEATING SURFACE 765 1/2
GRATE AREA 26 1/2

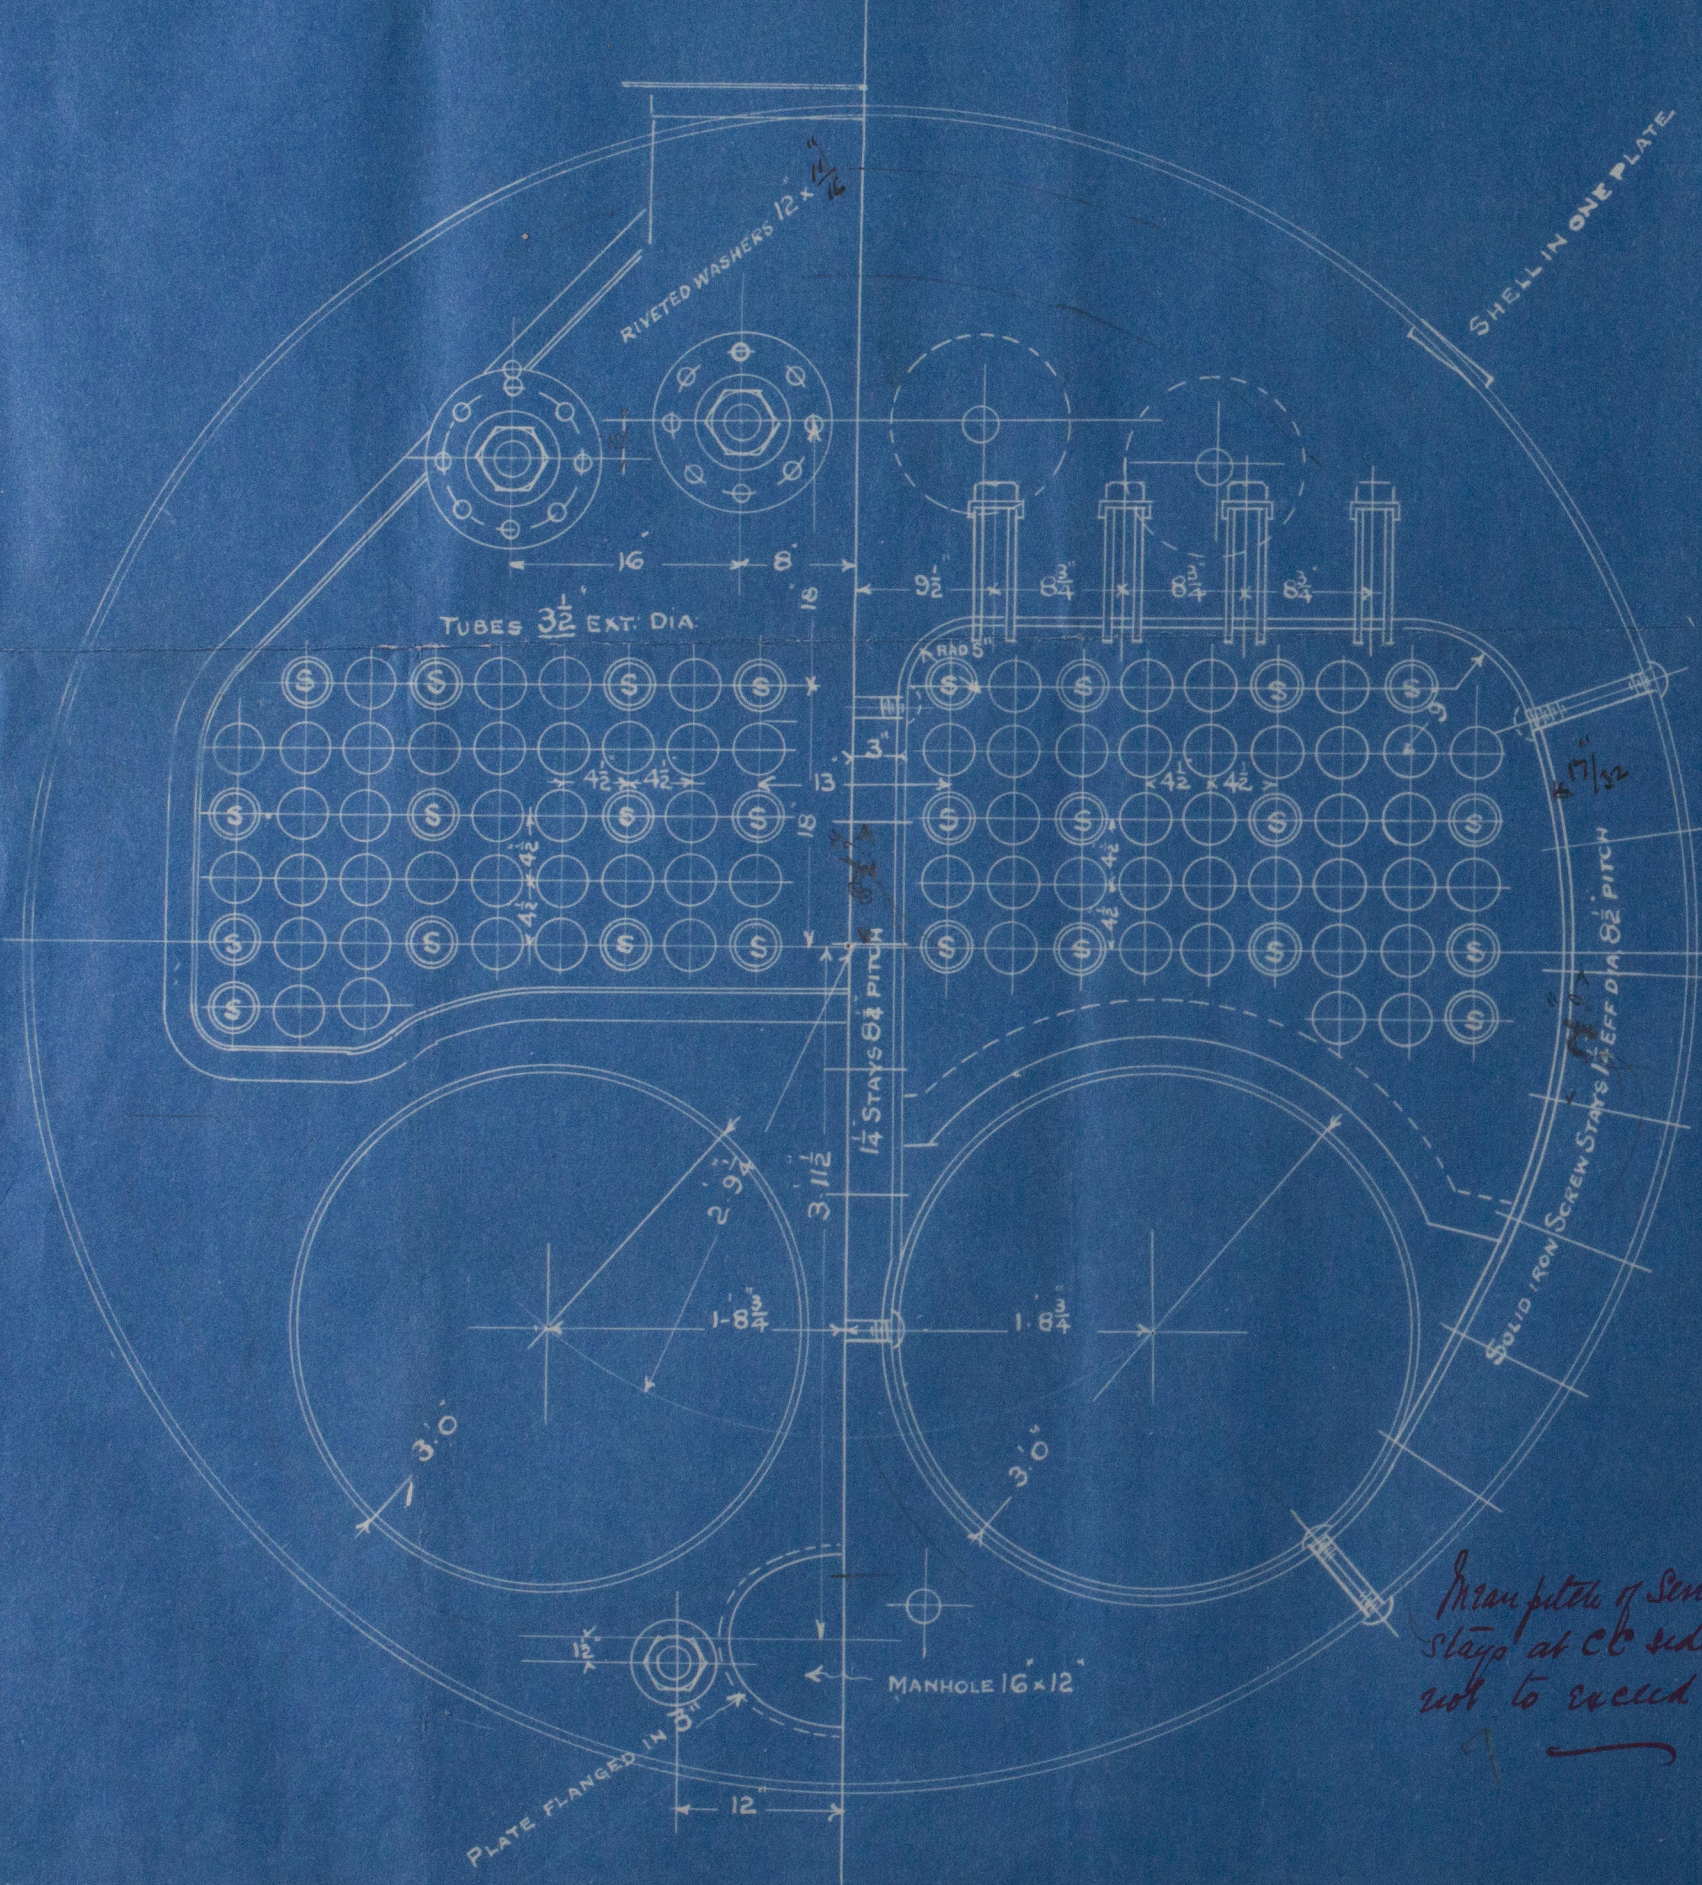

Mean pitch of screw stays at CB sides not to exceed 8.96"

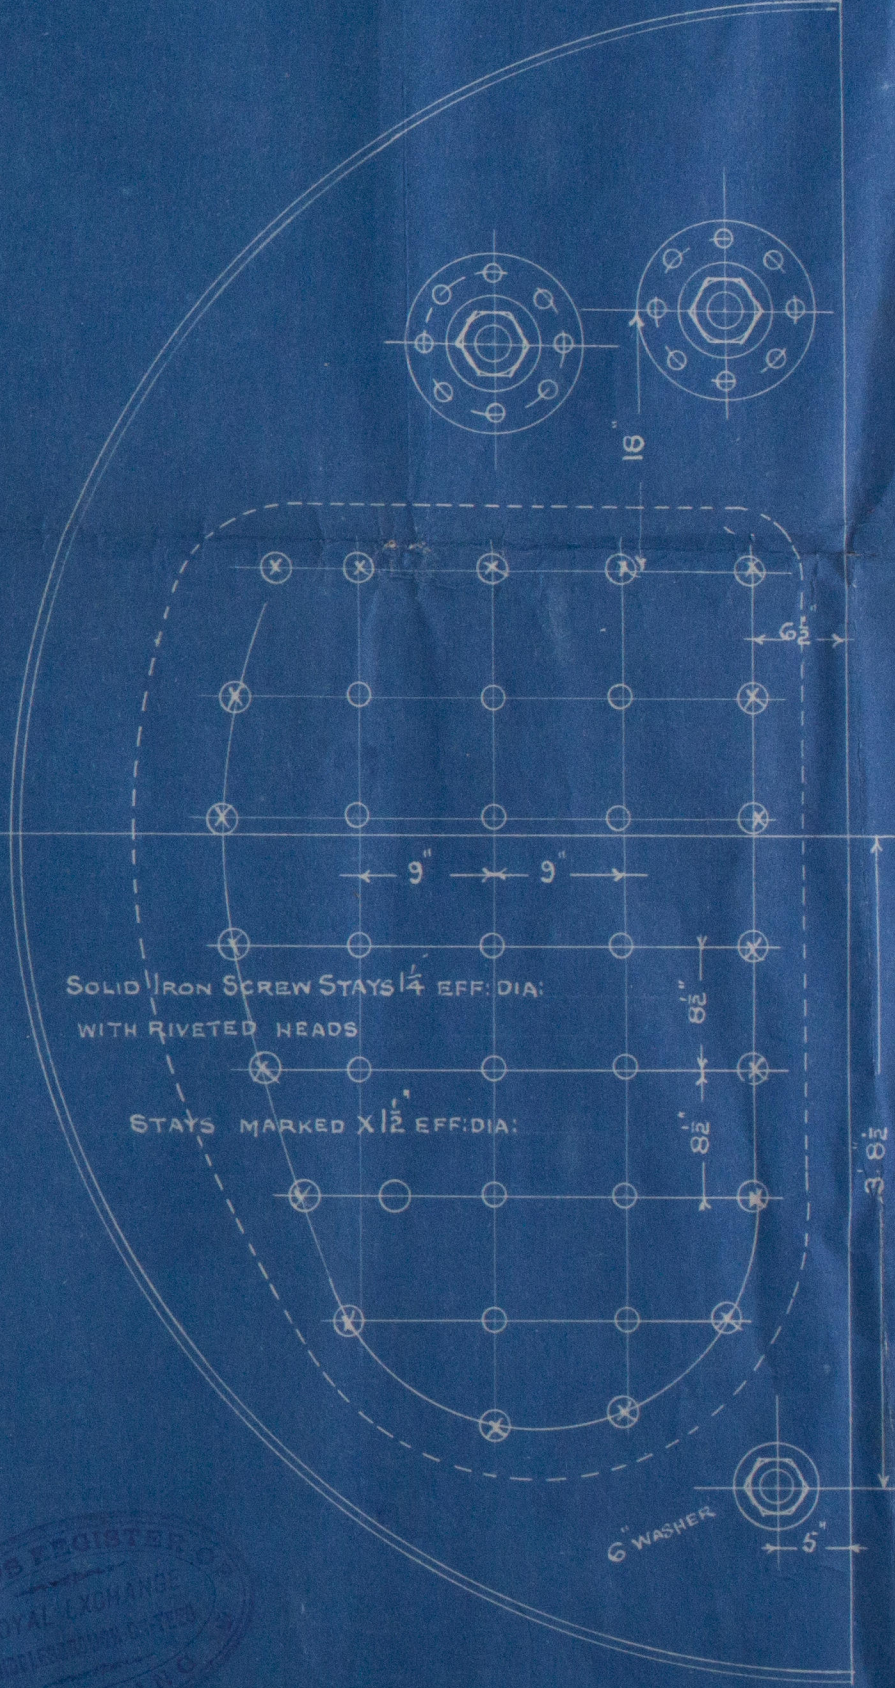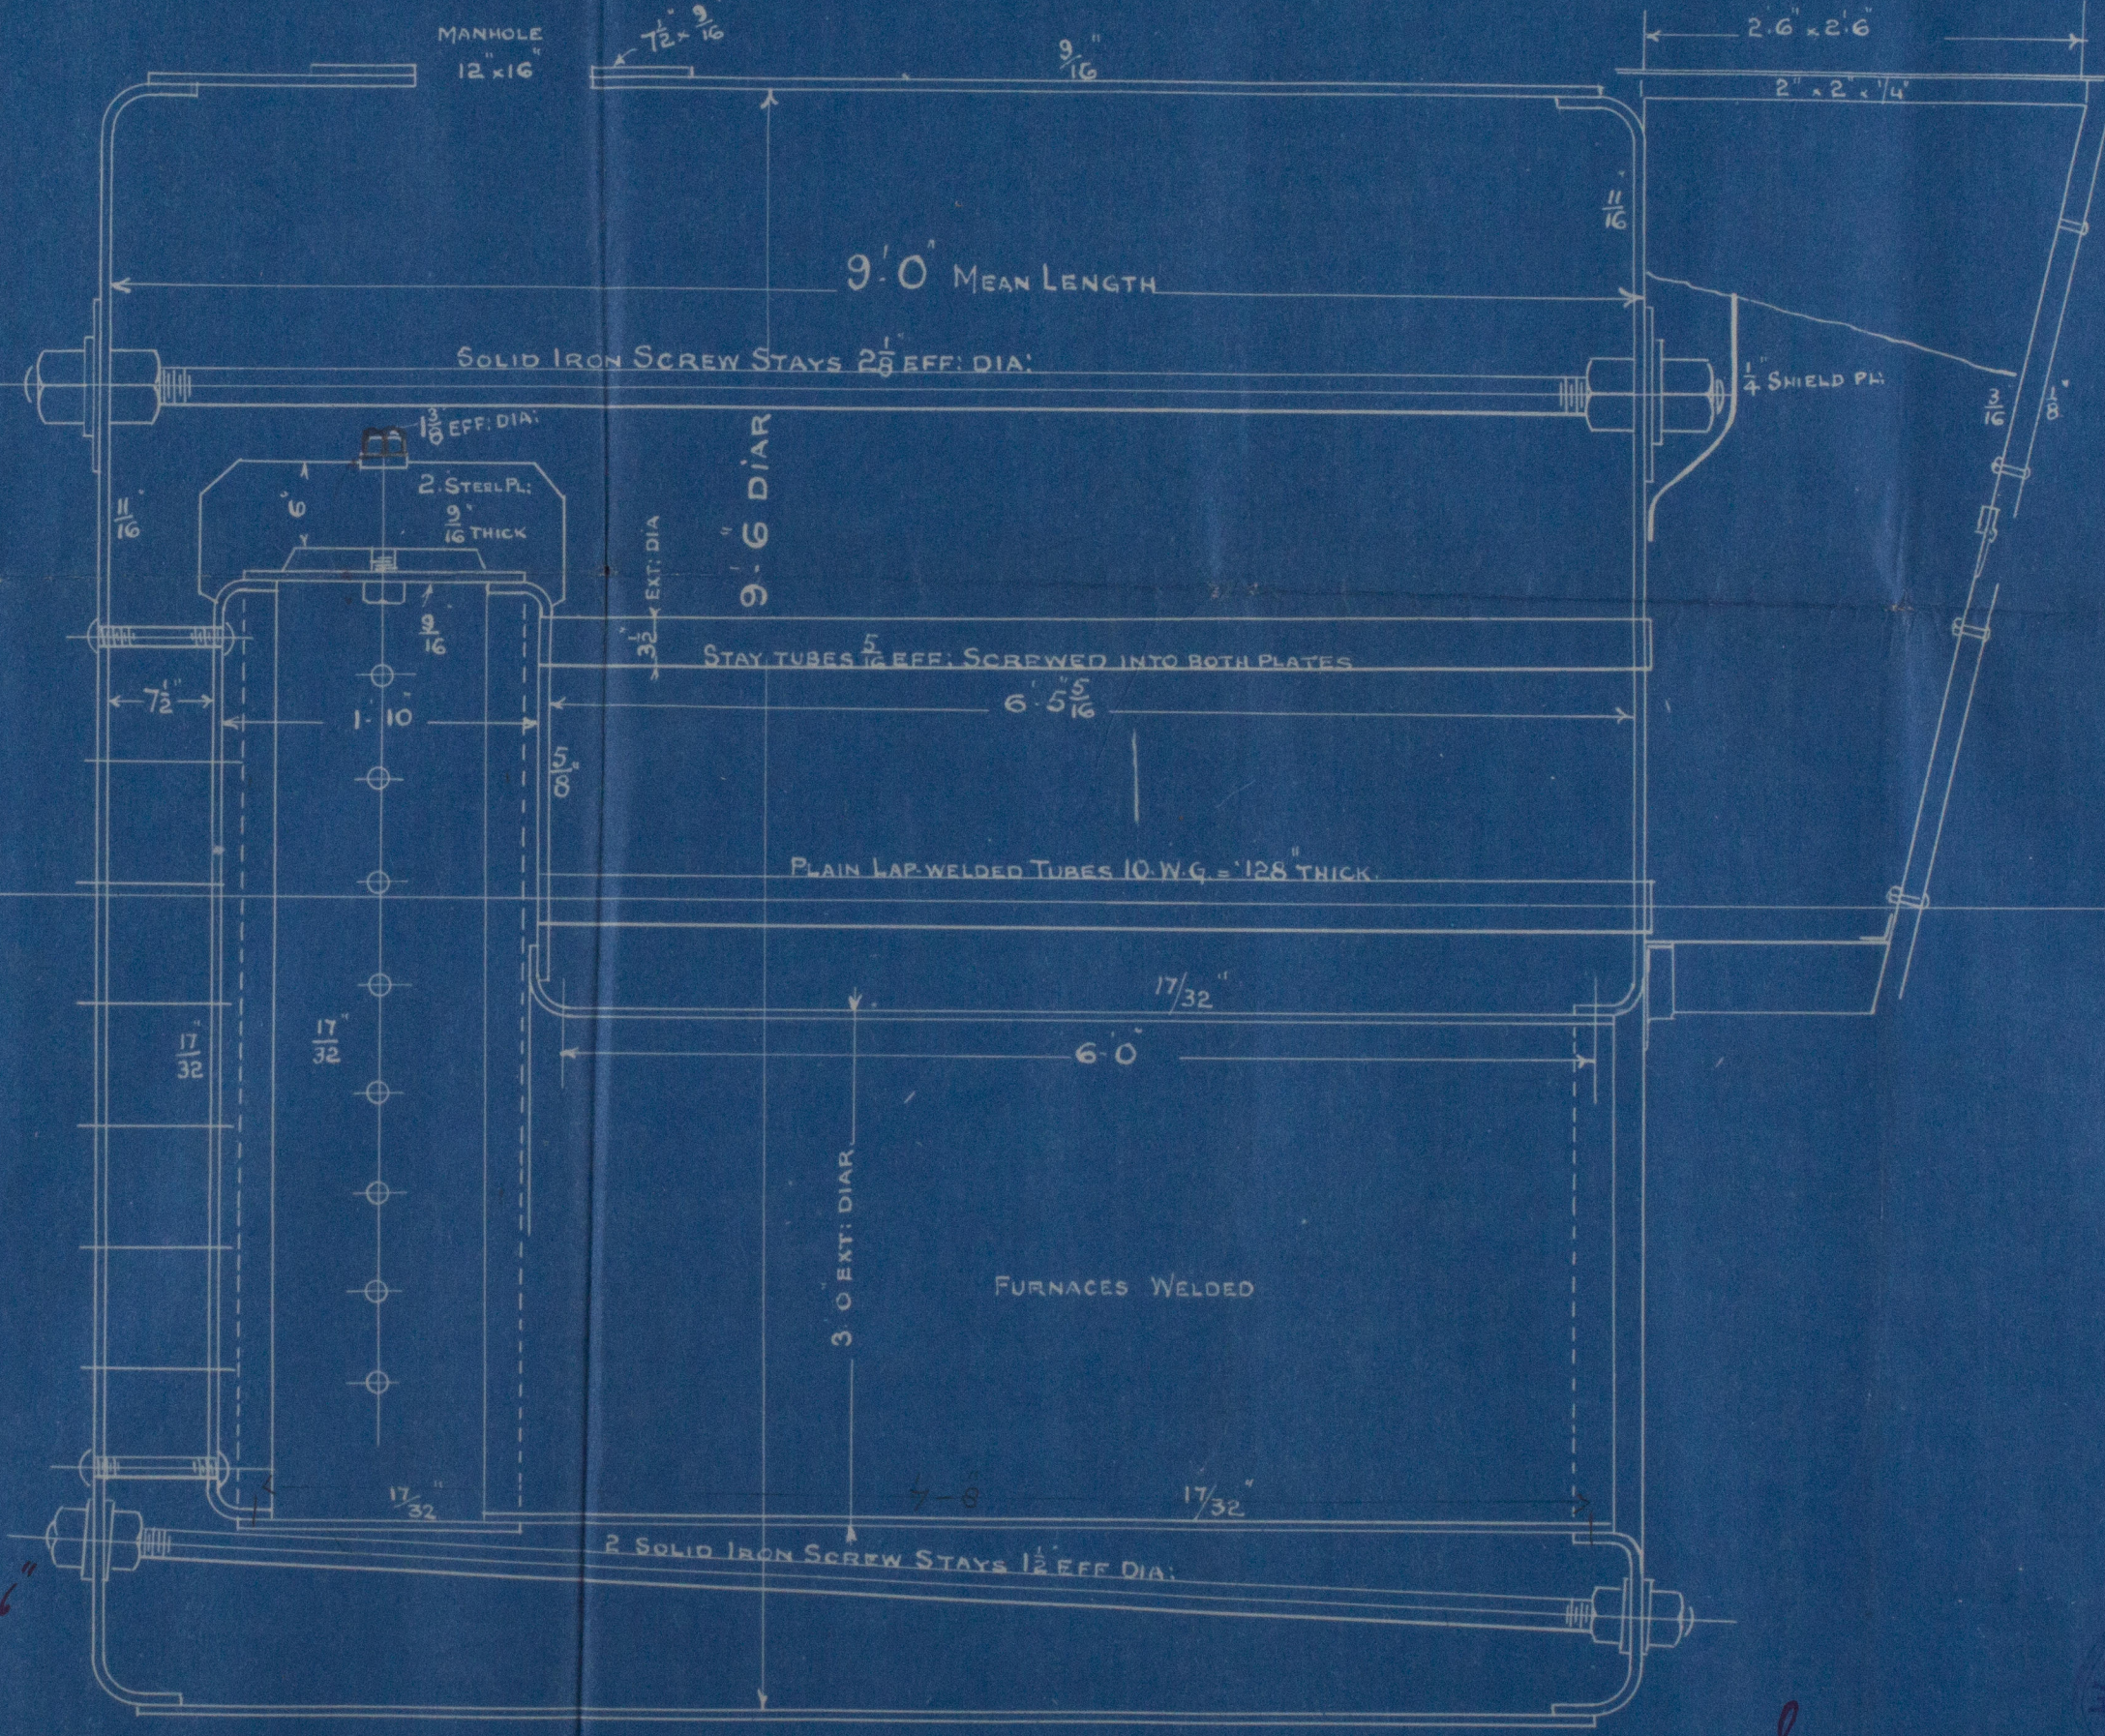

THOS. SUDBON & CO. L.D.
IMPERIAL BOILER WORKS
STOCKTON-ON-TEES

Reprints Log. Order 1891.

21.3.04

21.3.04

19.3.04

499-0093

J Sudron & Co^{ts}

1891

Mr. Napier & Son $\frac{2}{5}$ 409



aka 'Grantor'
Pub rpt no 2973

Filed 24/6/04

RECEIVED

RECEIVED



© 2020

Lloyd's Register
Foundation

W 999-0003