
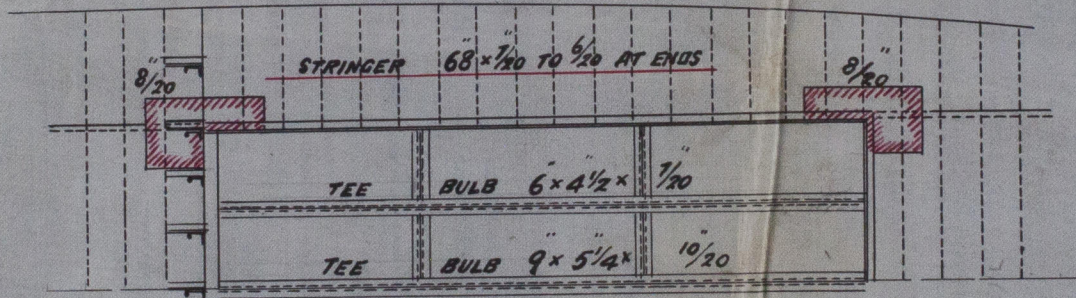


S. S. No. 103.

ALTERNATIVE SKETCH SHEWING ADDITIONAL
BRACKET IN LIEU OF ADDITIONAL $\frac{1}{20}$ ON
FRAMES IN WAY OF HATCHWAY.

SCALE $\frac{1}{8}'' = 1 \text{ FT.}$

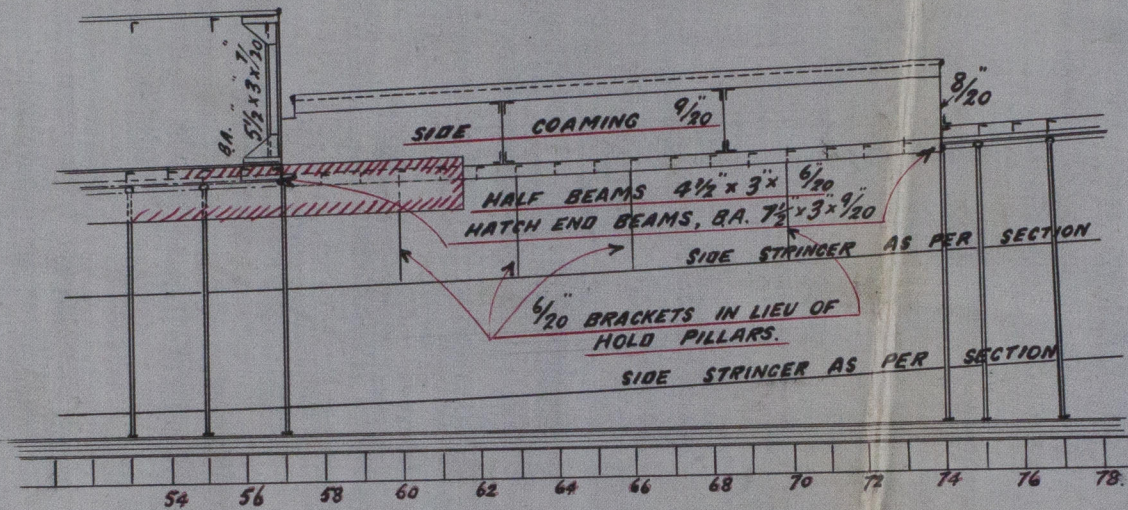

HATCHWAY 29'-9" x 14'-0"