



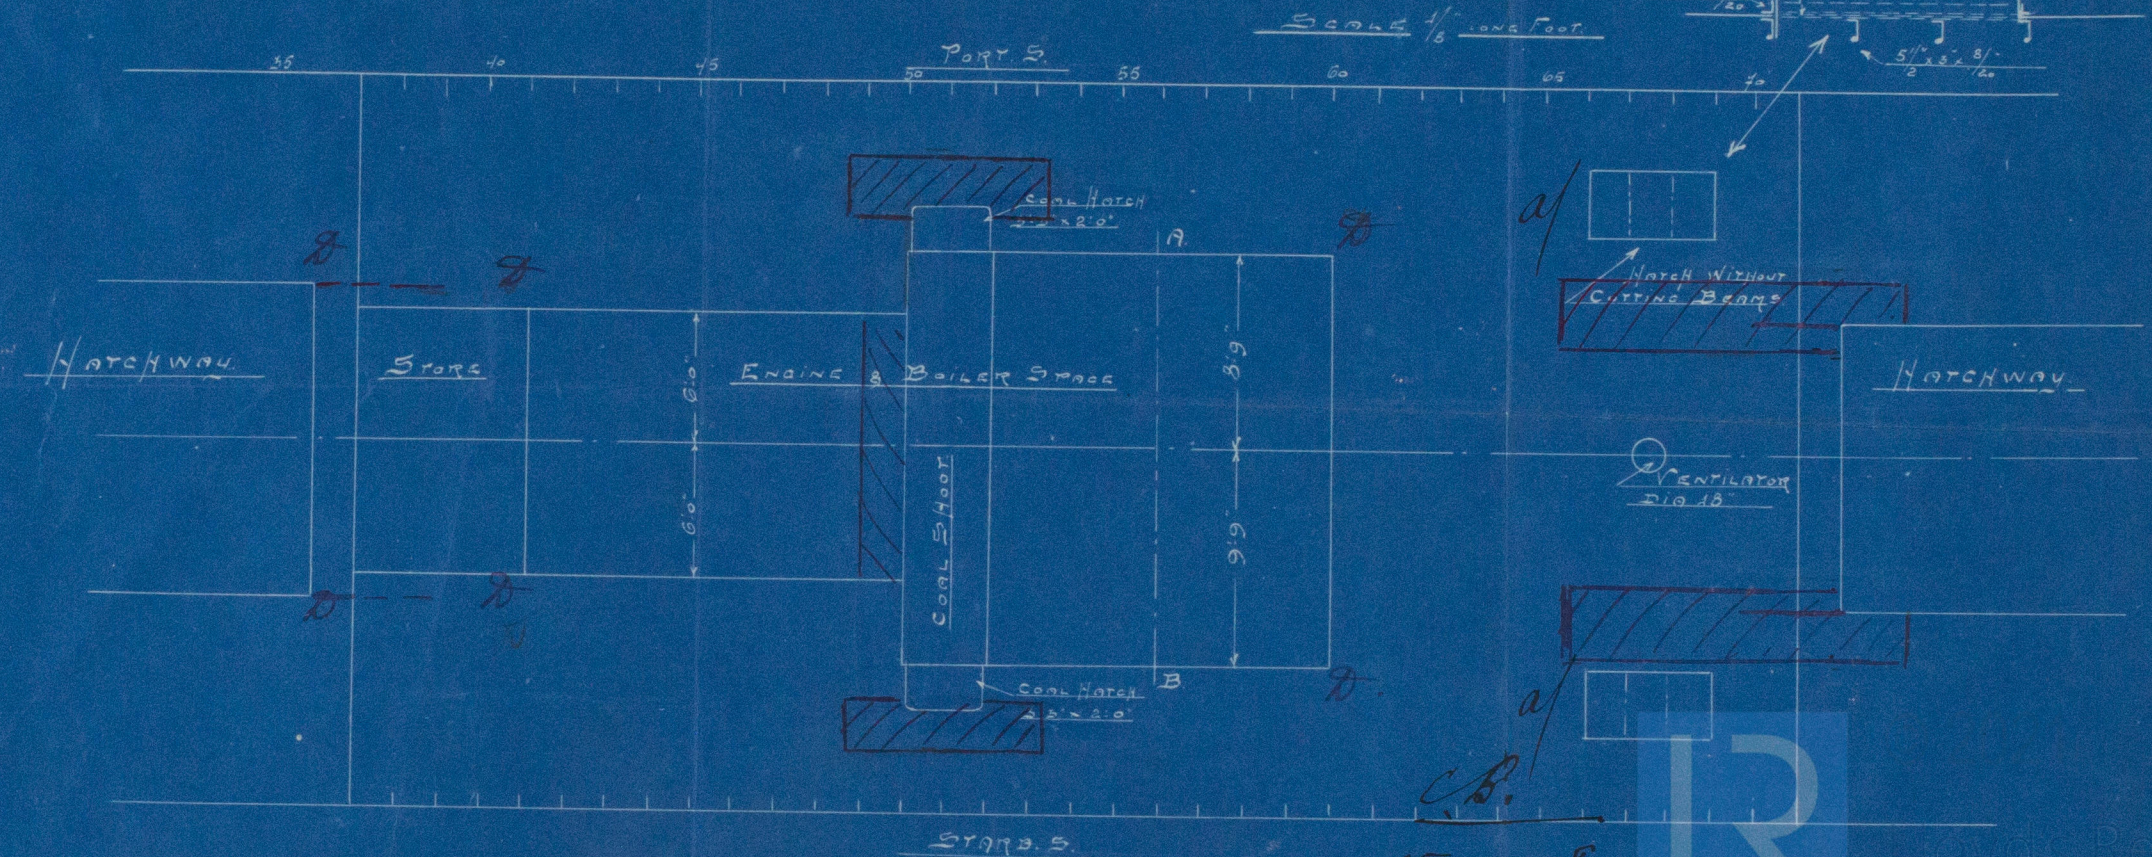

15.10.08.

SINGLE DECKED STEEL SCREW STEAMER N° 200


MIDDECK ABOVE ENGINE & BOILER SPACE

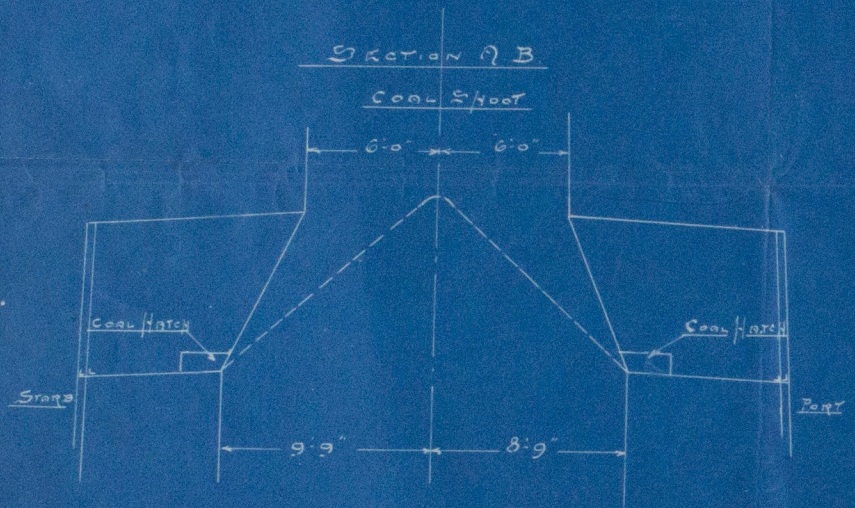

C.B.
15.10.08

J. MEYER'S SHIPBUILDING COMPANY
ROTHENBURG
AMSTERDAM


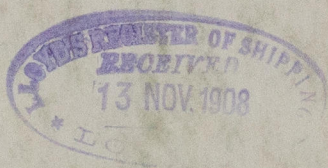

© 2021

Lloyd's Register
Foundation

W940-0059